



10-26-04
NEED PROPOSED PLAN OF PERC ARE A^d
Surrounding wells, topo, etc (KN)

APPLICATION

FOR PERCOLATION TESTING AND SITE EVALUATION

TEST DATE(S) _____ TEST TIME _____ **AP 521544**
AGENCY REVIEW: Fee waived DATE 10/18/2004
TAX ID # 04313372

DO NOT WRITE ABOVE THIS LINE

I HEREBY APPLY FOR THE NECESSARY TESTING/EVALUATION PRIOR TO ISSUANCE OF SEWAGE DISPOSAL SYSTEM PERMIT(S) TO:

CHECK AS NEEDED:

- CONSTRUCT NEW SEPTIC SYSTEM(S)
- REPAIR/ADD TO AN EXISTING SEPTIC SYSTEM
- REPLACE AN EXISTING SEPTIC SYSTEM

CHECK AS NEEDED:

- NEW STRUCTURE(S)
- ADDITION TO AN EXISTING STRUCTURE
- REPLACE AN EXISTING STRUCTURE

CHECK ONE:

- CREATE NEW LOT(S)
- BUILD ON AN EXISTING LOT IN A SUBDIVISION
- BUILD ON AN EXISTING PARCEL OF RECORD

IS THE PROPERTY WITHIN 2500' OF ANY RESERVOIR?

- YES
- NO

THE TYPE OF STRUCTURE IS:

- RESIDENTIAL WITH unknown PROPOSED BEDROOMS IN THE COMPLETED STRUCTURE (NOTE **UNKNOWN** IF APPROPRIATE)
- COMMERCIAL (PROVIDE DETAIL OF NUMBERS AND TYPES OF EMPLOYEES/ CUSTOMERS ON ACCOMPANYING PLAN)
- INSTITUTIONAL/GOVERNMENT (PROVIDE DETAIL OF NUMBERS AND TYPES OF EMPLOYEES/USERS ON ACCOMPANYING PLAN)

PROPERTY OWNER(S) Doris Donaldson

DAYTIME PHONE 410 442 2593 - also fm CELL _____ FAX _____

MAILING ADDRESS 2239 DuVall Rd Woodbine MD 21797
STREET CITY/TOWN STATE ZIP

APPLICANT same

DAYTIME PHONE same CELL _____ FAX _____

MAILING ADDRESS same _____
STREET CITY/TOWN STATE ZIP

APPLICANT'S ROLE: DEVELOPER BUILDER BUYER RELATIVE/FRIEND REALTOR CONSULTANT

PROPERTY LOCATION
SUBDIVISION/PROPERTY NAME 2215 DuVall Rd LOT NO. _____

PROPERTY ADDRESS 2215 DuVall Rd Woodbine MD
STREET TOWN/POST OFFICE

TAX MAP PAGE(S) _____ GRID _____ PARCEL(S) _____ PROPOSED LOT SIZE 1 acre

AS APPLICANT, I UNDERSTAND THE FOLLOWING: THE SYSTEM INSTALLED SUBSEQUENT TO THIS APPLICATION IS ACCEPTABLE ONLY UNTIL PUBLIC SEWERAGE IS AVAILABLE. THIS APPLICATION IS COMPLETE WHEN ALL APPLICABLE FEES AND A SUITABLE SITE PLAN HAVE BEEN RECEIVED. I ACCEPT THE RESPONSIBILITY FOR COMPLIANCE WITH ALL M.O.S.H.A. AND "MISS UTILITY" REQUIREMENTS. APPROVAL IS BASED UPON SATISFACTORY REVIEW OF A PERC CERTIFICATION PLAN.

TEST RESULTS WILL BE MAILED TO APPLICANT. [Signature]
SIGNATURE OF APPLICANT

HOWARD COUNTY HEALTH DEPARTMENT, BUREAU OF ENVIRONMENTAL HEALTH, WELL AND SEPTIC PROGRAM
3525-H ELLICOTT MILLS DRIVE, ELLICOTT CITY, MARYLAND 21043-4544 (410) 313-1771 FAX (410) 313-2648
TDD (410) 313-2323 TOLL FREE 1-877-4MD-DHMH

APV (A)


Str brn
tan loam
S, SL
root mat 2'
bik/sbk
2'
4mm 3pl
tan sl. Loam
chert frags 200%
4-4 1/2
4brn
Loam s.g.
w/packets
v.f. SL
TRACE Rx
Bottom
11'

(B)

DK Str brn Loam
Sbk, roots common
Rx 50% to 2'
2'-3'
6mm 3pl
org brn, 4brn
SiL
chert 200%
6'
Str org
7'
w/ pocket
grtz frags
Stony
Str org
SiL
Friable, loose
Rx 100%
Bottom
11'

(D)

Str brn
nyll-
CL
small sbk peds 3'
TRANSITION
ZONE
Str yellow, tan
brn SiL w/packets of cl
5'
yellow
s.g.
Loam
11'

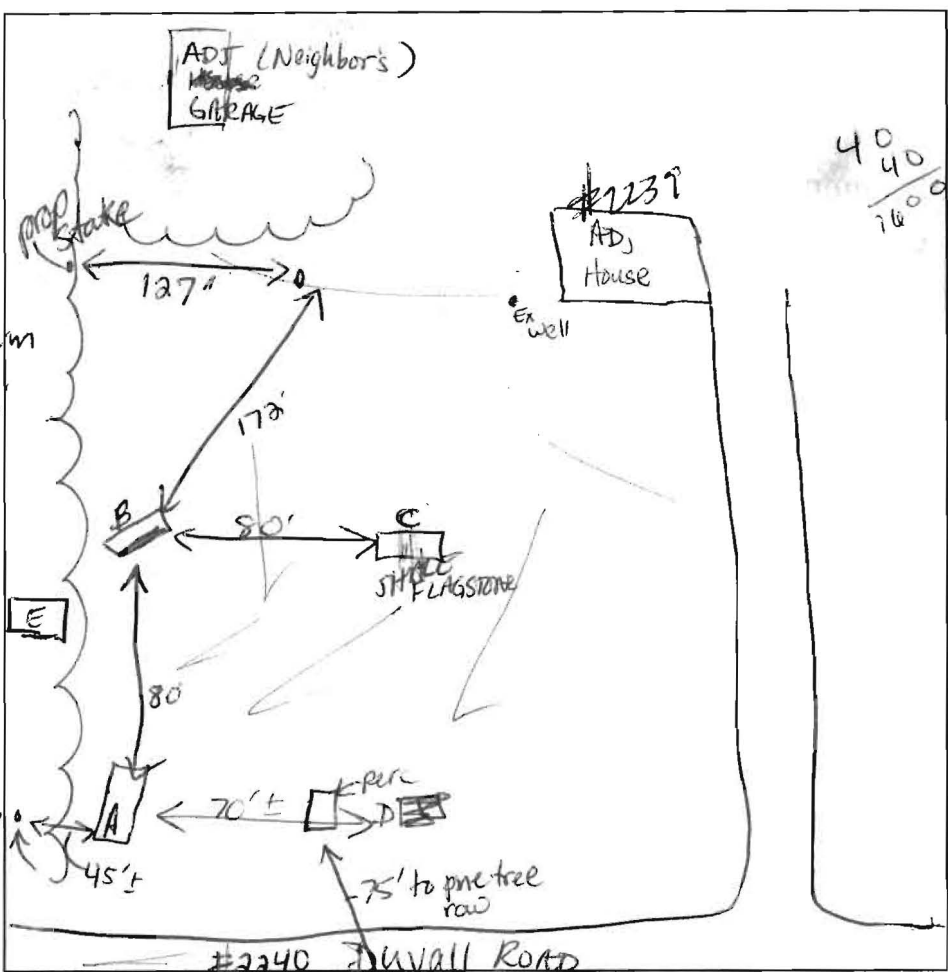


(E)
w/ tal,
w/ org,
brn
L
4 1/2
5
V. loose
fine,
Loam
Trace
rock
11'

DATE	TEST #	DEPTH	START	BREAK 1" DROP	STOP 2" DROP	TIME OF 2nd INCH	P/F/H	
11-9-04	(A)	4 1/2	12:20	12:25	12:32	7	P	
	(B)	4 1/2	12:33	12:41	1:01	20	P	
	(C)	Refusal @ 5'	50% S+MRE		AT 3'		F	
TESTING IN TX ZONE	(D)	5'10"	1:03	1:08	1:13	5min	P	
	(E)	VISUAL						OK
	(About 115')	well further SW of perc hole (D) >100' FROM PERCHOLE D TO WELL #2240						
		SiL-L soils, low Rx % SHALE						

REMARKS Gentle Slopes
SANITARIAN Kaci BACKHOE Herman SirkOTHERS owner
TEST HOLES USED IN SDA ALL BUT (C) AVG. PERC TIME 15 SQ. FT/BR 210
TRENCH WIDTH 3 INLET DEPTH 4 MAX. BOT DEPTH 7 EFFECTIVE SW 3

3'-6'
TRANS ZONE

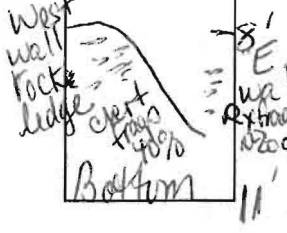

FILE INQUIRY FORM

Property Address: 2215 Duvall Rd

10/12/04 - Spoke to Doris Donaldson (410)
442-2593 by phone about having this
lot retested (\$506) J.R. indicated to
me we would then establish 10,000 \$
S.R.A. Need to check adj wells &
septic locations (50)