

0749  
 (SEQ. NO.)  
 DATE RECEIVED (WRA USE ONLY)  
 DATE WELL COMPLETED 11/21/74  
 8-13

STATE OF MARYLAND  
 WATER RESOURCES ADMINISTRATION  
 TAWES STATE OFFICE BLDG., ANNAPOLIS, MD. 21401  
 WELL COMPLETION REPORT

THIS REPORT MUST BE SUBMITTED WITHIN 30 DAYS AFTER WELL COMPLETION  
 FILL IN THIS FORM COMPLETELY  
 COUNTY NUMBER 20662  
 PERMIT NO. FROM "PERMIT TO DRILL WELL" 73-0-61  
 28 29 30 31 32 33 34 35 36 37  
 DRILLERS IDENTIFICATION NO. 41

OWNER Donaldson Francis  
 LAST NAME FIRST NAME  
 STREET OR RFD POST OFFICE Woodbine Md.

WELL LOG

STATE THE KIND OF FORMATIONS PENETRATED, THEIR COLOR, DEPTH, THICKNESS AND IF WATER BEARING

DESCRIPTION (USE ADDITIONAL SHEETS IF NECESSARY)	FEET		CHECK IF WATER BEARING
	FROM	TO	
Top Soil	0	2	
MALE	2	20	
SHALE	20	37	
Blue Shale	37	80	✓
Blue Slate	80	145	

64' casing  
 30' grout  
 14 log C  
 OK CBB  
 11-25-74

WELL DESCRIPTION

GROUTING RECORD

WELL HAS BEEN GROUTED (CIRCLE APPROPRIATE BOX)  
 YES  NO

TYPE OF GROUTING MATERIAL (CIRCLE BOX)  
 CEMENT  BENTONITE CLAY

NO. OF BAGS 14 NO. OF POUNDS 1100  
 GALLONS OF WATER 75  
 DEPTH OF GROUT SEAL (TO NEAREST FOOT)  
 FROM 0 FT. TO 45 FT.

CASING RECORD

CASING TYPES (INSERT APPROPRIATE CODE BELOW)  
 S STEEL  C CONCRETE  
 P PLASTIC  O OTHER

MAIN CASING TYPE  
 S 1  6  
 NOMINAL DIAMETER TOP (MAIN/CASING) (NEAREST INCH)  
 TOTAL DEPTH OF MAIN CASING (NEAREST FOOT)  
 64

OTHER CASING (IF USED)  
 DIAMETER (INCH) DEPTH (FEET) FROM TO

SCREEN RECORD

SCREEN TYPE OR OPEN HOLE (INSERT APPROPRIATE CODE BELOW)  
 S STEEL  B BRASS OR BRONZE  H OPEN HOLE  
 P PLASTIC  O OTHER

DEPTH NEAREST WHOLE FOOT  
 FROM 62 TO 175  
 EACH SCREEN  
 1 2 3  
 8 9 11 15 17 21  
 23 24 26 30 32 36  
 38 39 41 45 47 51  
 SLOT SIZE 1. 2.

DIAMETER OF SCREEN 50 NEAREST INCH  
 GRAVEL PACK  
 IF WELL DRILLED WAS A FLOWING WELL (CIRCLE BOX)  F

WRA USE ONLY (NOT TO BE FILLED IN BY DRILLER)  
 T (E.P.O.S.)  W O  
 70 72 74 75 76  
 TELESCOPE CASING LOG INDICATOR OTHER DATA AVAILABLE

PUMPING TEST

HOURS PUMPED (TO NEAREST HOUR) 1  
 PUMPING RATE (GALLONS PER MINUTE TO NEAREST GALLON) 15  
 METHOD USED TO MEASURE PUMPING RATE Bucket  
 WATER LEVEL (DISTANCE FROM LAND SURFACE)  
 BEFORE PUMPING 45 (NEAREST FOOT)  
 WHEN PUMPING 145 (NEAREST FOOT)  
 TYPE OF PUMPED USED (CIRCLE APPROPRIATE BOX) (FOR PUMPING TEST)  
 A AIR  P PISTON  T TURBINE  
 C CENTRIFUGAL  R ROTARY  O OTHER (DESCRIBE BELOW)  
 J JET  S SUBMERSIBLE

PUMP INSTALLED

TYPE OF PUMP (WRITE APPROPRIATE LETTER IN BOX - SEE ABOVE: A, C, J, P, R, S, T, O)  
 29  
 DRILLER WILL INSTALL PUMP (CIRCLE APPROPRIATE BOX)  
 YES  NO  
 CAPACITY:  
 GALLONS PER MINUTE (TO NEAREST GALLON) 31 35  
 PUMP HORSE POWER 37 41  
 PUMP COLUMN LENGTH (NEAREST FOOT) 43 47  
 CASING HEIGHT (CIRCLE APPROPRIATE BOX AND ENTER CASING HEIGHT)  
 ABOVE } LAND SURFACE  
 BELOW } 2 (NEAREST FOOT)


LOCATION OF WELL ON LOT  
 SHOW PERMANENT STRUCTURE SUCH AS BUILDINGS, SEPTIC TANKS, AND/OR OTHER LAND MARKS AND INDICATE NOT LESS THAN TWO DISTANCES (MEASUREMENTS TO WELL).

CIRCLE APPROPRIATE BOXES

A WELL WAS ABANDONED AND SEALED WHEN THIS WELL WAS COMPLETED  
 E ELECTRIC LOG OBTAINED  
 P TEST WELL CONVERTED TO PRODUCTION WELL

I HEREBY CERTIFY THAT I HAVE COMPLIED WITH ALL CONDITIONS STATED ON THE ABOVE-CAPTIONED "PERMIT TO DRILL WELL", AND THAT INFORMATION CONTAINED IN THIS REPORT IS TRUE, ACCURATE, AND COMPLETE TO THE BEST OF MY KNOWLEDGE, INFORMATION AND BELIEF.

DRILLERS NAME  
 SIGNATURE  
 TELEPHONE

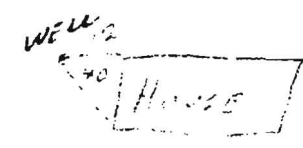

Adi