

LAYOUT 2/24/05 11am INSP 4 _____
 INSP 2 3/11/05 - 10 AM INSP 5 _____
 INSP 3 _____ INSP 6 _____

ISSUE DATE: 2/10/05
 APPROVAL DATE: 3/11/05

PERMIT
INDEXED
 TAX ID #05-435382

P 521984-B
 A 513574-M

ON-SITE SEWAGE DISPOSAL SYSTEM
HOWARD COUNTY HEALTH DEPARTMENT
BUREAU OF ENVIRONMENTAL HEALTH

Fogle's Septic Clean, Inc. IS PERMITTED TO INSTALL ALTER

ADDRESS: 580 Obrecht Rd., Sykesville PHONE NUMBER: 410-795-5670

SUBDIVISION: Pindell Woods LOT NUMBER: 13

ADDRESS: 7241 Preservation Court PROPERTY OWNER: Mount View, LLC

SEPTIC TANK CAPACITY (GALLONS): 1500 OUTLET BAFFLE FILTER REQUIRED


PUMP CHAMBER CAPACITY (GALLONS): N/A COMPARTMENTED TANK REQUIRED

NUMBER OF BEDROOMS: 5

SQUARE FEET PER BEDROOM: 180 $\frac{5 \times 180}{3} \times .62 = 186'$

LINEAR FEET OF TRENCH REQUIRED: 240 186' HOUSE SERVED BY PUBLIC WATER

TRENCHES:	Trench to be 3.0 feet wide. Inlet 4.0 feet below original grade. Bottom maximum depth 6.0 feet below original grade. Effective area begins at 4.0 feet below original grade. 2.0 feet of stone below distribution pipe.
LOCATION:	Place the distribution box as shown on the approved building permit plan. Utilizing SDA efficiently, run 3-90' trenches.
NOTES:	Ensure 1-2% slope from house to septic tank.

PLANS APPROVED: Kacie Noonan Reviewed by:  DATE: 9/27/04

NOTES: PERMIT VOID AFTER 2 YEARS
 CONTRACTOR IS RESPONSIBLE FOR SCHEDULING A PRE-CONSTRUCTION INSPECTION FOR ALL INSTALLATIONS
 WATERTIGHT SEPTIC TANKS REQUIRED
 ALL PARTS OF SEPTIC SYSTEM SHALL BE 100 FEET FROM ANY WATER WELL UNLESS SPECIFICALLY AUTHORIZED
 MANHOLE RISERS REQUIRED ON ALL SEPTIC TANKS AND PUMP CHAMBERS UNLESS SPECIFICALLY AUTHORIZED
 CONTRACTOR RESPONSIBLE FOR COMPLIANCE WITH APPLICABLE REGULATIONS, GUIDELINES AND THE TERMS OF THIS PERMIT


NEITHER THE HOWARD COUNTY COUNCIL NOR THE HEALTH DEPARTMENT IS RESPONSIBLE FOR THE SUCCESSFUL OPERATION OF ANY SYSTEM PERMITTEE RESPONSIBLE FOR OBTAINING FINAL APPROVAL ON THIS PERMIT

BUILDING PERMIT SIGNED AND RETURNED 410-313-2640 FOR INSPECTION OF SEPTIC SYSTEM

7-14-05 800 154973 - I6 POOL
 1/4/05 800 150327 - ADDITION
 6/13/06 800 160013 - SHED

P-513574-M

NOT TO SCALE

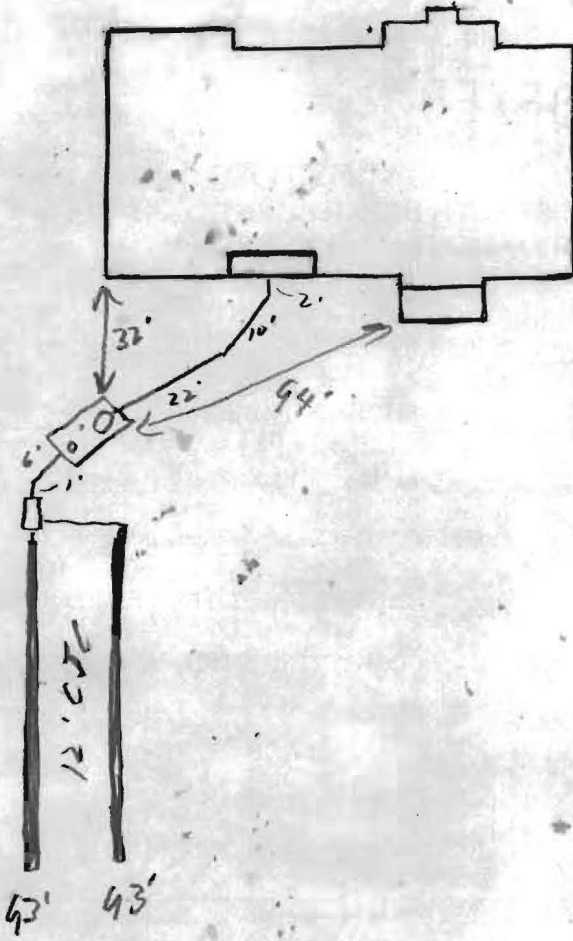

TRENCH/DRAINFIELD DATA		
WIDTH	INLET	BOTTOM
3'	4'	6'
NUMBER OF TRENCHES		2
TOTAL LENGTH		186'
ABSORPTION AREA		5584
DISTRIBUTION BOX LEVEL		<input checked="" type="checkbox"/>
DISTRIBUTION BOX BAFFLE		<input checked="" type="checkbox"/>
DISTRIBUTION BOX PORT		<input checked="" type="checkbox"/>

SEPTIC TANK DATA	
SEPTIC TANK 1 LEVEL	<input checked="" type="checkbox"/>
Capacity	1500 GAL
SEAM LOC	Top
TANK LID DEPTH	3'
BAFFLES	<input checked="" type="checkbox"/>
BAFFLE FILTER	
MANHOLE LOC	Front
6" PORT LOC	Back
WATERTIGHT TEST	<input checked="" type="checkbox"/>
SEPTIC TANK 2 LEVEL	
CAPACITY	_____ GAL
SEAM LOC	_____
TANK LID DEPTH	_____
BAFFLES	<input checked="" type="checkbox"/>
BAFFLE FILTER	_____
MANHOLE LOC	_____
6" PORT LOC	_____
WATERTIGHT TEST	_____

Preservation Court

PRE-CONSTRUCTION 3/11/05 - SRA staked, contours accurate.


Install (2) 43' trenches on contour (SO)


INSTALLATION 3/11/05 - OK to cover all work (SO)

BUILDING PERMIT SIGNED
AND RETURNED

FINAL INSPECTOR [Signature]

DATE OF APPROVAL 3/11/05

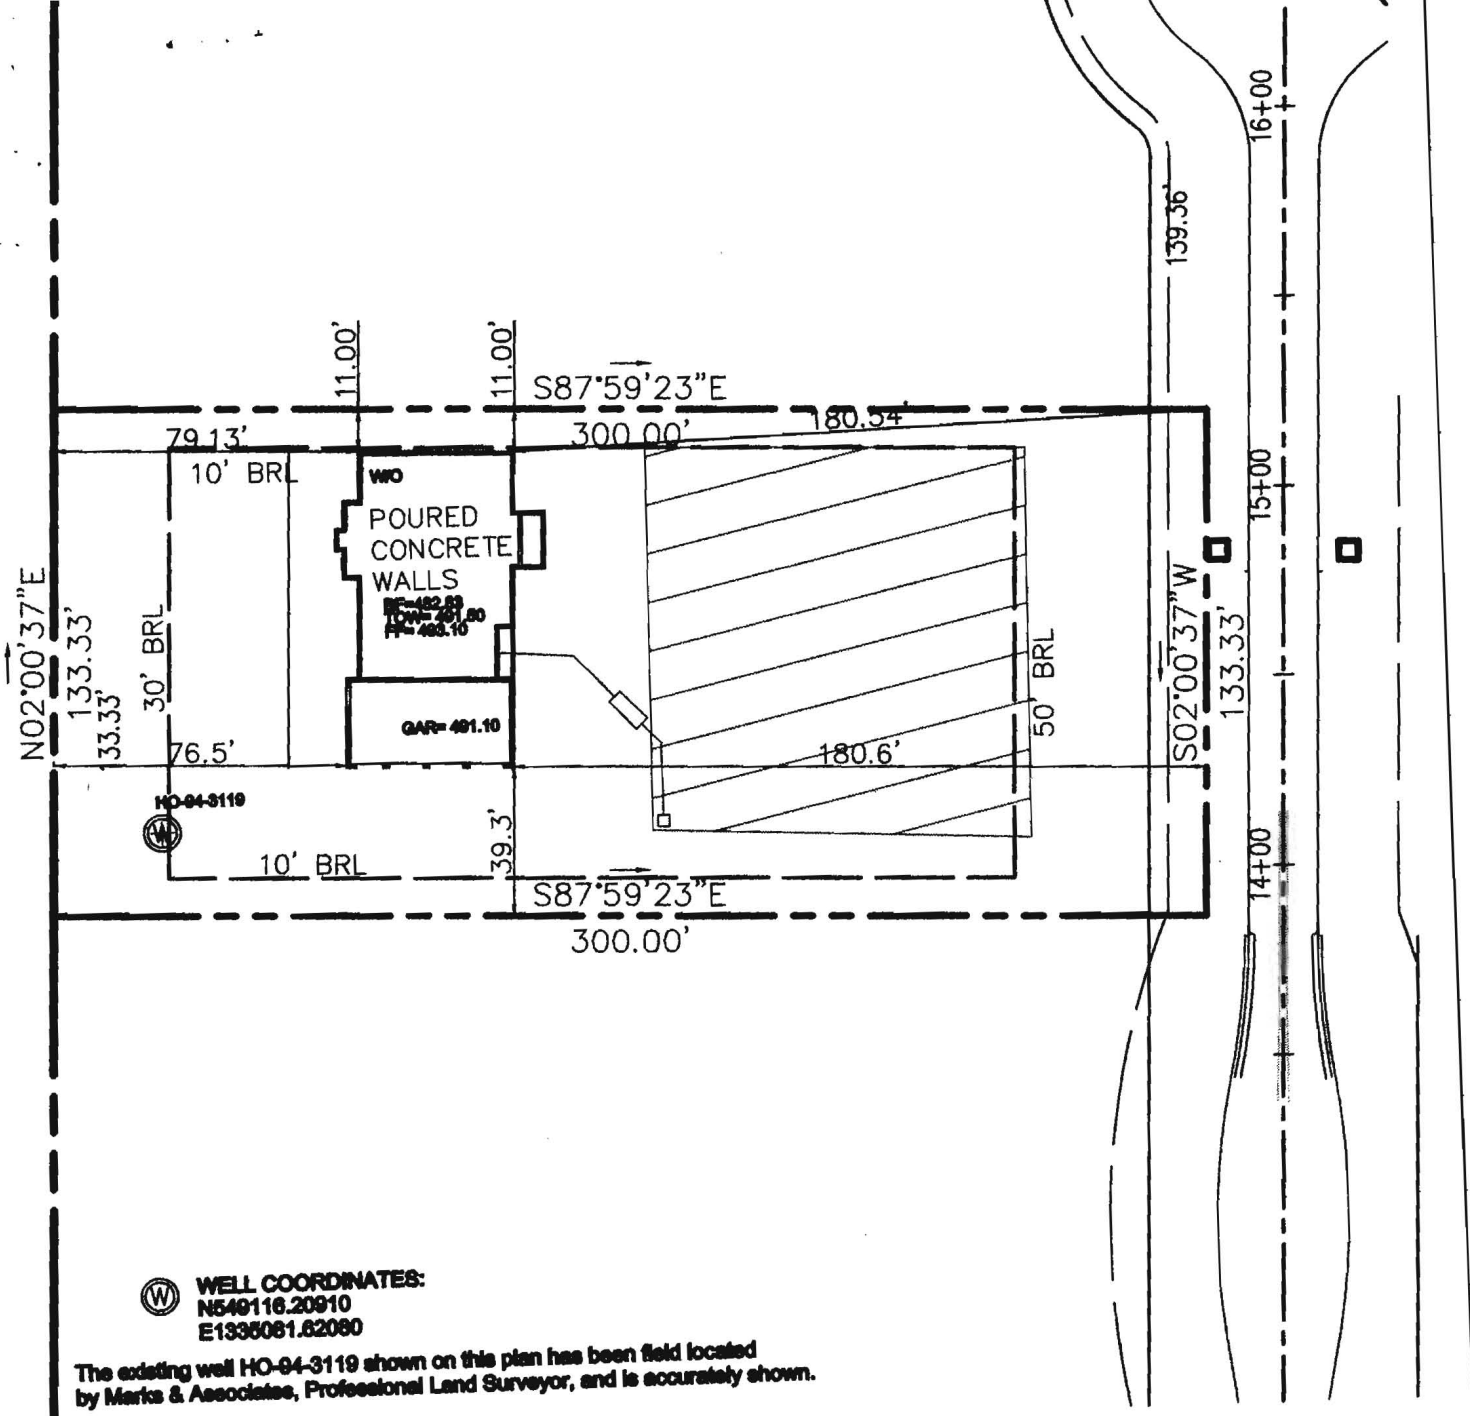


WELL COORDINATES:
 N549116.20910
 E1335061.62060

The existing well HO-84-3119 shown on this plan has been field located by Marks & Associates, Professional Land Surveyor, and is accurately shown.


WALL CHECK
SINGLE FAMILY DWELLING
LOT 13
 the STASIEWICZ residence
 PINDELL WOODS
 HOWARD COUNTY, MARYLAND

DATE: 9.13.04
SCALE: 1" = 50'

ENGINEER
MARKS & ASSOCIATES LLC
 4531 COLLEGE AVENUE
 ELLICOTT CITY, MARYLAND 21043
 410 747 8738

AS-BUILT ELEVATIONS:
 TOP OF FNDN WALL: **492.1'**



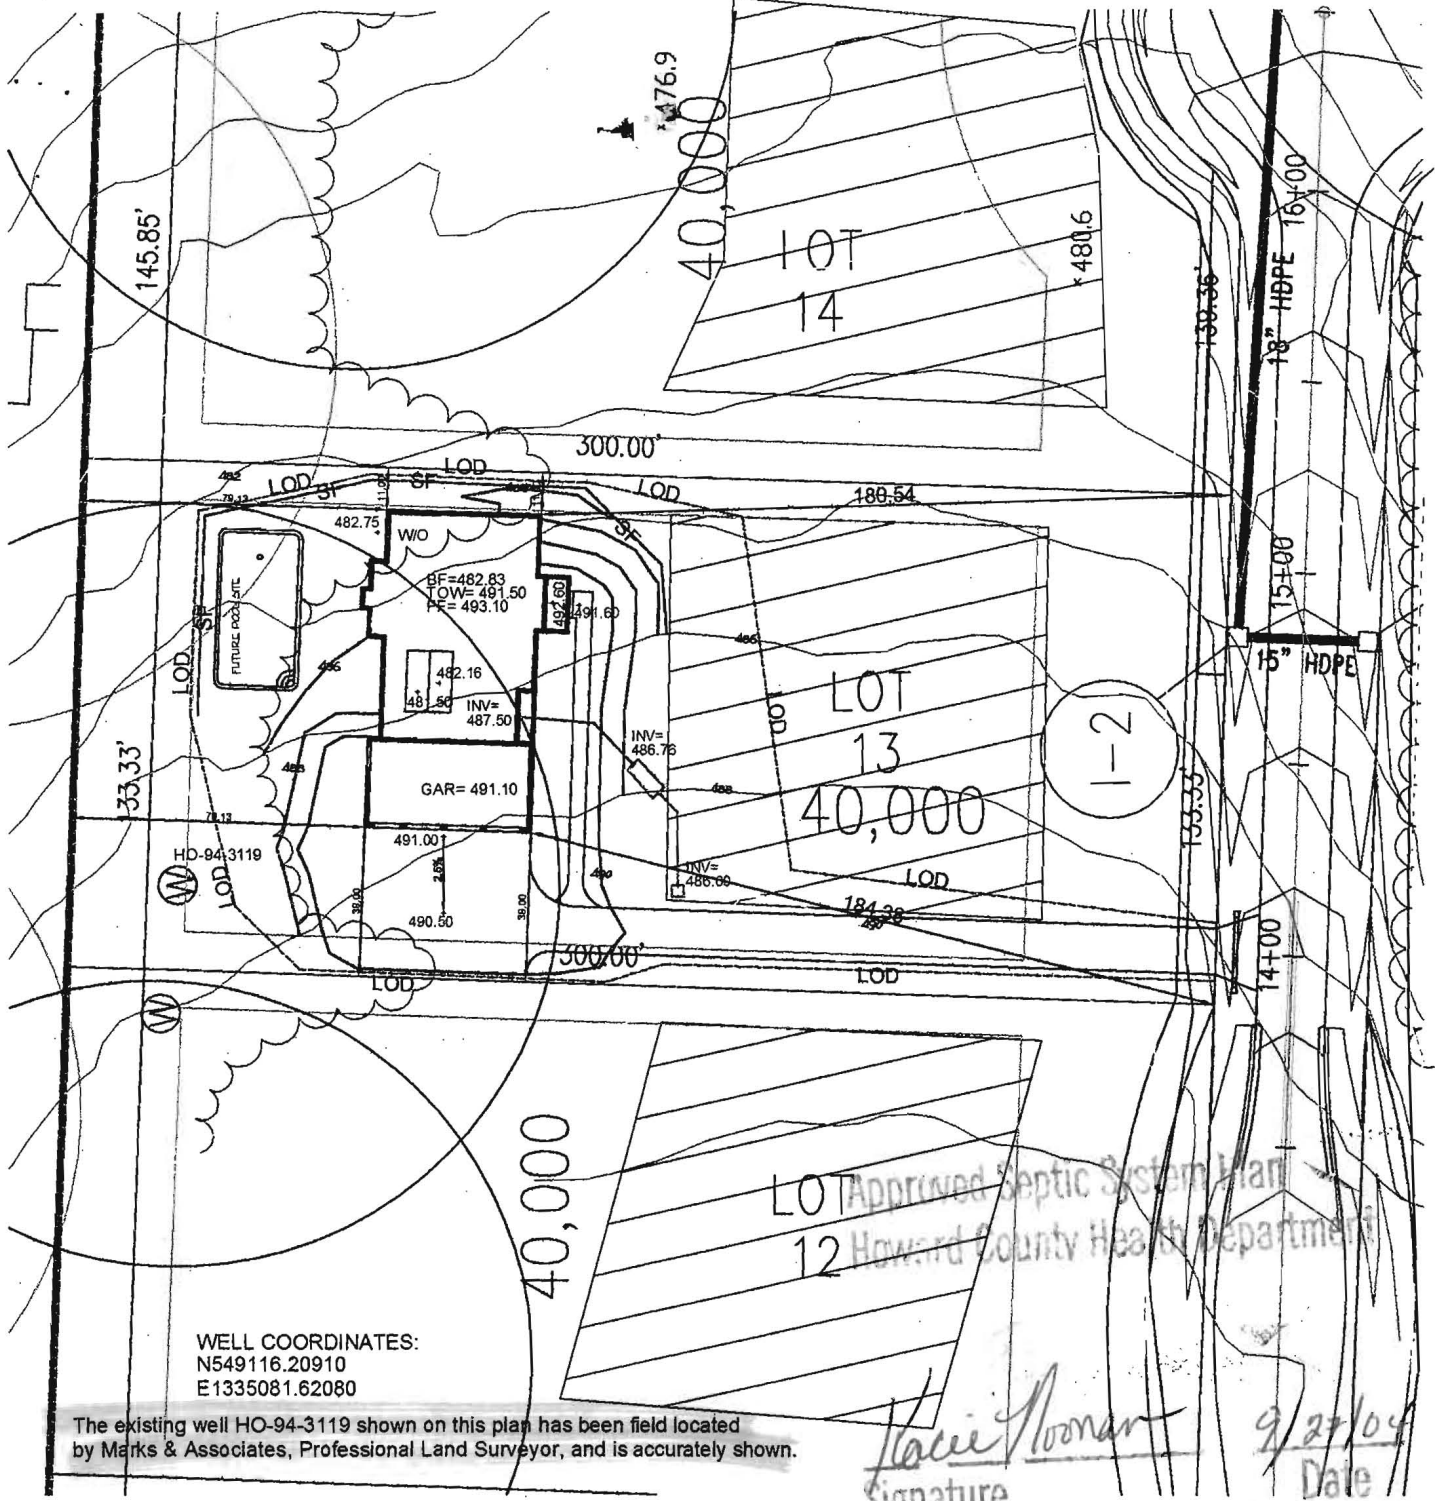

WELL COORDINATES:
 N549116.20910
 E1335081.62080

The existing well HO-94-3119 shown on this plan has been field located by Marks & Associates, Professional Land Surveyor, and is accurately shown.

Kacie Noonan
 Signature

9/27/04
 Date

PLOT PLAN

SINGLE FAMILY DWELLING

LOT 13

the STASIEWICZ residence

PINDELL WOODS

HOWARD COUNTY, MARYLAND

DATE: 9.13.04

SCALE: 1" = 50'

OWNER/BUILDER:

DALE THOMPSON BUILDERS
 6300 WOODSIDE COURT, SUITE A
 COLUMBIA, MD. 21046
 410-995-6736

PROPOSED ELEVATIONS

BASEMENT FLOOR:	482.83
TOP OF FNDN WALL:	491.50
FIRST FLOOR:	493.10
INVERT OUT OF HOUSE:	487.50
INVERT INTO TANK:	486.76
INVERT INTO DISTRIBUTION BOX:	486.00
GRADE AT SEPTIC TANK:	488.00
GRADE AT DISTRIBUTION BOX:	489.50

PAVING SPECIFICATIONS:

- 2" ASPHALT OVER 4" CR-6 OR
- 2.5" ASPHALT OVER 1.5" OVERLAY
- 50 LF OF FILTER CLOTH BEGINNING AT DRIVEWAY APRON

OK



ERIK C. MARKS, R.P.L.S.

Tel (410) 747-8738

Fax (410) 747-8739

MARKS & ASSOCIATES

Land Surveying & Planning

4531 College Avenue
Ellicott City, Maryland 21043