

PUB. SEWER STATUS VERIFIED BY _____

ISSUE DATE: 9/5/73

PERMIT

P 18931

APPROVAL DATE: 9/7/73

INDEXED

A (REPAIR) 521981-A

05 355 710

ON-SITE SEWAGE DISPOSAL SYSTEM HOWARD COUNTY HEALTH DEPARTMENT BUREAU OF ENVIRONMENTAL HEALTH

IS PERMITTED TO INSTALL ALTER

ADDRESS: _____ PHONE NUMBER: _____

SUBDIVISION: Highland Acres LOT NUMBER: 10, Sect 3

ADDRESS: 12492 E. Nugget Court PROPERTY OWNER: Richard Lee Jones

SEPTIC TANK CAPACITY (GALLONS): 1000

PUMP CHAMBER CAPACITY (GALLONS): _____

NUMBER OF BEDROOMS: _____

SQUARE FEET PER BEDROOM: _____

LINEAR FEET OF TRENCH REQUIRED: _____

TRENCHES:	Trench to be _____ feet wide. Inlet _____ feet below original grade. Bottom maximum depth _____ feet below original grade. Effective area begins at _____ feet below original grade. _____ feet of stone below distribution pipe.
LOCATION:	
PURPOSE:	Existing septic system has failed. Call for inspection when ground is opened so sanitarian can recommend repair.

PLANS APPROVED: _____ DATE: _____

- NOTE: PERMIT VOID AFTER 2 YEARS
- NOTE: CONTRACTOR RESPONSIBLE FOR SCHEDULING A PRE-CONSTRUCTION INSPECTION FOR ALL INSTALLATIONS
- NOTE: WATERTIGHT SEPTIC TANKS REQUIRED
- NOTE: ALL PARTS OF SEPTIC SYSTEM SHALL BE 100 FEET FROM ANY WATER WELL
- NOTE: MANHOLE RISERS REQUIRED ON ALL SEPTIC TANKS AND PUMP CHAMBERS

NEITHER THE HOWARD COUNTY COUNCIL OR THE HEALTH DEPARTMENT IS RESPONSIBLE FOR THE SUCCESSFUL OPERATION OF ANY SYSTEM PERMITTEE RESPONSIBLE FOR OBTAINING FINAL APPROVAL ON THIS PERMIT CALL 410-313-2640 FOR INSPECTION OF SEPTIC SYSTEM

BUILDING PERMIT SIGNED AND RETURNED

2/9/05 B00152137 DECK + SCREENED PORCH

A521981-A

9/6/73
after J.A.A.
9/7/73
Before Noon

9/14/73 Partial
9/17/73 R.T.
Final

PERMIT

SEWAGE DISPOSAL SYSTEM

P 18931
A 09171

MARYLAND STATE DEPARTMENT OF HEALTH

HOWARD COUNTY

INDEXED

ELLICOTT CITY

DISTRICT 5th

DATE 9/5/73

File

Paul C. Thompson and Sons IS PERMITTED TO INSTALL ALTER

ADDRESS Highland, Maryland PHONE 286-2279

A SEWAGE DISPOSAL SYSTEM LOCATED AT

SUBDIVISION Highland Acres ROAD 12492 E. Nugget Court LOT 10, Sec. 3

PROPERTY OWNER Richard Lee Jones

ADDRESS

SPECIFICATIONS 3 bedrooms

DRAIN FIELD DEPTH FEET, BOTTOM AREA SQ. FT.

SEEPAGE PITS ABSORBENT SIDE-WALL AREA SQ. FT.

SEPTIC TANK CAPACITY 1000 GALLONS

FOR GARBAGE GRINDER, INCREASE DISPOSAL AREA 22% & TANK CAPACITY 50%.

OTHER DRY WELL - 350 sq. ft. absorbent sidewall area below inlet pipe. The first 2 ft. of original ground not to be included in sidewall area. Maximum depth permitted for dry well is 12 ft. Place dry well about 85 ft. from rear lot line and 50 ft. from right sideline as seen when facing lot from East Nugget Court.

NOTE: ALL PIPE FROM HOUSE TO DRY WELL MUST BE CAST IRON, PERMIT VOID AFTER THREE YEARS.

NOTE: INSTALL STAND PIPE ON SEPTIC TANK AND DRY WELL.

PLANS APPROVED BY Donald W. Monaghan DATE 10/8/64


FILL SEPTIC TANK AND DISTRIBUTION BOX WITH WATER BEFORE CALLING FOR AN INSPECTION. COVER NO WORK UNTIL INSPECTED AND APPROVED.

NEITHER THE HOWARD COUNTY COMMISSIONERS NOR THE HEALTH DEPARTMENT IS RESPONSIBLE FOR THE SUCCESSFUL OPERATION OF ANY SYSTEM.

A 09171

BUILDING AND RETURNED

2-305 BOD152137-ARCA DECK

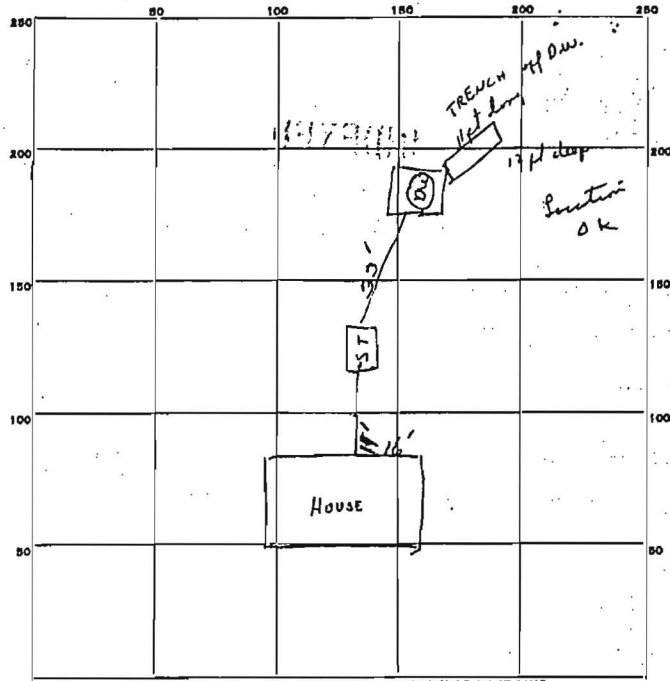

INDICATE NORTH. - NAME ADJOINING ROADWAY AS BASE LINE.

PERMIT CARD _____

SEPTIC TANK, LEVEL 1000 gal CLEANOUTS S.T. OK. D.W. OK.

DISTRIBUTION BOX, LEVEL _____

TILE FIELD, DEPTH 12 FT. TRENCH WIDTH 2 FT.

GRAVEL DEPTH 6 ft IN. TOTAL LENGTH 11 FT.

NUMBER OF TRENCHES 1 Sidewalk TOTAL BOTTOM AREA 66

SEEPAGE PITS, outside perimeter INSIDE DIAMETER 12 x 12 x 12 FT. DEPTH BELOW INLET 6 1/2 FT.

ABSORBENT AREA 299 SQ. FT. Total 365 sq. ft.

REMARKS 9/6/73 - OK to backfill O.W. and Trench
Line from house to O.W. not installed

DATE SYSTEM APPROVED 9/17/73 INSPECTOR S. Tom