

PUB. SEWER STATUS VERIFIED BY \_\_\_\_\_

ISSUE DATE: 02/07/05

P 521977

APPROVAL DATE: Not Approved

A REPAIR

**PERMIT**  
**INDEXED**

03293351

**ON-SITE SEWAGE DISPOSAL SYSTEM  
HOWARD COUNTY HEALTH DEPARTMENT  
BUREAU OF ENVIRONMENTAL HEALTH**

Fyock Septic Service IS PERMITTED TO INSTALL  ALTER

ADDRESS: PO Box 89, Glenelg, MD 21737 PHONE NUMBER: 410-988-9270

SUBDIVISION: Kingston LOT NUMBER: 12-A

ADDRESS: 3561 Conchita Drive PROPERTY OWNER: David Simard

SEPTIC TANK CAPACITY (GALLONS): \_\_\_\_\_

PUMP CHAMBER CAPACITY (GALLONS): \_\_\_\_\_

NUMBER OF BEDROOMS: \_\_\_\_\_

SQUARE FEET PER BEDROOM: \_\_\_\_\_

LINEAR FEET OF TRENCH REQUIRED: \_\_\_\_\_

TRENCHES:	Trench to be _____ feet wide. Inlet _____ feet below original grade. Bottom maximum depth _____ feet below original grade. Effective area begins at _____ feet below original grade. _____ feet of stone below distribution pipe.
LOCATION:	<u>New Tank guaranteed to 8000 psi per manufacturer,</u>
PURPOSE:	Septic tank has collapsed; installing new tank. Call for inspection when ground is opened so sanitarian can recommend repair.


PLANS APPROVED: \_\_\_\_\_ DATE: \_\_\_\_\_

- NOTE: PERMIT VOID AFTER 2 YEARS
- NOTE: CONTRACTOR RESPONSIBLE FOR SCHEDULING A PRE-CONSTRUCTION INSPECTION FOR ALL INSTALLATIONS
- NOTE: WATERTIGHT SEPTIC TANKS REQUIRED
- NOTE: ALL PARTS OF SEPTIC SYSTEM SHALL BE 100 FEET FROM ANY WATER WELL
- NOTE: MANHOLE RISERS REQUIRED ON ALL SEPTIC TANKS AND PUMP CHAMBERS

**NEITHER THE HOWARD COUNTY COUNCIL OR THE HEALTH DEPARTMENT IS RESPONSIBLE FOR THE SUCCESSFUL OPERATION OF ANY SYSTEM PERMITTEE RESPONSIBLE FOR OBTAINING FINAL APPROVAL ON THIS PERMIT CALL 410-313-2640 FOR INSPECTION OF SEPTIC SYSTEM**

PS21977

NOT TO SCALE

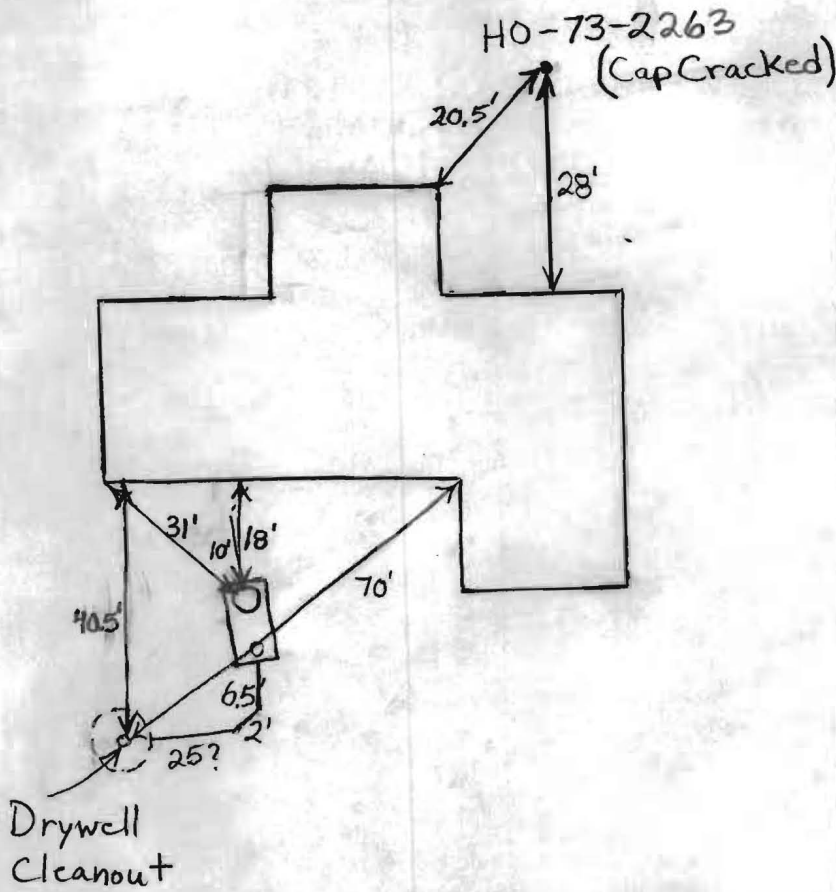

TRENCH/DRAINFIELD DATA		
WIDTH	INLET	BOTTOM
_____	_____	_____
NUMBER OF TRENCHES _____		
TOTAL LENGTH _____		
ABSORPTION AREA _____		
DISTRIBUTION BOX LEVEL _____		
DISTRIBUTION BOX BAFFLE _____		
DISTRIBUTION BOX PORT _____		

SEPTIC TANK DATA		
SEPTIC TANK 1 LEVEL <input checked="" type="checkbox"/>		
2-Comp.	CAPACITY	1500 GAL
Traffic	SEAM LOC	Top
Bearing	TANK LID DEPTH	6.5'
	BAFFLES	Yes
	BAFFLE FILTER	No
	MANHOLE LOC	Front
	6" PORT LOC	Rear
	WATERTIGHT TEST	No
SEPTIC TANK 2 LEVEL <del>N/A</del>		
	CAPACITY	_____ GAL
	SEAM LOC	_____
	TANK LID DEPTH	_____
	BAFFLES	_____
	BAFFLE FILTER	_____
	MANHOLE LOC	_____
	6" PORT LOC	_____
	WATERTIGHT TEST	_____

Conchita Drive

PRE-CONSTRUCTION 2/8/05 Replacement septic tank will be deep wherever it is installed. Traffic bearing lid is required.

INSTALLATION Tank should still be located where it will have no more than 5' of cover over it. (BB) 2/9/05 Tank set too deep. Told Fryock to send us guarantee from tank company that said the tank would be O.K. at 6.5' depth. (BB) 2/10/05 Tank company said that the tank would probably be O.K. at 6.5' but would not offer any guarantee. Fryock's said they would guarantee that tank would be able to withstand weight of dirt. However the Health Department

FINAL INSPECTOR \_\_\_\_\_ DATE OF APPROVAL Not Approved

makes no guarantee on tank. Permit to be filed away without Health Department approval. (BB)