


A13400

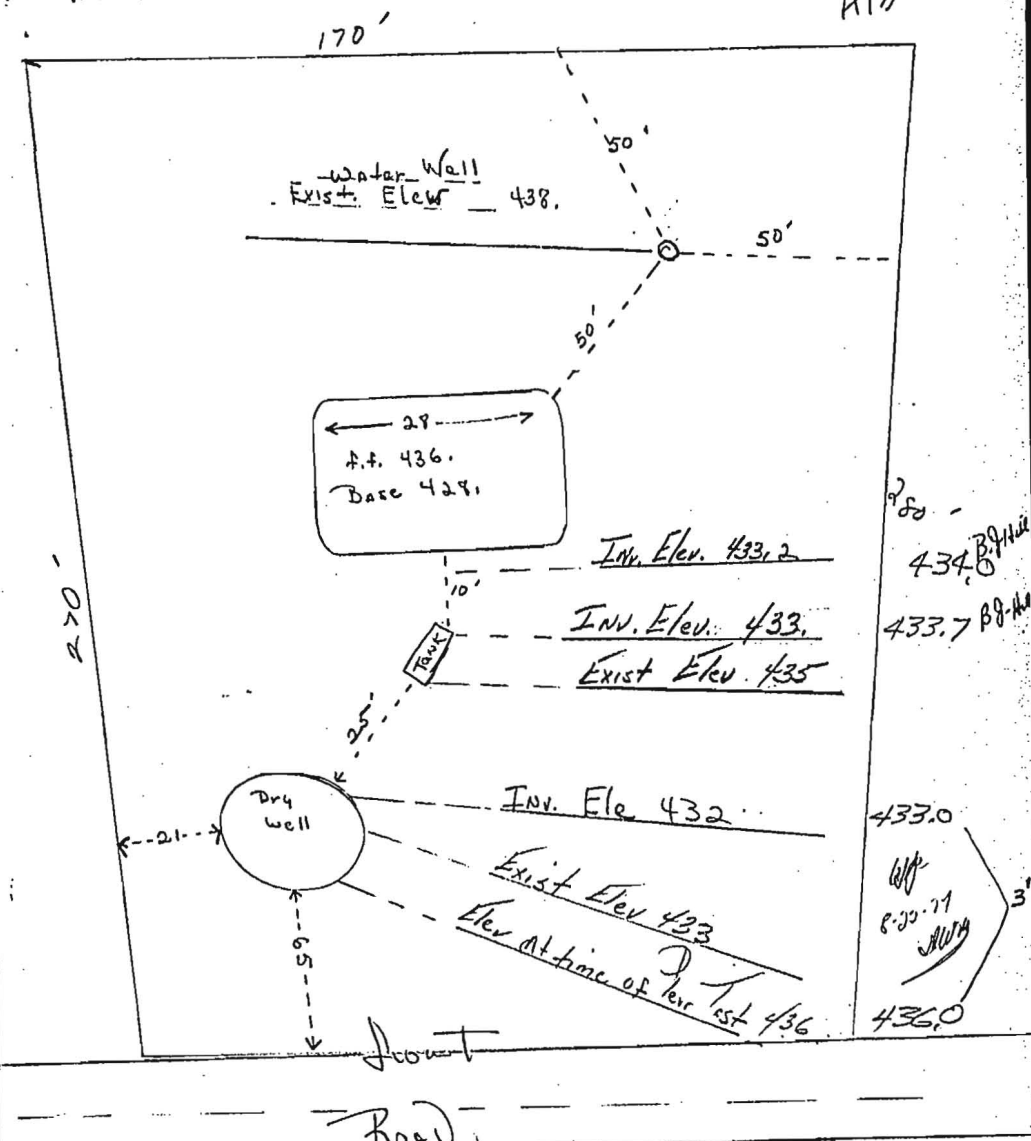

I certify The Above Measurements and Elevations are Actual and Correct for This Project

Signed By Robert L. Chaudry, Jr.