

APPLICATION

A 13400

P _____

SEWAGE DISPOSAL TESTING

MARYLAND STATE DEPARTMENT OF HEALTH

HOWARD COUNTY

ELLICOTT CITY

DISTRICT 3

DATE 12-8-67

TO: THE COUNTY HEALTH OFFICER
ELLICOTT CITY, MARYLAND

I, HEREBY, APPLY FOR THE NECESSARY TESTS IN ORDER TO CONSTRUCT (OR RECONSTRUCT) A SEWAGE DISPOSAL SYSTEM.

PROPERTY OWNER James W. King, Sr.

ADDRESS 304 Freetown Rd., Simpsonville PHONE 286-2757

PROPERTY LOCATION:

SUBDIVISION Kingston LOT NO. 19 ¹² Sub A

ROAD AND DESCRIPTION Triadelphia Road
Glenelg, Md.

OCCUPANT _____ PHONE _____

PERSON TO CONSTRUCT SYSTEM _____

ADDRESS _____ PHONE _____

SIZE OF LOT 1 Acre (270' x 170') TYPE BLDG. 3 NUMBER OF BEDROOMS _____

IF NOT SINGLE RESIDENCE DESCRIBE _____

SIGNATURE OF APPLICANT James W. King, Sr., /s/


APPROVED BY _____ FOR _____ DATE _____
(KIND OF SYSTEM)

REJECTED BY _____ FOR _____ DATE _____
(KIND OF SYSTEM)

HOLD PENDING FURTHER TESTS _____ DATE _____

REASONS FOR REJECTION OR HOLDING _____

THIS IS NOT A PERMIT

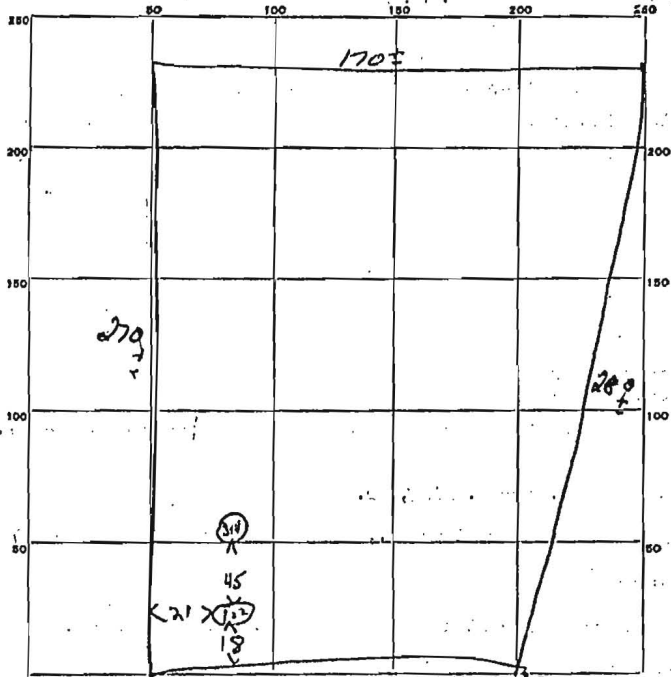

INDICATE NORTH - NAME ADJOINING ROADWAY AS BASE LINE.

DATE	TEST NO.	DEPTH	PRE-WET		TEST - 1" DROP		TIME
			START	STOP	START	STOP	
4/18/02	1	3 1/4 ft	10 54	11 09	11 00	11 13	13 min
	2	9 ft	10 56	10 58	10 58	11 02	4 min
	3	4 ft	11 03	11 05	11 05	11 10	5 min
	4	10 ft	11 05	11 06	11 06	11 08	2 min

5.5 min
3/4 ft

SOIL AUGER FINDING _____
 TESTED BY RAM
 REMARKS use pit 314 for sampler
 4/19