

# APPLICATION

A 10935

SEWAGE DISPOSAL TESTING

P \_\_\_\_\_

MARYLAND STATE DEPARTMENT OF HEALTH

HOWARD COUNTY

ELLCOTT CITY

DISTRICT 5

Septic 750 gal

DATE 9/21/65

Dry Well - 17 ft dia (cut block and top for 12 ft diameter and fill rest of pit with gravel) and 7 ft deep below inlet pipe. Inlet pipe no deeper than 3 ft below grade.

Place Dry Well about 76 ft from edge of dirt road and about 75 ft to right of D.E. Pole # 303 111 (electric line) as seen when facing lot from dirt road.

TO: THE COUNTY HEALTH OFFICER  
ELLCOTT CITY, MARYLAND

I, HEREBY, APPLY FOR THE NECESSARY TESTS IN ORDER TO CONSTRUCT (OR RECONSTRUCT) A SEWAGE DISPOSAL SYSTEM.

PROPERTY OWNER John F. & Patricia R. Sullivan

ADDRESS P. O. Box 79 - Olney, Md. PHONE SP 4-9517

PROPERTY LOCATION:

SUBDIVISION \_\_\_\_\_ LOT NO. \_\_\_\_\_

ROAD AND DESCRIPTION Highland Rd - 1 mile from Highland towards

77 Yards Hilltop Road - sign owned Sullivan + Goldenbiller

OCCUPANT \_\_\_\_\_ PHONE \_\_\_\_\_

PERSON TO CONSTRUCT SYSTEM \_\_\_\_\_

ADDRESS \_\_\_\_\_ PHONE \_\_\_\_\_

SIZE OF LOT approx. 8 acres TYPE BLDG. 3

NUMBER OF BEDROOMS

IF NOT SINGLE RESIDENCE DESCRIBE \_\_\_\_\_

SIGNATURE OF APPLICANT Patricia R. Sullivan

APPROVED BY D.W. Morgan FOR By W.M. (K) DATE 10/21/65

(KIND OF SYSTEM)

REJECTED BY \_\_\_\_\_ FOR \_\_\_\_\_ DATE \_\_\_\_\_


(KIND OF SYSTEM)

HOLD PENDING FURTHER TESTS \_\_\_\_\_ DATE \_\_\_\_\_

REASONS FOR REJECTION OR HOLDING \_\_\_\_\_

## THIS IS NOT A PERMIT

3  
1467  
Oct 28

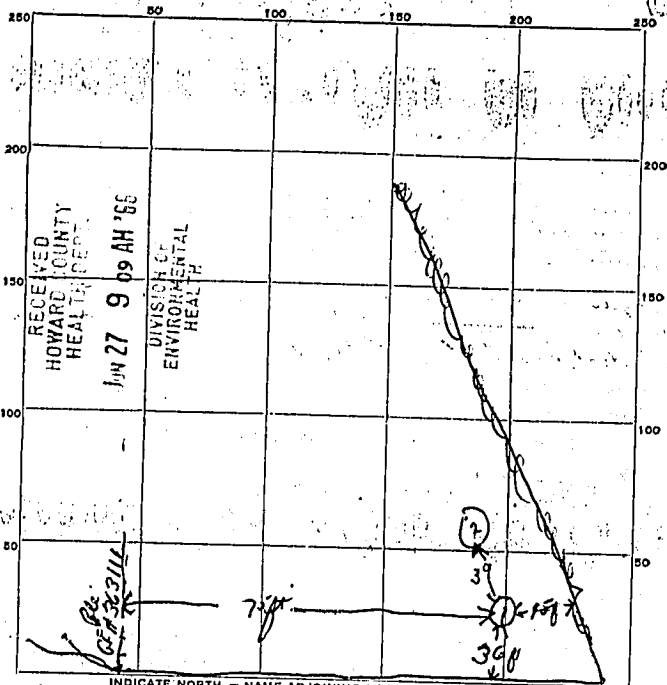

INDICATE NORTH - NAME ADJOINING ROADWAY AS BASE LINE.

*Dist. Road* → *to Highway Rd*

*9:35  
arrived  
9:35*

DATE	TEST NO.	DEPTH	PRE-WET		TEST - 1" DROP		TIME
			START	STOP	START	STOP	
10/31/65	1	9 1/2 ft	9 42	9 58	9 58	10 30	32 min } 25 min approx
	2	9 1/2 ft	9 45	9 54	9 54	10 12	
						10 18	18 min

arrived 9:35 10/31/65  
SOIL AUGER FINDING: Shale and sand.

TESTED BY: *DSM*

REMARKS: *5' below pit not tested because soil same as deep hole*  
10/31/65 also present - *John Sullivan*