

APPLICATION

PERCOLATION TESTING

SPECIAL VISUAL

OLD A 3907
P

HOWARD COUNTY HEALTH DEPARTMENT
BUREAU OF ENVIRONMENTAL HEALTH
P.O. BOX 476 ELLICOTT CITY, MARYLAND 21043
TELEPHONE: 461-9933

DISTRICT 571

DATE _____

TO: THE COUNTY HEALTH OFFICER
ELLICOTT CITY, MARYLAND

I, HEREBY, APPLY FOR THE NECESSARY TEST IN ORDER TO CONSTRUCT (OR RECONSTRUCT) A SEWAGE DISPOSAL SYSTEM.

PROPERTY OWNER POTOMAC ELECTRIC POWER COMPANY

ADDRESS 1900 PENNSYLVANIA AVE NW PHONE 202 872 3526
WASHINGTON DC 20063

PROSPECTIVE BUYER _____

ADDRESS _____ PHONE _____

PROPERTY LOCATION:

SUBDIVISION WATERMAN ESTATES LOT NO. NEW 26 OLD 4

ROAD AND DESCRIPTION BROWN BRIDGE RD

TAX MAP _____ PARCEL # _____

SIZE OF LOT _____ TYPE BLDG. _____
(SINGLE FAMILY DWELLING OR COMMERCIAL)

THE SYSTEM INSTALLED UNDER THIS APPLICATION IS ACCEPTABLE ONLY UNTIL PUBLIC FACILITIES BECOME AVAILABLE. I FULLY UNDERSTAND THE FEE CONNECTED WITH THE FILING OF THIS PERC TEST APPLICATION IS NON-REFUNDABLE UNDER ANY CIRCUMSTANCES. I ALSO AGREE TO COMPLY WITH ALL M.O.S.H.A. REQUIREMENTS IN TESTING THIS LOT.

(SIGNATURE OF APPLICANT)

APPROVED BY _____ FOR _____ DATE _____

REJECTED BY _____ FOR _____ DATE _____



HOLD PENDING FURTHER TESTS _____ DATE _____

REASONS FOR REJECTION OR HOLDING _____

HD-216

THIS IS NOT A PERMIT

NATURAL
ESTATES
LOT 26

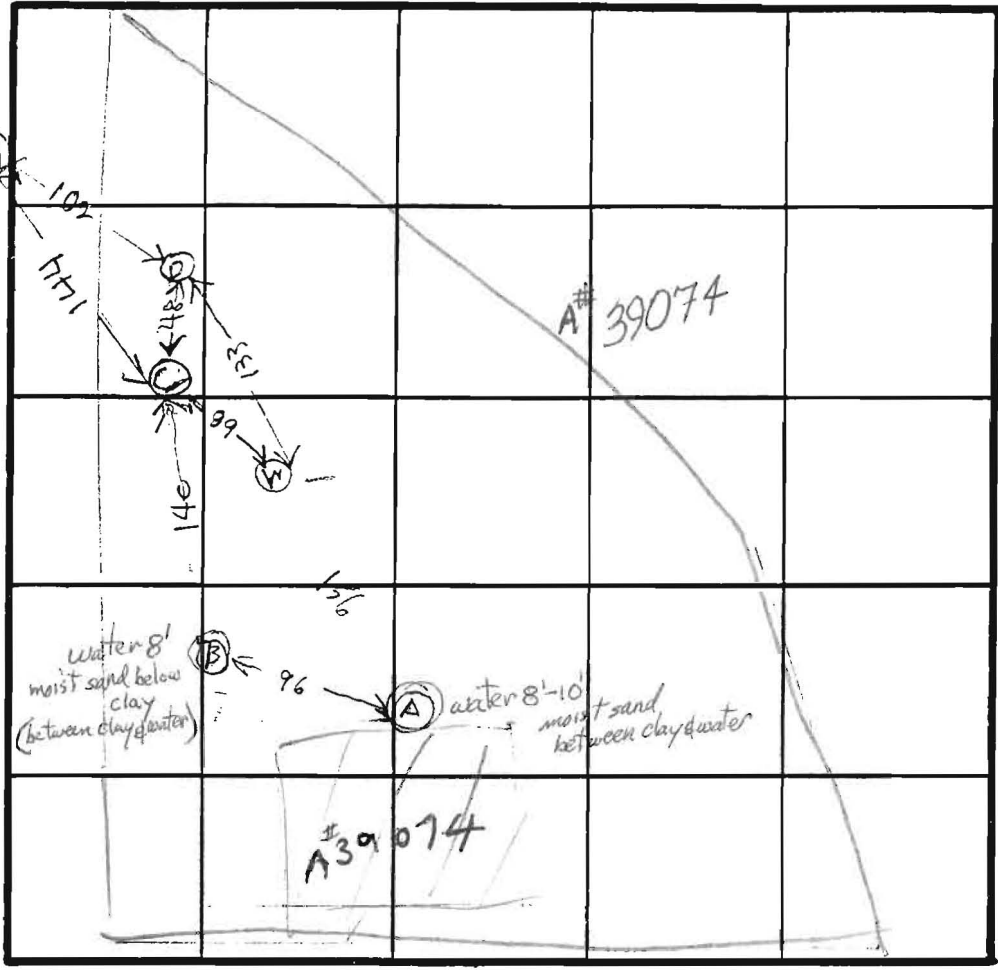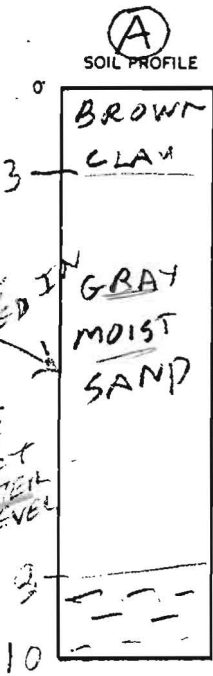

INDICATE NORTH - NAME ADJOINING ROADWAY AS BASE LINE.

BROWN BRIDGE RD

DATE	TEST NO.	DEPTH	PRE-WET		TEST - 1" DROP		TIME
			START	STOP	START	STOP	
3/12/02	AV	10	WATER 8-10 FT		FALL		
" "	BV	9	WATER 8 FT		FALL		
" "	CV	3	WATER 12 FT		OK SHALLOW		
" "	DV	13 1/2	DRY		OK SHALLOW		

- (B)
- BROWN CLAY
- GRAY MOIST SAND
- WATER
- (C)
- BROWN CLAY
- GRAY SAND LOAM
- WATER
- (D)
- BROWN CLAY
- GRAY BROWN SAND LOAM

REMARKS HOLD FOR REVIEW

TYPE OF SOIL _____

TESTED BY B. HODGEL ALSO PRESENT MIL THOMPSON RECORD CO.