

APPLICATION

A 11043

SEWAGE DISPOSAL TESTING

P _____

MARYLAND STATE DEPARTMENT OF HEALTH

HOWARD COUNTY 750 gal for 3 bedrooms

ELLICOTT CITY

Septic Tank 1,000 " " 4 " "

DISTRICT 5

Drywells - 151 sq. ft. absorbent sidewalk area per bedroom.

DATE 10/19/65

Locate drywells 100 ft. from back lot line and in the area between 35 ft and 90 ft. from the right side line as lot is seen when facing it from

TO: THE COUNTY HEALTH OFFICER ~~Gardner Lane~~ Gardner Lane, ELLICOTT CITY, MARYLAND

I, HEREBY, APPLY FOR THE NECESSARY TESTS IN ORDER TO CONSTRUCT (OR RECONSTRUCT) A SEWAGE DISPOSAL SYSTEM.

PROPERTY OWNER David Gardner

ADDRESS Mink Hollow Rd. Laurel, Md. PHONE _____

PROPERTY LOCATION:

SUBDIVISION Swann Hill LOT NO. 9, Blk. 1, Plat 2

ROAD AND DESCRIPTION Gardner Lane

OCCUPANT _____ PHONE _____

PERSON TO CONSTRUCT SYSTEM _____

ADDRESS _____ PHONE _____

SIZE OF LOT 45,450 sq. ft. TYPE BLDG. 3 or 4
NUMBER OF BEDROOMS

IF NOT SINGLE RESIDENCE DESCRIBE _____

SIGNATURE OF APPLICANT V. Allan Bausch


APPROVED BY R.F. Little FOR Drywells DATE 11/1/65
(KIND OF SYSTEM)

REJECTED BY _____ FOR _____ DATE _____
(KIND OF SYSTEM)

HOLD PENDING FURTHER TESTS _____ DATE _____

REASONS FOR REJECTION OR HOLDING _____

THIS IS NOT A PERMIT

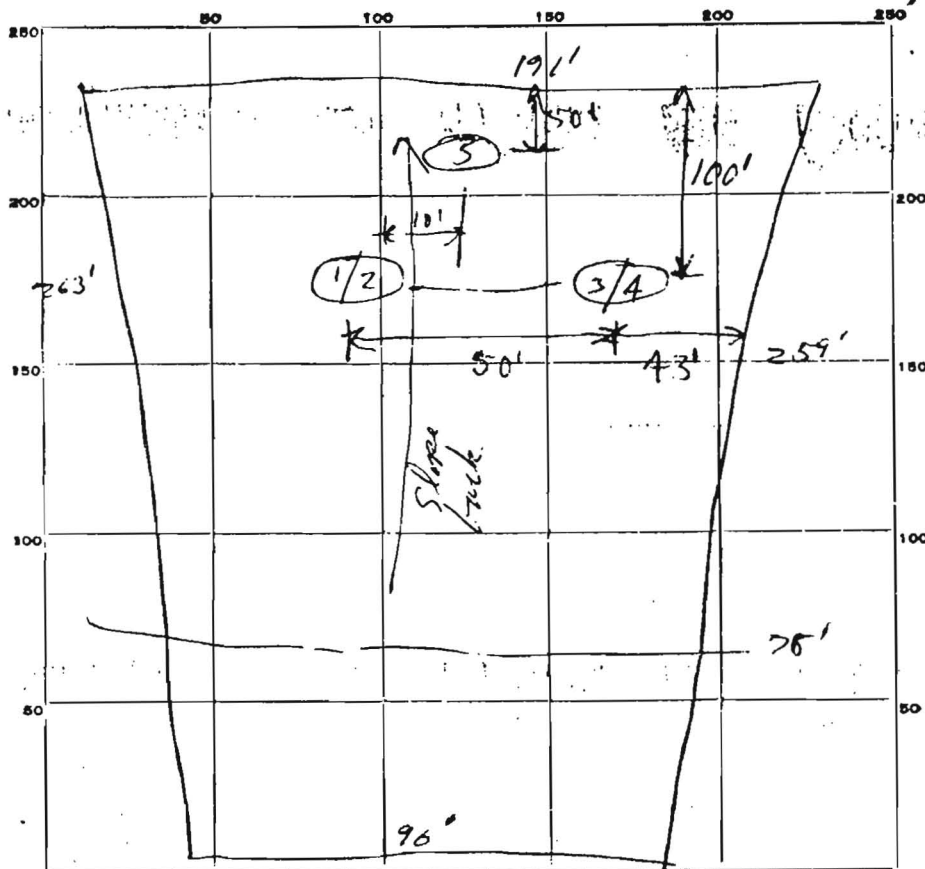

INDICATE NORTH - NAME ADJOINING ROADWAY AS BASE LINE.

Garden Lane

DATE	TEST NO.	DEPTH	PRE-WET		TEST - 1" DROP		TIME
			START	STOP	START	STOP	
11/9/65	1	3 ft.	9:40	Slow - Stop Pac.			
	2	9 ft.	9:44	9:49	9:49	10:05	16 min.
	3	5 ft.	10:01	10:08	10:08	10:20	12 min.
	4	9 ft.	10:02	10:03	10:03	10:05	2 min.
	5	* 4 ft.	Net Test - Same type soil as #3/4				

40
16
12
2
~~10~~
40
~~10~~
30

SOIL AUGER FINDING

TESTED BY *RDF 11/9/65*

REMARKS