

THIS REPORT
MUST BE SUBMITTED
WITHIN 30 DAYS
AFTER COMPLETION
OF THE WELL

WELL COMPLETION REPORT A 11043

WELL DESCRIPTION lot 9

Permit Number HE 66W 360
Owner Jordan Walker
Address _____
Subdivision _____
Section _____ Lot 9

PUMPING TEST
Hours Pumped 1
Type of Pump Used Diaphragm
Pumping Rate _____
Gallons per Minute 7

WATER LEVEL
Distance from land surface to water:
Before Pumping 10 Ft.
When Pumping 80 Ft.

APPEARANCE OF WATER
Clear to the cloudy _____
Taste None
Odor None
Height of Casing Above Land Surface 2 Ft.


PUMP INSTALLED
Type _____
Capacity _____
Gallons per Minute _____
Gallons per Hour _____
Pump Column Length _____ Ft.

WELL LOG
State the kind of formations penetrated, their color, their depth, their thickness, and if water-bearing

CASING AND SCREEN RECORD
State the kind and size and position of casing, liner, shoe, screen, and other accessories (if no casing used, give diameter of well)

	FEET from ___ to ___		DIAM (inches)	FEET from ___ to ___
		<u>Sand</u>		
		<u>Full casing</u>		
		<u>Gravel roof</u>		
		<u>well 116 ft</u>		

LOCATION OF WELL ON LOT
Show permanent structures such as building(s), septic tank, and/or other landmarks and indicate not less than 2 distances (measurements) to well.

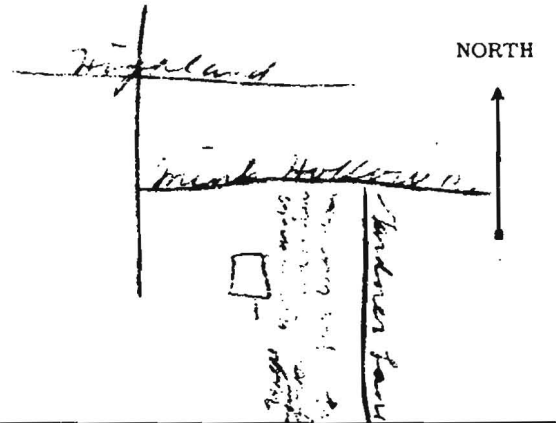

Date Well was Completed 2/9/22
Well Driller _____
Signature Danny Brown

