

7/28/66

# PERMIT

P 11963

SEWAGE DISPOSAL SYSTEM

A 11043

MARYLAND STATE DEPARTMENT OF HEALTH

HOWARD COUNTY

~~INDIAN~~

ELLICOTT CITY

DISTRICT 5

DATE 7/1/66

Elwood Scaggs IS PERMITTED TO INSTALL  ALTER

ADDRESS Murphy Rd., Laurel, Md. PHONE PA 5-0324

A SEWAGE DISPOSAL SYSTEM LOCATED AT \_\_\_\_\_

SUBDIVISION Swann Hill ROAD Gardner Lane LOT 9, Blk. 1  
Plat 2

PROPERTY OWNER David Gardner

ADDRESS \_\_\_\_\_

SPECIFICATIONS - 3 bedrooms

DRAIN FIELD \_\_\_\_\_ DEPTH \_\_\_\_\_ FEET, BOTTOM AREA \_\_\_\_\_ SQ. FT.

SEEPAGE PITS \_\_\_\_\_ ABSORBENT SIDE-WALL AREA \_\_\_\_\_ SQ. FT.

SEPTIC TANK CAPACITY 750 GALLONS

FOR GARBAGE GRINDER, INCREASE DISPOSAL AREA 22% & TANK CAPACITY 50%.

OTHER Dry wells - 151 sq. ft. absorbent sidewall area per bedroom.

Locate dry wells 100 ft. from back lot line and in the area between 35 ft.

and 90 ft. from the right side line as lot is seen when facing it from Gardner

Lane.


PLANS APPROVED BY R. Fletcher DATE 11/9/65

FILL SEPTIC TANK AND DISTRIBUTION BOX WITH WATER BEFORE CALLING FOR AN INSPECTION. COVER NO WORK UNTIL INSPECTED AND APPROVED.

NEITHER THE HOWARD COUNTY COMMISSIONERS NOR THE HEALTH DEPARTMENT IS RESPONSIBLE FOR THE SUCCESSFUL OPERATION OF ANY SYSTEM.

## NOTIFY THE HEALTH DEPARTMENT 48 HOURS BEFORE EXCAVATIONS ARE TO BE BACK FILLED.

11043

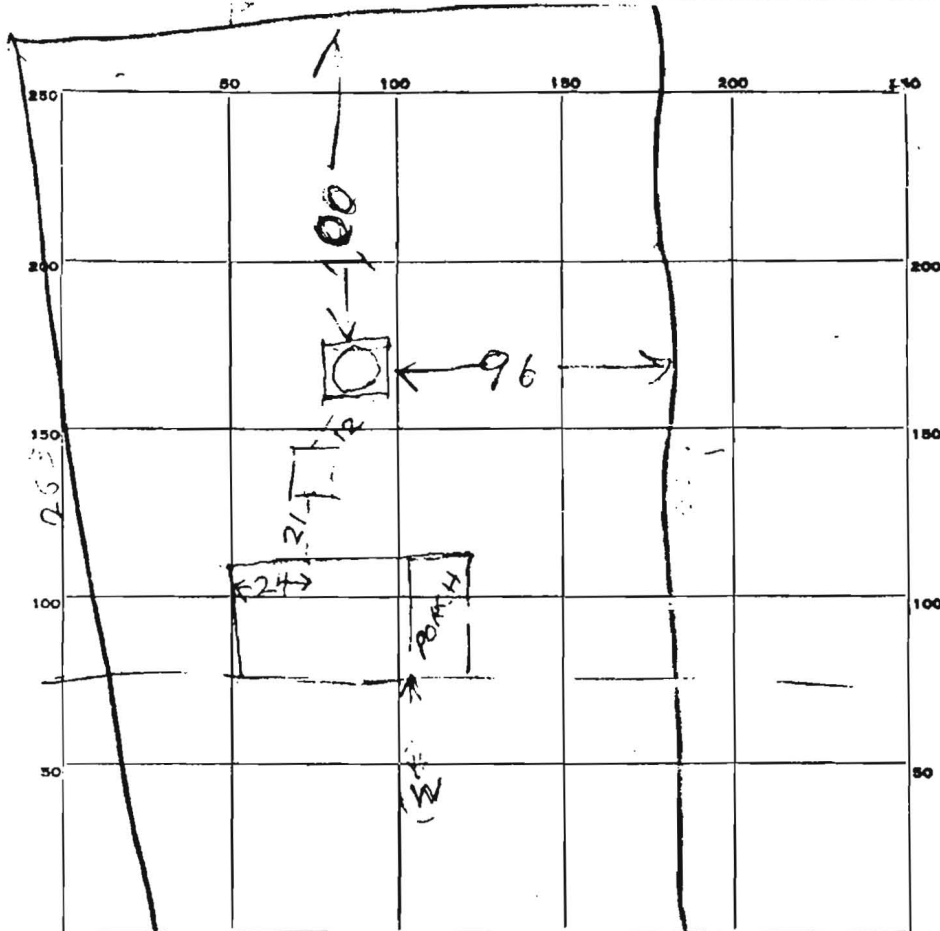

INDICATE NORTH - NAME ADJOINING ROADWAY AS BASE LINE.  
 GARFIELD AVENUE

PERMIT CARD \_\_\_\_\_

SEPTIC TANK, LEVEL 750 CLEANOUTS 68

DISTRIBUTION BOX, LEVEL \_\_\_\_\_

TILE FIELD, DEPTH \_\_\_\_\_ FT. TRENCH WIDTH \_\_\_\_\_ FT.

GRAVEL DEPTH \_\_\_\_\_ IN. TOTAL LENGTH \_\_\_\_\_ FT.


NUMBER OF TRENCHES \_\_\_\_\_ TOTAL BOTTOM AREA \_\_\_\_\_

SEEPAGE PITS, INSIDE DIAMETER 12 FT. DEPTH BELOW INLET 10.5

ABSORBENT AREA 58 SQ. FT.

REMARKS 3 1/2' x 10' x 12' = 42 sq ft  
10.5 x 44 = 462  
42 + 462 = 504

DATE SYSTEM APPROVED 11/1 INSPECTOR [Signature]

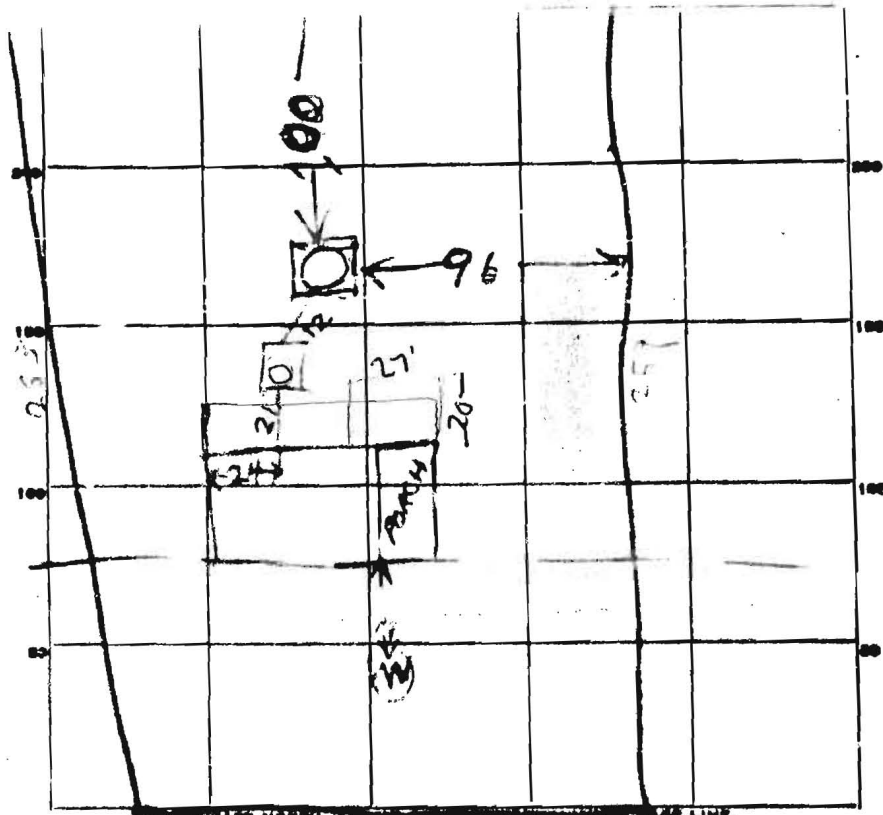

INDICATE NORTH  
GARDNER LANE

PERMIT CARD \_\_\_\_\_  
 SEPTIC TANK, LEVEL 2 CLEANOUTS 2  
 DISTRIBUTION BOX, LEVEL \_\_\_\_\_  
 TILE FIELD, DEPTH \_\_\_\_\_ FT. TRENCH WIDTH \_\_\_\_\_ FT.  
 GRAVEL DEPTH \_\_\_\_\_ IN. TOTAL LENGTH \_\_\_\_\_ FT.  
 NUMBER OF TRENCHES \_\_\_\_\_ TOTAL BOTTOM AREA \_\_\_\_\_  
 SEEPAGE PITS, INSIDE DIAMETER 12 FT. DEPTH BELOW INLET 10.5  
 ABSORBENT AREA 38 SQ. FT.

REMARKS 3 Bed Room House 450 sq ft  
Permitted Drywell 44 ft 10.5 x 44 = 462  
sq ft side wall area in drywell

DATE SYSTEM APPROVED 7/1/00 INSPECTOR Raymond Hodges