

1/4/85
9.20 PM

APPLICATION

SEWAGE DISPOSAL TESTING

A REPAIR

STATE OF MARYLAND - DEPARTMENT OF HEALTH AND MENTAL HYGIENE

P _____

HOWARD COUNTY HEALTH DEPARTMENT
ENVIRONMENTAL HEALTH SERVICES

DISTRICT _____

P. O. BOX 476 ELLICOTT CITY, MARYLAND 21043
TELEPHONE: 992-2330

DATE 1/8/85

TO: THE COUNTY HEALTH OFFICER
ELLICOTT CITY, MARYLAND

I, HEREBY, APPLY FOR THE NECESSARY TEST IN ORDER TO CONSTRUCT (OR RECONSTRUCT) A SEWAGE DISPOSAL SYSTEM.

PROPERTY OWNER Raymond L. Cabbage
14564 Dorsey Mill Road
ADDRESS Glenwood, Maryland 21738 PHONE 489-7017

PROPERTY LOCATION:

SUBDIVISION _____ LOT NO. Liber 127, Folio 244

ROAD AND DESCRIPTION _____

SIZE OF LOT 56 Acres TYPE BLDG. 3 Bedrooms - 2 Baths
(NUMBER OF BEDROOMS)

THE SYSTEM INSTALLED UNDER THIS APPLICATION IS ACCEPTABLE ONLY UNTIL PUBLIC FACILITIES BECOME AVAILABLE. I FULLY UNDERSTAND THE

FEE CONNECTED WITH THE FILING OF THIS PERC TEST APPLICATION IS NON-REFUNDABLE UNDER ANY CIRCUMSTANCES. I ALSO AGREE TO COMPLY

WITH ALL M.O.S.H.A. REQUIREMENTS IN TESTING THIS LOT. /s/ Bud Arnold
(SIGNATURE OF APPLICANT)

APPROVED BY _____ FOR _____ DATE _____

REJECTED BY _____ FOR _____ DATE _____



HOLD PENDING FURTHER TESTS _____ DATE _____

REASONS FOR REJECTION OR HOLDING _____

THIS IS NOT A PERMIT

As old septic tank/cess pool

- ① highest
- ② lowest

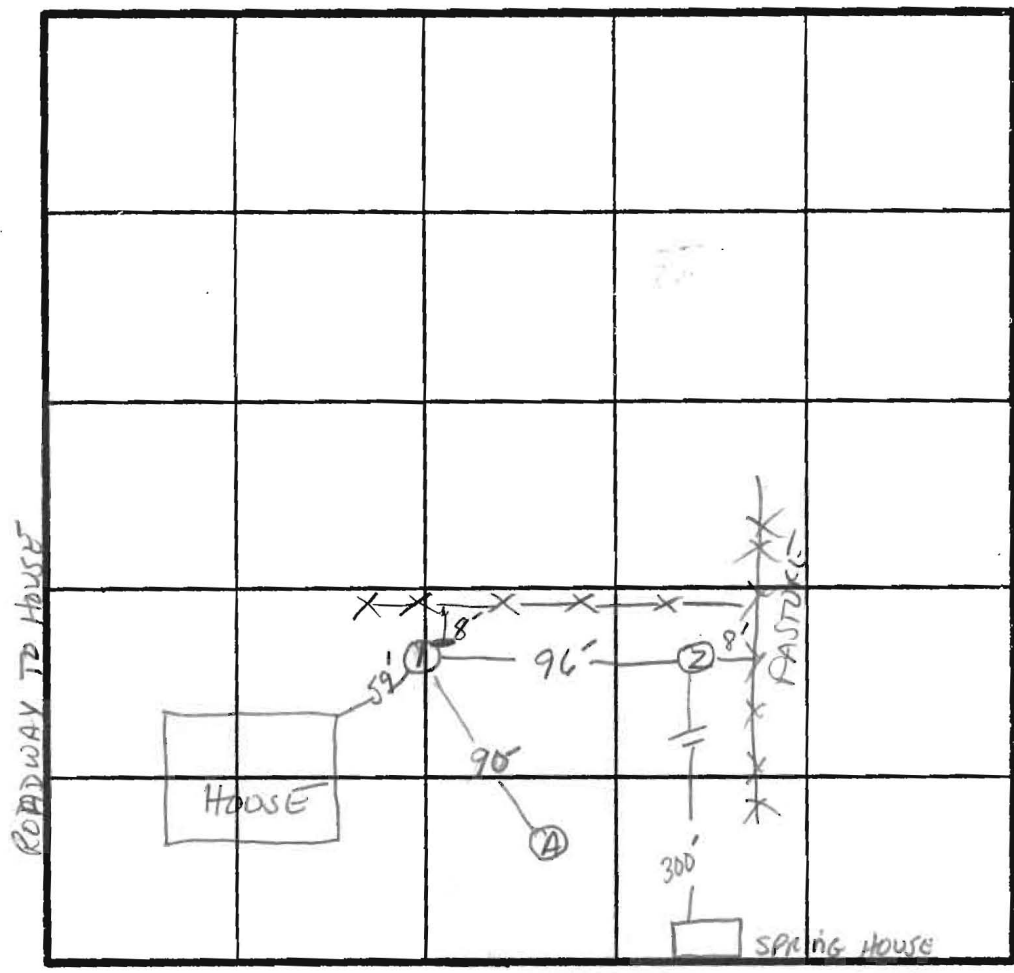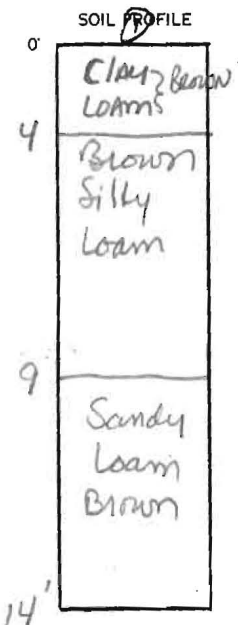

INDICATE NORTH - NAME ADJOINING ROADWAY AS BASE LINE.
DORSEY Mill Rd



DATE	TEST NO.	DEPTH	PRE-WET		TEST - 1" DROP		TIME	
			START	STOP	START	STOP		
1/10/85	1S	5'	10:08	10:17	10:17	10:35	18min	
	1M	9.5'	10:07	10:11	10:11	10:19	8min	
	1V	14'	look ok to 14' silty loam → sandy loam					
2/10/85	2S	5'	10:15	10:18	10:18	10:22	4min	
	2M	8.5'	10:16	10:23	10:23	10:38	15min	
	2V	13.5'	look ok to 13.5' silty loam to sandy loam					

28
18
4
15
—
45
11
4:45
x-11min

REMARKS _____

TYPE OF SOIL _____

TESTED BY S. Abel, R. Hodges ALSO PRESENT Arnold Co.