

PERMIT

SEWAGE DISPOSAL SYSTEM

MARYLAND STATE DEPARTMENT OF HEALTH

HOWARD COUNTY

ELLICOTT CITY

DISTRICT 4

DATE 7/21/76

TAX ID# 04-312058

P.C.O. C.B.K.

P-23580

A-21148

copy 1-24-78
[Signature]

9/15/76
[Signature]

INDEXED

Patrick L. [Signature] IS PERMITTED TO INSTALL ALTER

ADDRESS *Stony Brook Rd. [Signature]* PHONE *442-4216*

A SEWAGE DISPOSAL SYSTEM LOCATED AT _____

SUBDIVISION _____ ROAD *Rt 97 1/2 N. of 70* LOT *3-B*

PROPERTY OWNER *Harold J. B. [Signature]*

ADDRESS _____

SPECIFICATIONS

DRAIN FIELD _____ DEPTH _____ FEET, BOTTOM AREA _____ SQ. FT.

SEEPAGE PITS _____ ABSORBENT SIDE-WALL AREA _____ SQ. FT.

SEPTIC TANK CAPACITY _____ GALLONS

FOR GARBAGE GRINDER, INCREASE DISPOSAL AREA 22% & TANK CAPACITY 50%.

OTHER _____

BUILDING PERMIT SIGNED

AND RETURNED

10/28/05 B00156650 Detached garage

PLANS APPROVED BY _____ DATE _____

FILL SEPTIC TANK AND DISTRIBUTION BOX WITH WATER BEFORE CALLING FOR AN INSPECTION. COVER NO WORK UNTIL INSPECTED AND APPROVED.

NEITHER THE HOWARD COUNTY COMMISSIONERS NOR THE HEALTH DEPARTMENT IS RESPONSIBLE FOR THE SUCCESSFUL OPERATION OF ANY SYSTEM.


*Permit valid for 3 years.
All pipes from house to disposal must be cast iron.
Install stop in pipe in right tank to be dry used.
Stop in pipe must be 6" in dia, 10' long, cast iron and tested before acceptable.*

21148

A521148

175
 3
 150
 2
 16
 11
 30
 26
 56
 12 1/2
 5 1/2
 7
 42
 2
 24
 392
 66

A 21148

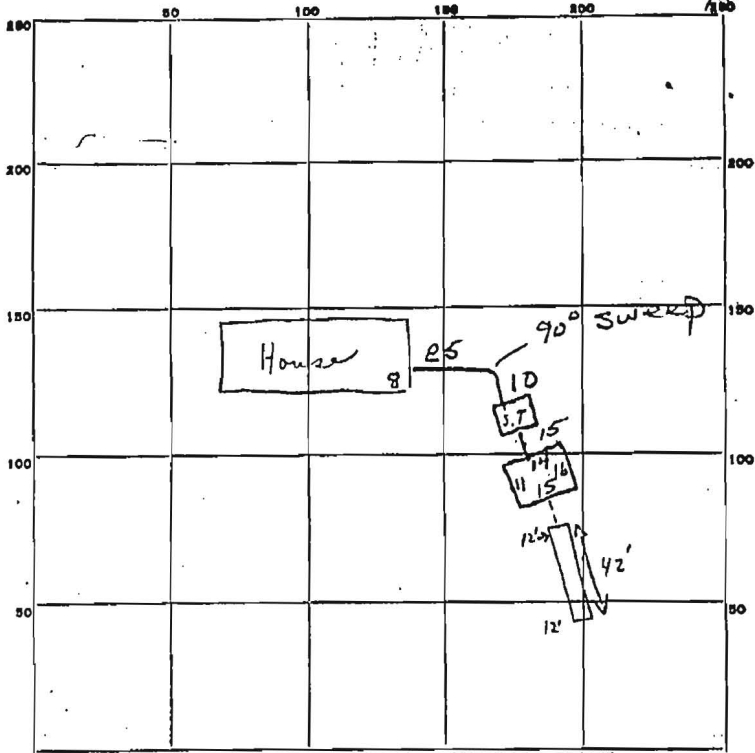

56
 7
 392
 Lot 3B


INDICATE NORTH. -- NAME ADJOINING ROADWAY AS BASE LINE.

PERMIT CARD yes Not seen { kept note }
 SEPTIC TANK, LEVEL 1000 gal ok in c.I. pipe ok for ground S.T. | P.W.
 CLEANOUTS — | — 5' tall
 DISTRIBUTION BOX, LEVEL N/A

Trench
 TILE FIELD, DEPTH 12 FT. TRENCH WIDTH — FT.
 GRAVEL DEPTH 7 IN. TOTAL LENGTH 42 FT.
 NUMBER OF TRENCHES 1 one side TOTAL BOTTOM AREA 294 ft²
 SEEPAGE PITS, INSIDE DIAMETER 56 FT. DEPTH BELOW INLET 7 FT.
 ABSORBENT AREA ± SQ. FT. 392 292 686 ft² (Gas tight)

REMARKS 9/7/76 (3 or 4 Bedrooms) Trench ok for gravel only
9/15/76 at 10:30 hb - place paper on top of
stone in D.W.

DATE SYSTEM APPROVED 1-28-76 INSPECTOR [Signature]

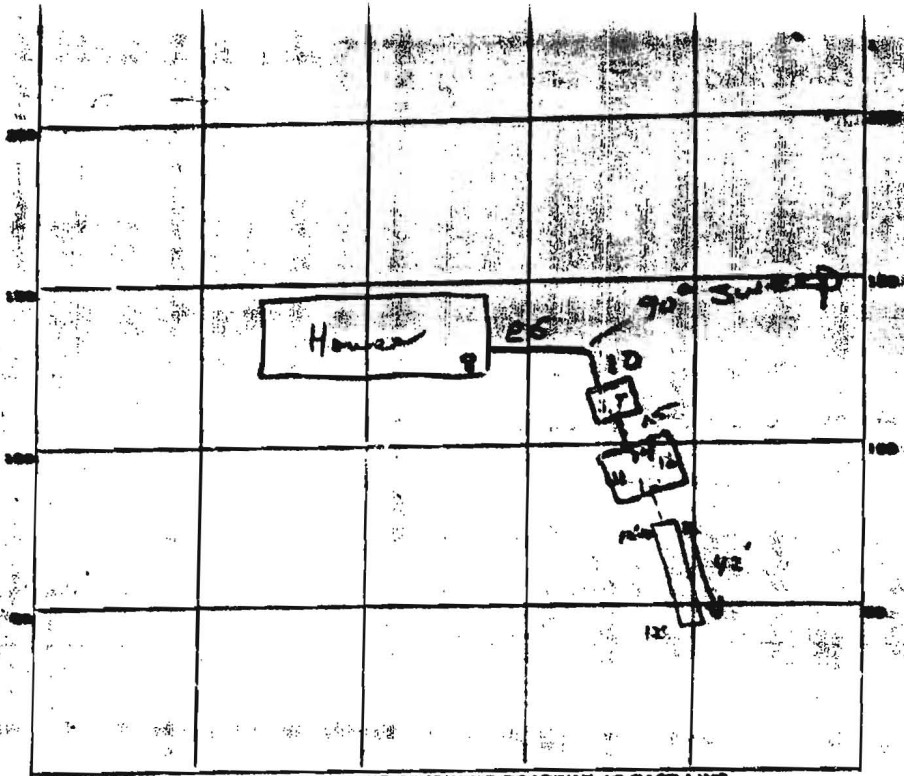

INDICATE NORTH - NAME ADJOINING ROADWAY AS BASE LINE.

PERMIT CARD **yes**
 SEPTIC TANK LEVEL 1000 gal ok CLEANOUTS 5' trail
 DISTRIBUTION BOX LEVEL N/A
 TRENCH DEPTH 12 FT. TRENCH WIDTH — FT.
 GRAVEL DEPTH 7 IN. TOTAL LENGTH 42 FT.
 NUMBER OF TRENCHES 1 TOTAL SECTION AREA 294 ft²
 SEEPAGE PITS, INSIDE-DIAMETER 56 FT. DEPTH BELOW INLET 7 FT.
 ABSORBENT AREA ± SQ. FT. 39 ft² (28 ft² req'd)

REMARKS 7/7/76 (3 Bedrooms) Trench ok for gravel only
9/15/76 at 10:30 hb - place paper on top of
stone in D.W

DATE SYSTEM APPROVED 1-28-76 INSPECTOR [Signature]