

12/1/61 AM.

approved 12/7/61
SWMS

PERMIT

SEWAGE DISPOSAL SYSTEM

P. 04591

A. 03713

INDEXED

MARYLAND STATE DEPARTMENT OF HEALTH

HOWARD COUNTY

ELLICOTT CITY

DISTRICT 5

INDEXED

DATE 12/1/61

Paul E. Bouda IS PERMITTED TO INSTALL ALTER

ADDRESS Laurel PHONE

A SEWAGE DISPOSAL SYSTEM LOCATED on Pindell School Rd. next to Simons Rest Home

SUBDIVISION ROAD LOT

PROPERTY OWNER Mary M. Simons

ADDRESS Pindel School Rd. Fulton

SPECIFICATIONS

DRAIN FIELD DEPTH FEET, BOTTOM AREA SQ. FT.

SEEPAGE PITS ABSORBENT SIDE-WALL AREA SQ. FT.

SEPTIC TANK CAPACITY 750 GALLONS

FOR GARBAGE GRINDER, INCREASE DISPOSAL AREA 22% & TANK CAPACITY 50%.


OTHER One dry well 12 ft. in diameter by 11 1/2 ft. deep below the inlet located 106 ft. from front property line and 300 ft. from left side property line which borders Simons's Rest Home. Inlet to be 2 1/2 ft. below original grade.

PLANS APPROVED BY James E. Hennigan DATE 5/24/61

FILL SEPTIC TANK AND DISTRIBUTION BOX WITH WATER BEFORE CALLING FOR AN INSPECTION. COVER NO WORK UNTIL INSPECTED AND APPROVED.

NEITHER THE HOWARD COUNTY COMMISSIONERS NOR THE HEALTH DEPARTMENT IS RESPONSIBLE FOR THE SUCCESSFUL OPERATION OF ANY SYSTEM.

A 03713

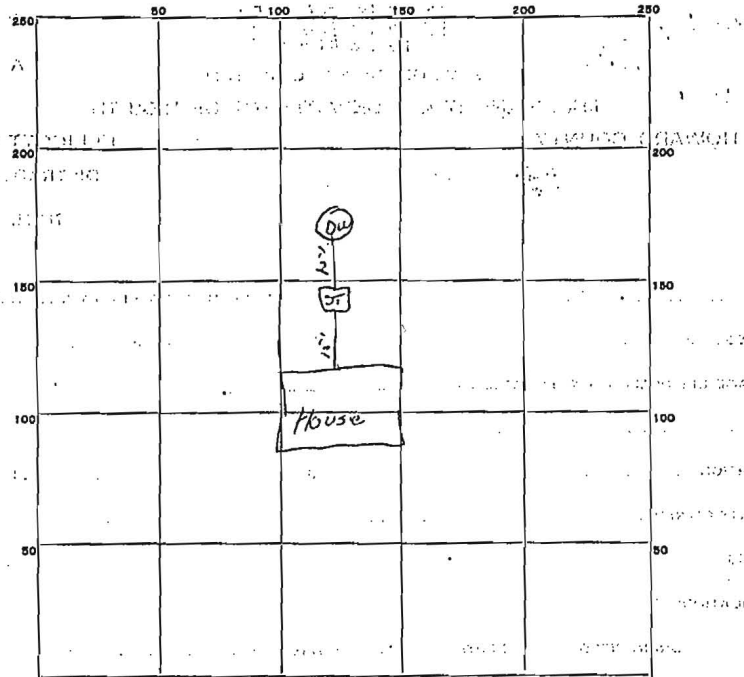

INDICATE NORTH. - NAME ADJOINING ROADWAY AS BASE LINE.
Birch School Rd

PERMIT CARD

SEPTIC TANK, LEVEL CLEANOUTS

DISTRIBUTION BOX, LEVEL _____

TILE FIELD, DEPTH _____ FT. TRENCH WIDTH _____ FT.

GRAVEL DEPTH _____ IN. TOTAL LENGTH _____ FT.

NUMBER OF TRENCHES _____ TOTAL BOTTOM AREA _____

SEEPAGE PITS, INSIDE DIAMETER 10 FT. DEPTH BELOW INLET 10 1/2 FT.

ABSORBENT AREA 361 SQ. FT.

REMARKS Wall to wall diameter is 12 ft giving absorbent area of 432 sq ft

DATE SYSTEM APPROVED 12/7/61 INSPECTOR DW Monaghan