

10/14/65

# PERMIT

P 10321

SEWAGE DISPOSAL SYSTEM

A 10186

MARYLAND STATE DEPARTMENT OF HEALTH

HOWARD COUNTY

## INDEXED

ELLCOTT CITY

DISTRICT 5

DATE 6/15/65

Tattie & Levy IS PERMITTED TO INSTALL  ALTER

ADDRESS 200 Longview Rd., Simpsonville, Md. PHONE AT 6-3241

A SEWAGE DISPOSAL SYSTEM LOCATED AT \_\_\_\_\_

SUBDIVISION Woodridge ROAD Highland Rd. LOT 8

PROPERTY OWNER Robert Stull

ADDRESS Clarksville, Maryland

SPECIFICATIONS - 3 bedrooms

DRAIN FIELD \_\_\_\_\_ DEPTH \_\_\_\_\_ FEET, BOTTOM AREA \_\_\_\_\_ SQ. FT.

SEEPAGE PITS \_\_\_\_\_ ABSORBENT SIDE-WALL AREA \_\_\_\_\_ SQ. FT.

SEPTIC TANK CAPACITY 750 GALLONS

FOR GARBAGE GRINDER, INCREASE DISPOSAL AREA 22% & TANK CAPACITY 50%.

OTHER Dry well - 300 sq. ft. sidewall area below the inlet.

Place the dry well 125 ft. to 175 ft. from the front lot line and 30 ft.

to 60 ft. from the right side line as seen when facing the lot from

Highland Rd.

PLANS APPROVED BY Raymond Hodgen DATE 5/18/65

FILL SEPTIC TANK AND DISTRIBUTION BOX WITH WATER BEFORE CALLING FOR AN INSPECTION. COVER NO WORK UNTIL INSPECTED AND APPROVED.


NEITHER THE HOWARD COUNTY COMMISSIONERS NOR THE HEALTH DEPARTMENT IS RESPONSIBLE FOR THE SUCCESSFUL OPERATION OF ANY SYSTEM.

BLDG. PERMIT SIGNED  
AND RETURNED 5/15/65  
Serial # 44073  
lluk.

A 10186

A 10186

May 1965

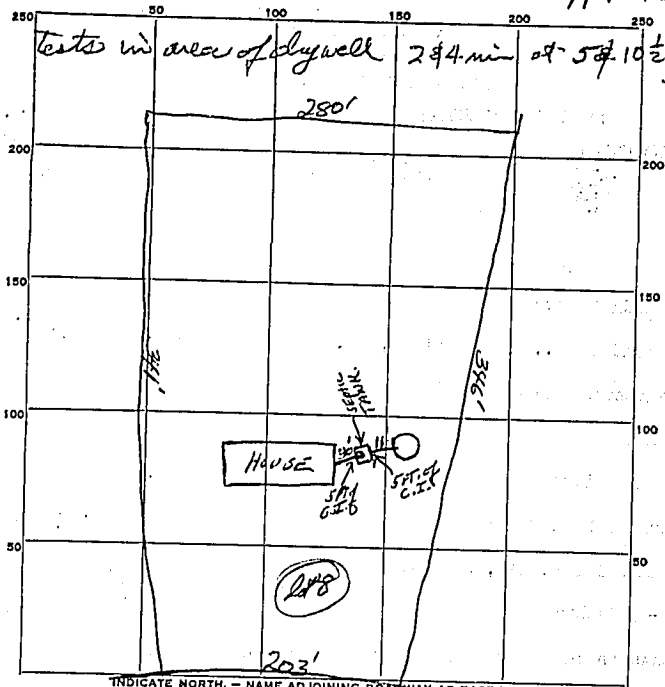

INDICATE NORTH. - NAME ADJOINING ROADWAY AS BASE LINE.

HIGHLAND Road.

PERMIT CARD

yes

SEPTIC TANK, LEVEL

✓ 750 gal. concrete CLEANOUTS 8' clearcut

DISTRIBUTION BOX, LEVEL

None

TILE FIELD, DEPTH

\_\_\_\_\_ FT.

TRENCH WIDTH

\_\_\_\_\_ FT.

GRAVEL DEPTH

\_\_\_\_\_ IN.

TOTAL LENGTH

\_\_\_\_\_ FT.

NUMBER OF TRENCHES

TOTAL BOTTOM AREA

SEEPAGE PITS, <sup>outside</sup> INSOLE DIAMETER

1 1/2

FT. DEPTH BELOW INLET

9' 9" ~~10'~~

ABSORBENT AREA

OK

SQ. FT.

REMARKS

10-8-65 Transit pipe from house to septic tank. Change to orangeburg J.H.

10/14/65 - OK Transit pipe replaced with orangeburg R/H Water Well not yet installed today

DATE SYSTEM APPROVED

14 OCT 65

INSPECTOR

Raymond Hedger