


TAX ID 05-365600
SITE INSPECTION SHEET

OWNER: James Whitman PHONE #: (310) 596-9432
ADDRESS: 5131 Green Bridge Rd CONTRACTOR: Rasche Brothers Inc
Dayton MD, 21036 WELL TAG #: _____
SUBDIVISION: Whitman Prop LOT: 3 COUNTY #: Howard
PROPOSAL: 1 story 40 x 60 Pk Barn
RV + Antique Cars

LOCATION DIAGRAM

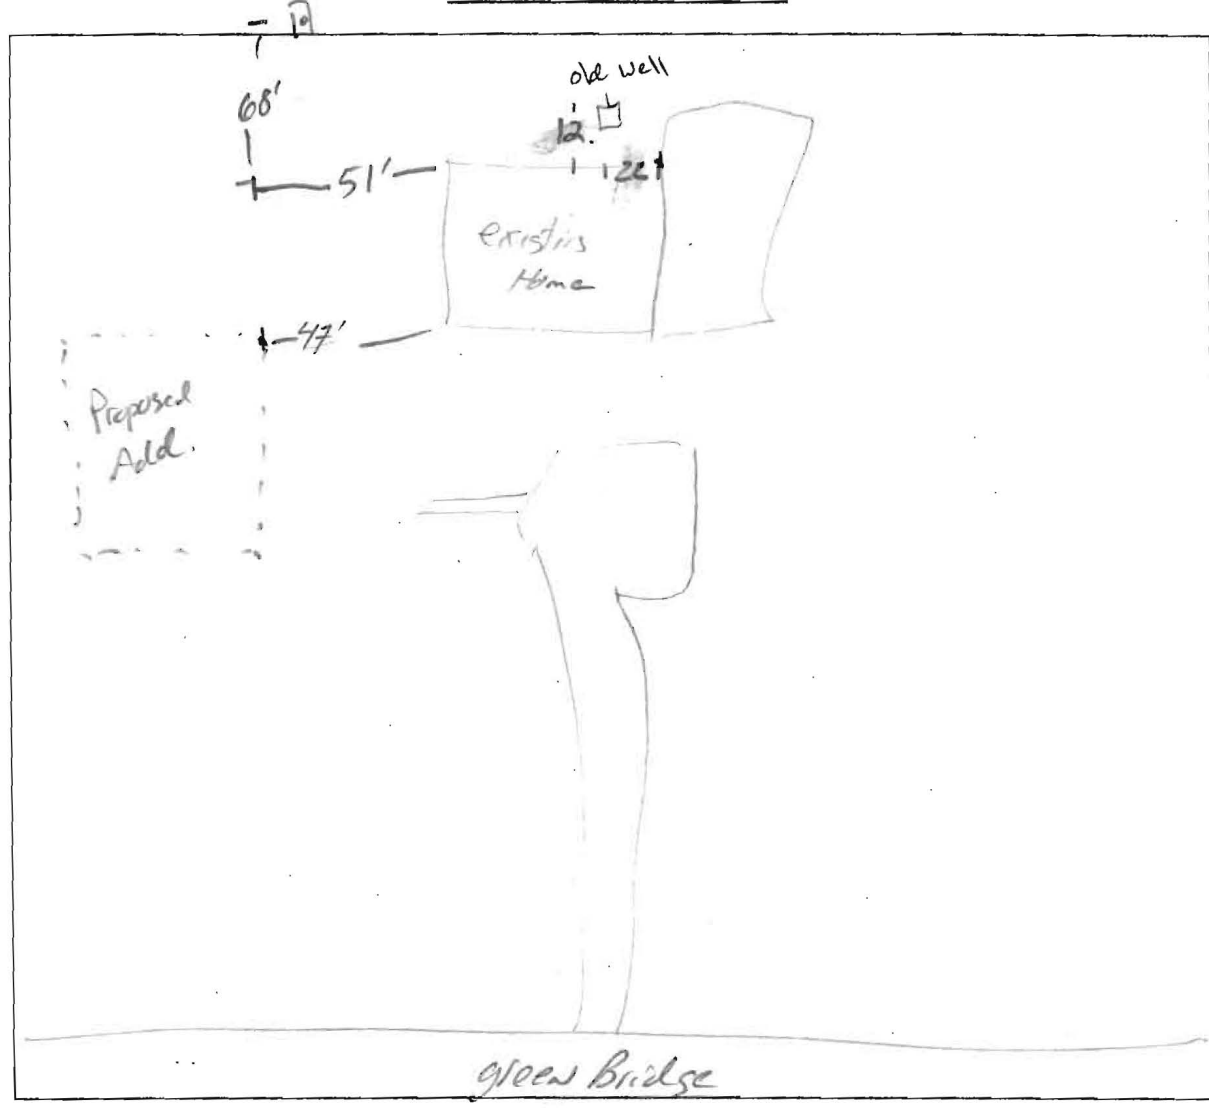

COMMENTS: _____

DATE: 4/30/04 INSPECTOR: KJB

- Help Me
- Map Reset
- Zoom Fit
- Find Location
- Remove Pin
- Layer Control
- Image Control
- Theme Map
- Local Print
- Print Layout
- Email Map
- Map Exit



Disclaimer: Howard County, Maryland assumes no responsibility for the accuracy of this map or the information contained herein or derived therefrom. The buyer and/or user assumes all risks and liabilities whatsoever resulting from or arising out of the use of this map.

