

APPLICATION

A 05340
P _____

SEWAGE DISPOSAL TESTING

MARYLAND STATE DEPARTMENT OF HEALTH

HOWARD COUNTY 750 Gallon Tank

ELLICOTT CITY

Tile Field - 660 sq ft bottom area

DISTRICT 2

Place the tile field 125 ft to 175 ft from the front lot line

DATE 6/18/62

5/25/78 void - must be reperced if lot is to be built upon per P. F. W. /hs

TO: THE COUNTY HEALTH OFFICER
ELLICOTT CITY, MARYLAND

I, HEREBY, APPLY FOR THE NECESSARY TESTS IN ORDER TO CONSTRUCT (OR RECONSTRUCT) A SEWAGE DISPOSAL SYSTEM.

PROPERTY OWNER Wm. E. Lye

ADDRESS 5542 Link Ave Balt 27 PHONE CI 2-5779

PROPERTY LOCATION:

SUBDIVISION _____ LOT NO. _____
ROAD AND DESCRIPTION Rt 108 - 365 ft. from Cedar Lane on south side of Rt 108

OCCUPANT _____ PHONE _____

PERSON TO CONSTRUCT SYSTEM _____

ADDRESS _____ PHONE _____

SIZE OF LOT 125' x 460' TYPE BLDG. 3
NUMBER OF BEDROOMS _____

IF NOT SINGLE RESIDENCE DESCRIBE _____

SIGNATURE OF APPLICANT William E. Lye


APPROVED BY Raymond Hodge FOR Tile Field DATE 19 JUNE 62

REJECTED BY _____ FOR _____ DATE _____
(KIND OF SYSTEM)

HOLD PENDING FURTHER TESTS _____ DATE _____

REASONS FOR REJECTION OR HOLDING _____

THIS IS NOT A PERMIT

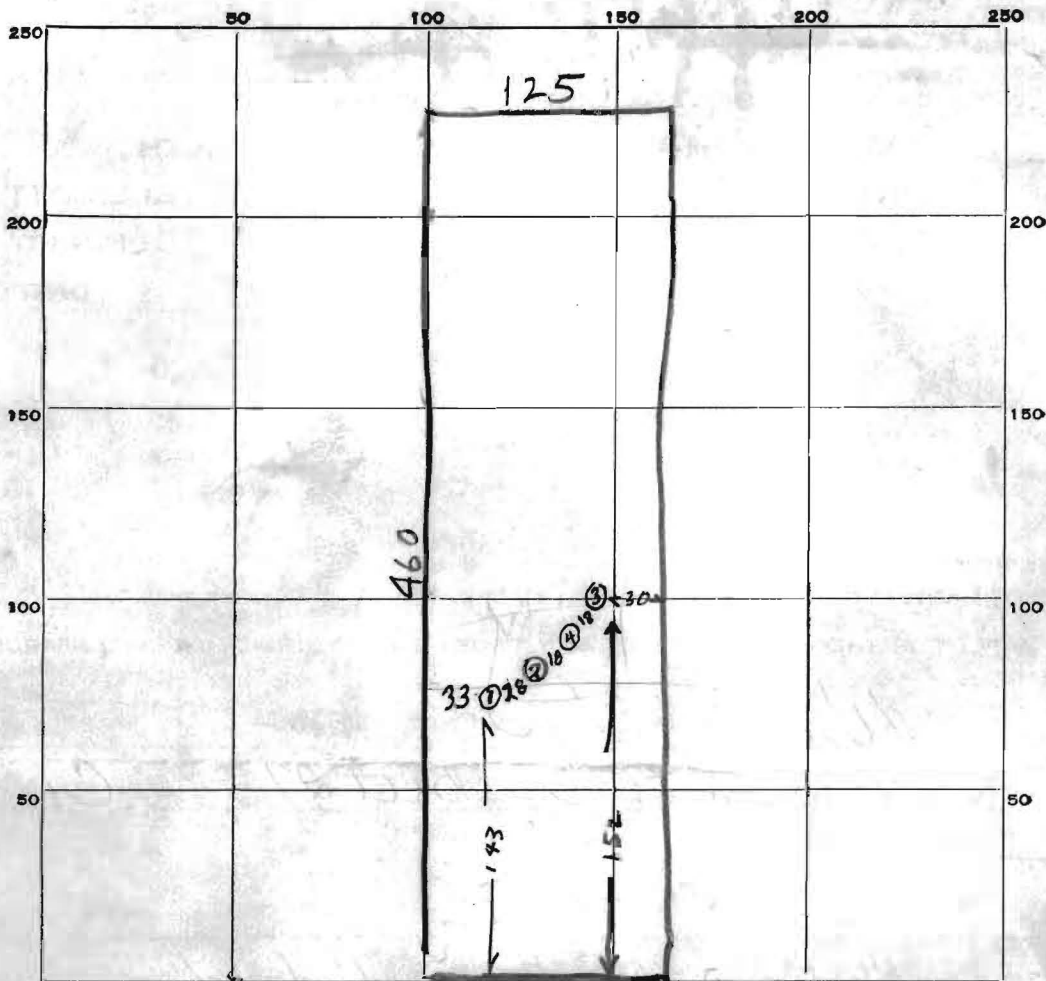

TO
CEDAR LANE
360 ft

INDICATE NORTH. - NAME ADJOINING ROADWAY AS BASE LINE.

ROUTE 108

| DATE | TEST NO. | DEPTH | PRE-WET | | TEST - 1" DROP | | TIME |
|-----------|----------|-------|---------|------|----------------|------|--------|
| | | | START | STOP | START | STOP | |
| 19 JUN 62 | 1 | 3 | 121 | 144 | 144 | 229 | 45 min |
| " " | 2 | 3 | 124 | 146 | 146 | 235 | 48 min |
| " " | 3 | 3 | 126 | 147 | 147 | 228 | 41 min |
| " " | 4 | 3 | 132 | 146 | 146 | 217 | 31 min |
| | | | | | | | |
| | | | | | | | |
SOIL AUGER FINDING _____

TESTED BY

Raymond Hodges

REMARKS _____

ALSO PRESENT _____

LOT NO. _____