

APPLICATION

A 09002

SEWAGE DISPOSAL TESTING

P _____

MARYLAND STATE DEPARTMENT OF HEALTH

HOWARD COUNTY 750 for 3 bedrooms
Septic tank - 1,000 " 4 " "
1,500 " 5 " "

ELLICOTT CITY

DISTRICT 3

DATE 9/9/64

Drywell - 100 sq. ft. absorbent sidewall one per bedroom
Locate drywell 18 ft. from left sidewalk and
either 2 1/2 ft or ~~4~~ 11 1/2 ft. from the front lot
line or lot in rear when facing it from Street "B".

TO: THE COUNTY HEALTH OFFICER
ELLICOTT CITY, MARYLAND

I, HEREBY, APPLY FOR THE NECESSARY TESTS IN ORDER TO CONSTRUCT (OR RECONSTRUCT) A SEWAGE DISPOSAL SYSTEM.

PROPERTY OWNER Burnt Woods Development Co., Inc.

ADDRESS 212 Crownwood Road, E. C., Md. PHONE HO 5-1345

PROPERTY LOCATION:

SUBDIVISION Burnt Wood LOT NO. 6, Blk. B, Sec. 2 ^{see plat 1}

ROAD AND DESCRIPTION Street "B" Ellicott Drive

OCCUPANT _____ PHONE _____

PERSON TO CONSTRUCT SYSTEM _____

ADDRESS _____ PHONE _____

SIZE OF LOT 100' x 200' TYPE BLDG. test per bedroom
NUMBER OF BEDROOMS

IF NOT SINGLE RESIDENCE DESCRIBE _____

SIGNATURE OF APPLICANT /s/ M. A. Wakoffield, Jr.


APPROVED BY R. F. Little FOR Drywell DATE 9/24/64
(KIND OF SYSTEM)

REJECTED BY _____ FOR _____ DATE _____
(KIND OF SYSTEM)

HOLD PENDING FURTHER TESTS _____ DATE _____

REASONS FOR REJECTION OR HOLDING _____

THIS IS NOT A PERMIT

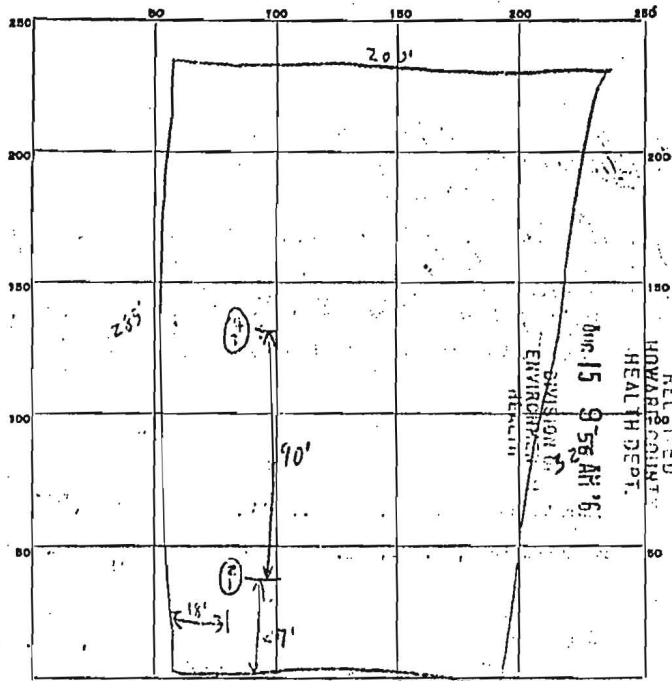

INDICATE NORTH - NAME ADJOINING ROADWAY AS BASE LINE.
 ST. "B" 100'

DATE	TEST NO.	DEPTH	PRE-WET		TEST - 1" DROP		TIME
			START	STOP	START	STOP	
7/16/64	1	12 ft.	1054	1056	1056	1059	3 min.
	2	6 ft.	1055	1057	1057	1059	2 min.
	3	11 ft.	1054	1101	1101	1105	4 min.
	4	6 ft.	1054	1101	1101	1105	4 min.

SOIL AUGER FINDING _____
 DIVISION OF ENVIRONMENTAL HEALTH
 TESTED BY DDF 7/16/64
 PH. 5. 15. 15.
 REMARKS _____
 HOWARD COUNTY HEALTH DEPT.
 ALSO PRESENT (Circled 1) RECEIVED
 LOT NO. 66-500-3 part 1