

4/10/64

PERMIT

SEWAGE DISPOSAL SYSTEM

MARYLAND STATE DEPARTMENT OF HEALTH

HOWARD COUNTY

ELLICOTT CITY

DISTRICT 3

DATE 8-4-67

INDEXED

P 12953

A 09002 A522068
-6

Ascock Excavating Co., Inc. IS PERMITTED TO INSTALL ALTER

ADDRESS 5945 Delores Ave., Baltimore, Md. 21227 PHONE 247-1024

A SEWAGE DISPOSAL SYSTEM LOCATED AT _____

SUBDIVISION Burnt Wood ROAD Castlebar Dr. LOT 6, Blk. B, Sec. 3
14006 pt. 1

PROPERTY OWNER Burnt Woods Development Co., Inc.

ADDRESS 212 Crownwood Rd., E.C., Md. 21043

SPECIFICATIONS 4-Bedrooms

**BUILDING PERMIT STOP
AND RETURNED**

DRAIN FIELD _____ DEPTH _____ FEET. BOTTOM AREA 214 sq. ft. 6052225-IG

SEEPAGE PITS _____ ABSORBENT SIDE-WALL AREA _____ SQ. FT. RISE TANK

SEPTIC TANK CAPACITY 1000 GALLONS

FOR GARBAGE GRINDER, INCREASE DISPOSAL AREA 22% & TANK CAPACITY 50%.

OTHER Drywell -- 100 sq. ft. absorbent sidewall area per bedroom. Locate
Drywell 13 ft. from left sideline and either 27 ft. or 117 ft. from the
front lot line as lot is seen when facing it from Street "B".

PERMIT VOID AFTER THREE YEARS.


PLANS APPROVED BY R. Fletcher DATE 9-24-64

FILL SEPTIC TANK AND DISTRIBUTION BOX WITH WATER BEFORE CALLING FOR AN INSPECTION. COVER NO WORK UNTIL INSPECTED AND APPROVED.

NEITHER THE HOWARD COUNTY COMMISSIONERS NOR THE HEALTH DEPARTMENT IS RESPONSIBLE FOR THE SUCCESSFUL OPERATION OF ANY SYSTEM.

**NOTIFY THE HEALTH DEPARTMENT 48 HOURS
BEFORE EXCAVATIONS ARE TO BE BACK FILLED.**

[Handwritten signature and stamp]
A522068-G

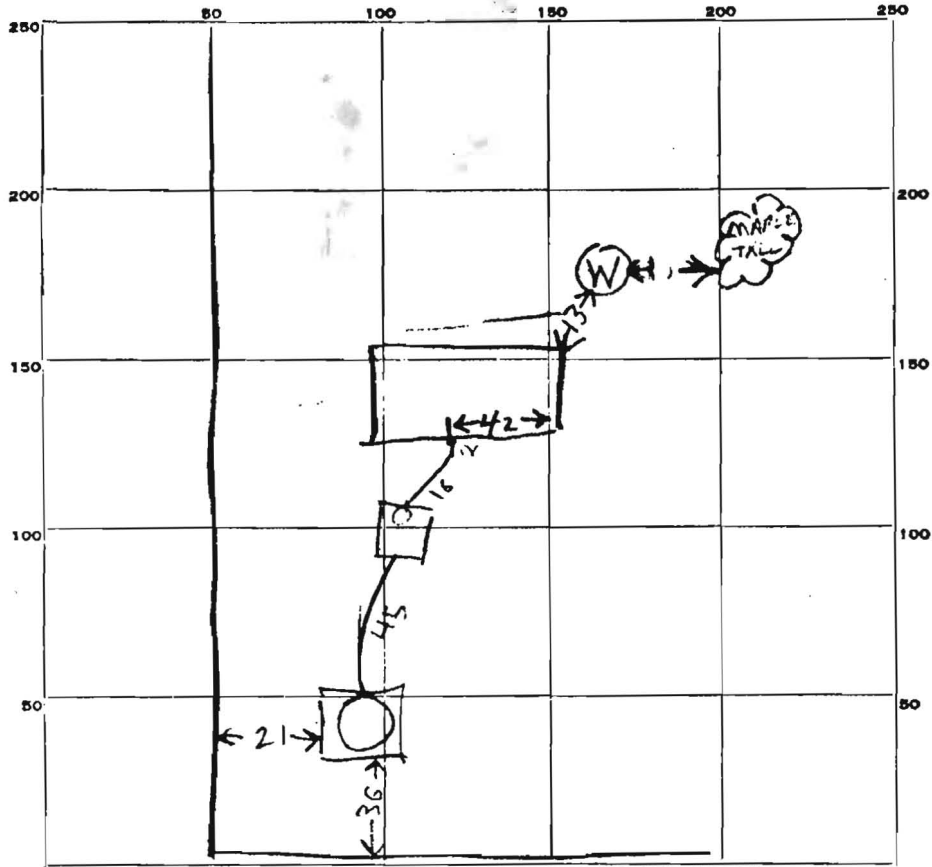

INDICATE NORTH. - NAME ADJOINING ROADWAY AS BASE LINE.

13
15
15
58

PERMIT CARD _____

SEPTIC TANK, LEVEL DIK 1000 CLEANOUTS DI-

8 ft 3 in below 1075000
DISTRIBUTION BOX, LEVEL _____

TILE FIELD, DEPTH _____ FT. TRENCH WIDTH _____ FT.

GRAVEL DEPTH _____ IN. TOTAL LENGTH _____ FT.

NUMBER OF TRENCHES _____ TOTAL BOTTOM AREA _____

SEEPAGE PITS, INSIDE DIAMETER 12 FT. DEPTH BELOW INLET 10 FT.

ABSORBENT AREA 370 SQ. FT. 550 counting stone

REMARKS 16 AUG 57 - Drilled well at 4 FT below ground
Remained in well at 5 FT
4 BE 2 1/2 in pipe - 1000 ft needed

DATE SYSTEM APPROVED 100 PM
16 AUG 57 INSPECTOR [Signature]