

APPLICATION

SEWAGE DISPOSAL TESTING

MARYLAND STATE DEPARTMENT OF HEALTH

HOWARD COUNTY

A 14166

P _____

ELLICOTT CITY

DISTRICT 2

DATE 12/5/68

TO: THE COUNTY HEALTH OFFICER
ELLICOTT CITY, MARYLAND

I, HEREBY, APPLY FOR THE NECESSARY TESTS IN ORDER TO CONSTRUCT (OR RECONSTRUCT) A SEWAGE DISPOSAL SYSTEM.

PROPERTY OWNER James Combs

ADDRESS Sunset Farm Rd. PHONE 465-3816

PROPERTY LOCATION:

SUBDIVISION _____ LOT NO. _____

ROAD AND DESCRIPTION Sunset Farm Rd., Ellicott City, Md. (310' from Rt. 99)

OCCUPANT _____ PHONE _____

PERSON TO CONSTRUCT SYSTEM _____

ADDRESS _____ PHONE _____

SIZE OF LOT Approx. 360' x 85' TYPE BLDG. Testing
NUMBER OF BEDROOMS 3

IF NOT SINGLE RESIDENCE DESCRIBE _____

SIGNATURE OF APPLICANT Lucille E. Carroll

APPROVED BY _____ FOR _____ DATE _____
(KIND OF SYSTEM)

REJECTED BY _____ FOR _____ DATE _____
(KIND OF SYSTEM)

HOLD PENDING FURTHER TESTS BA DATE DEC 68

REASONS FOR REJECTION OR HOLDING DEC 68 L.H.P.

THIS IS NOT A PERMIT

APPLICATION

SEWAGE DISPOSAL TESTING

MARYLAND STATE DEPARTMENT OF HEALTH

HOWARD COUNTY

A 14166

P _____

ELLICOTT CITY

DISTRICT 2

DATE 12/5/68

TO: THE COUNTY HEALTH OFFICER
ELLICOTT CITY, MARYLAND

I, HEREBY, APPLY FOR THE NECESSARY TESTS IN ORDER TO CONSTRUCT (OR RECONSTRUCT) A SEWAGE DISPOSAL SYSTEM.

PROPERTY OWNER James Combs

ADDRESS Sunset Farm Rd. PHONE 465-3816

PROPERTY LOCATION:

SUBDIVISION _____ LOT NO. _____

ROAD AND DESCRIPTION Sunset Farm Rd., Ellicott City, Md. (310' from Rt. 99)

OCCUPANT _____ PHONE _____

PERSON TO CONSTRUCT SYSTEM _____

ADDRESS _____ PHONE _____

SIZE OF LOT Approx. 360' x 85' TYPE BLDG. Apartment
NUMBER OF BEDROOMS 3

IF NOT SINGLE RESIDENCE DESCRIBE _____

SIGNATURE OF APPLICANT Lucille E. Curall


APPROVED BY _____ FOR _____ DATE _____
(KIND OF SYSTEM)

REJECTED BY _____ FOR _____ DATE _____
(KIND OF SYSTEM)

HOLD PENDING FURTHER TESTS BA DATE 11 DEC 68

REASONS FOR REJECTION OR HOLDING 11 DEC 68 L.H. Curall

THIS IS NOT A PERMIT

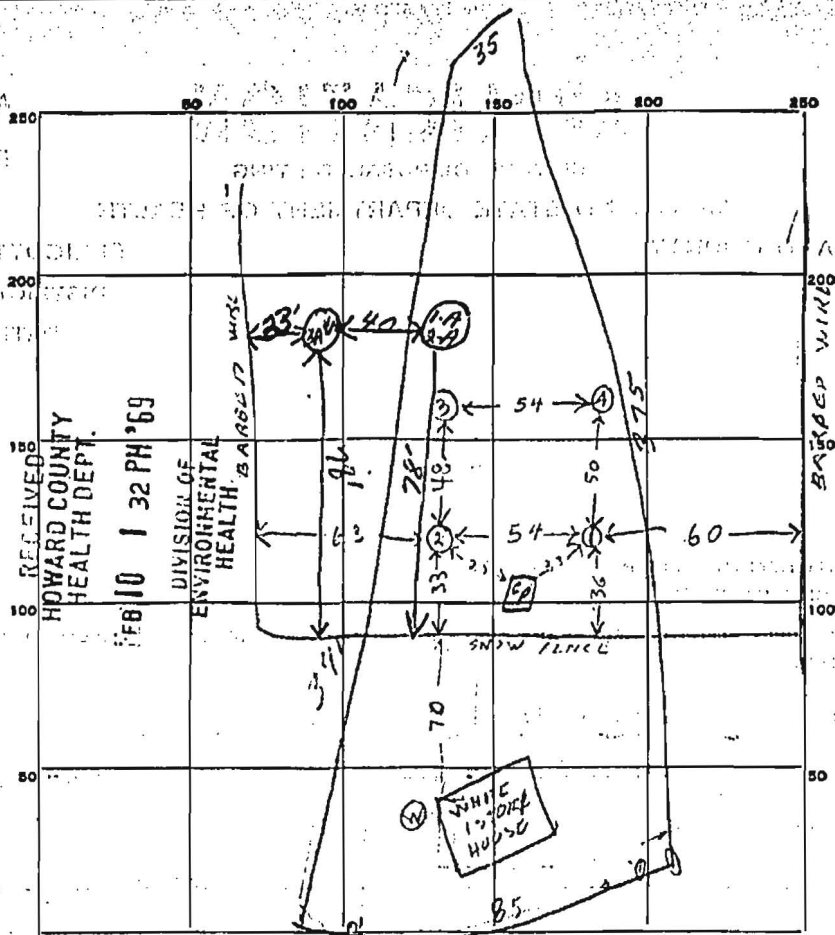

☐ = Cess pool
 (W) = Well

INDICATE NORTH. - NAME ADJOINING ROADWAY AS BASE LINE.

SUNSET FARM RD TO Route 99 →

DATE	TEST NO.	DEPTH	PRE-WET		TEST - 1" DROP		TIME
			START	STOP	START	STOP	
11 DEC 68	1	3	1014	1100	1014	1100	
"	2	3	1016	1100	"	"	
"	3	3	1017	1100	"	"	
"	4	3	1017	1100	"	"	
	1A	10'	203	205	205	209	4 min
	2A	4'	210	219	219	243	24 min 38 min
	3A	10'	215	219	219	233	4 min 10 min
	4A	4'	225	230	230	234	6 min AU

SOIL AUGER FINDING

TESTED BY R. W. Dodge 11 DEC 68 1/27/69 JWW
 REMARKS Lot tested 1954 & passed Cess Pool installed. Not to be used for water to obtain adjacent lot to