

2/3/69 *inspected*
inspector

Bldg. permit in his.

PERMIT

SEWAGE DISPOSAL SYSTEM

P 14245
A 522068-H
24266

MARYLAND STATE DEPARTMENT OF HEALTH

2/10/69

HOWARD COUNTY

ELLICOTT CITY

DISTRICT 2

INDEXED

DATE 1/30/69

Patrick K. Carroll (Calvin Smith installer) IS PERMITTED TO INSTALL ALTER
ADDRESS 3 Hale Haven Drive, Ellicott City, Md. PHONE 465-2150

A SEWAGE DISPOSAL SYSTEM LOCATED AT _____

SUBDIVISION _____ ROAD 2425 Sunset Farm Rd. LOT _____
310' from Rt. 99

PROPERTY OWNER James Combs Rt 99, West of Belchamps

ADDRESS _____

SPECIFICATIONS - 3 bedrooms

**BUILDING PERMIT SIGN
AND RETURNED**

DRAIN FIELD _____ DEPTH _____ FEET, BOTTOM AREA 2/27/69 FT. 800151772-LAR

SEEPAGE PITS _____ ABSORBENT SIDE-WALL AREA _____ SQ. FT.

SEPTIC TANK CAPACITY 750 GALLONS

FOR GARBAGE GRINDER, INCREASE DISPOSAL AREA 22% & TANK CAPACITY 50%.

OTHER Dry well to be 336 sq. ft. of absorbent sidewall area below the inlet pipe with a maximum depth of 12 ft. Locate dry well 33 ft. from left fence and 78 ft. from fence behind house (snow fence) as lot is seen from standing in rear of house looking at fenced in lot.

PERMIT VOID AFTER THREE YEARS.


PLANS APPROVED BY James T. Wright DATE 1/27/69

FILL SEPTIC TANK AND DISTRIBUTION BOX WITH WATER BEFORE CALLING FOR AN INSPECTION. COVER NO. WORK UNTIL INSPECTED AND APPROVED.

NEITHER THE HOWARD COUNTY COMMISSIONERS NOR THE HEALTH DEPARTMENT IS RESPONSIBLE FOR THE SUCCESSFUL OPERATION OF ANY SYSTEM.

**NOTIFY THE HEALTH DEPARTMENT 48 HOURS
BEFORE EXCAVATIONS ARE TO BE BACK FILLED.**

522068-H

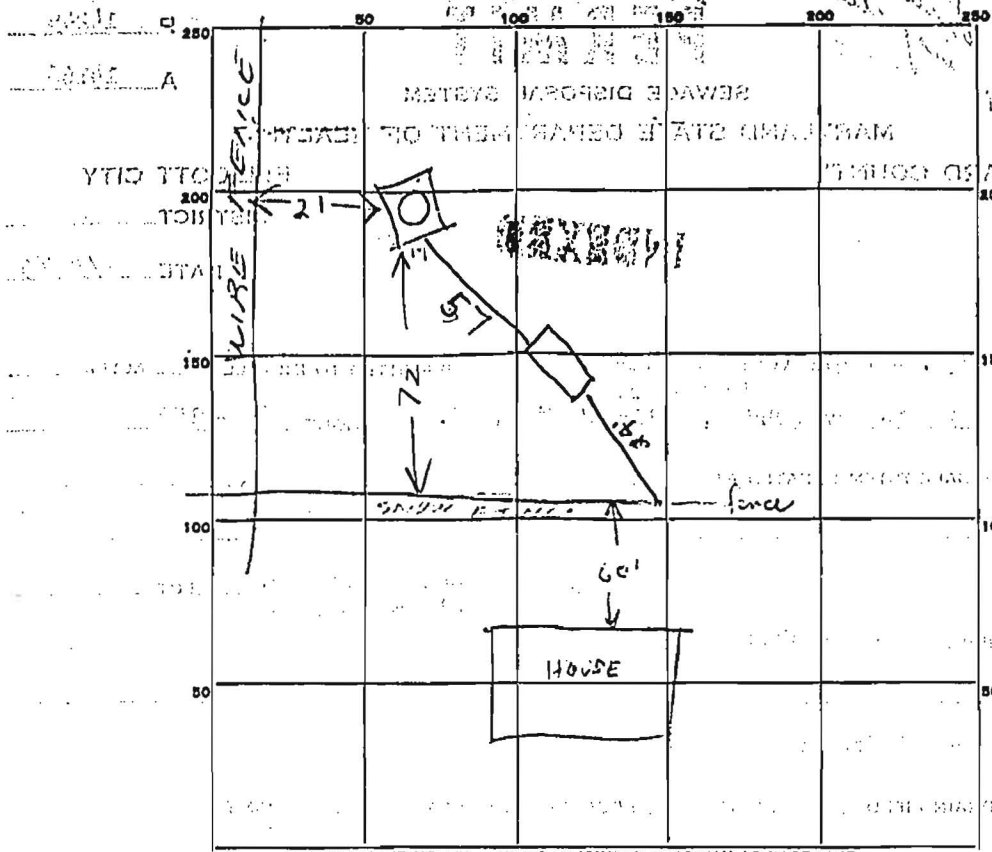

INDICATE NORTH. - NAME ADJOINING ROADWAY AS BASE LINE.

PERMIT CARD

SEPTIC TANK, LEVEL OK concrete CLEANOUTS OK

Top about 2.3 FT below grade

DISTRIBUTION BOX, LEVEL

TILE FIELD, DEPTH _____ FT. TRENCH WIDTH _____ FT.

GRAVEL DEPTH _____ IN. TOTAL LENGTH _____ FT.

NUMBER OF TRENCHES _____ TOTAL BOTTOM AREA _____

SEEPAGE PITS, INSIDE DIAMETER 12 FT. DEPTH BELOW INLET _____ FT.

ABSORBENT AREA 313 SQ. FT. 400 covering stone not covering stone

REMARKS 2/10/69 - Depth below m lid 2 1/2' below m lid

made perimeter of Per Well in 49 FT

Depth below m lid 8 1/2'

DATE SYSTEM APPROVED

INSPECTOR

Raymond Horner

$\frac{10}{3} = 7$

$\frac{37}{85} = 2.06$