

APPLICATION

SEWAGE DISPOSAL TESTING

MARYLAND STATE DEPARTMENT OF HEALTH

HOWARD COUNTY

A 17706

P _____

ELLICOTT CITY

DISTRICT 5th

DATE 11/29/72

TO: THE COUNTY HEALTH OFFICER
ELLICOTT CITY, MARYLAND

I, HEREBY, APPLY FOR THE NECESSARY TESTS IN ORDER TO CONSTRUCT (OR RECONSTRUCT) A SEWAGE DISPOSAL SYSTEM.

PROPERTY OWNER Anne K. Gray and Susie Kondrat

ADDRESS Beaufort Drive, Fulton, Md.

any questions call Mr. G. J.

PHONE Bozell, 776-7025

PROPERTY LOCATION:

SUBDIVISION Beaufort Park

LOT NO. 20, Blk. B, Sec. 4

ROAD AND DESCRIPTION Penelope Court

OCCUPANT _____

PHONE _____

PERSON TO CONSTRUCT SYSTEM _____

ADDRESS _____

PHONE _____

SIZE OF LOT 57,000 s. ft.

TYPE BLDG. 3 or 4 bedrooms
NUMBER OF BEDROOMS

IF NOT SINGLE RESIDENCE DESCRIBE _____

SIGNATURE OF APPLICANT /s/ Anne K. Gray

APPROVED BY _____

FOR _____

(KIND OF SYSTEM)

DATE _____

REJECTED BY _____

FOR _____

(KIND OF SYSTEM)

DATE _____

HOLD PENDING FURTHER TESTS _____

DATE _____


REASONS FOR REJECTION OR HOLDING _____

THIS IS NOT A PERMIT

SITE INSPECTION SHEET

OWNER: _____ PHONE #: _____
ADDRESS: 12404 Penelope Ct CONTRACTOR: _____
WELL TAG #: HO-81-0979
SUBDIVISION: _____ LOT: _____ COUNTY #: _____
PROPOSAL: _____

LOCATION DIAGRAM

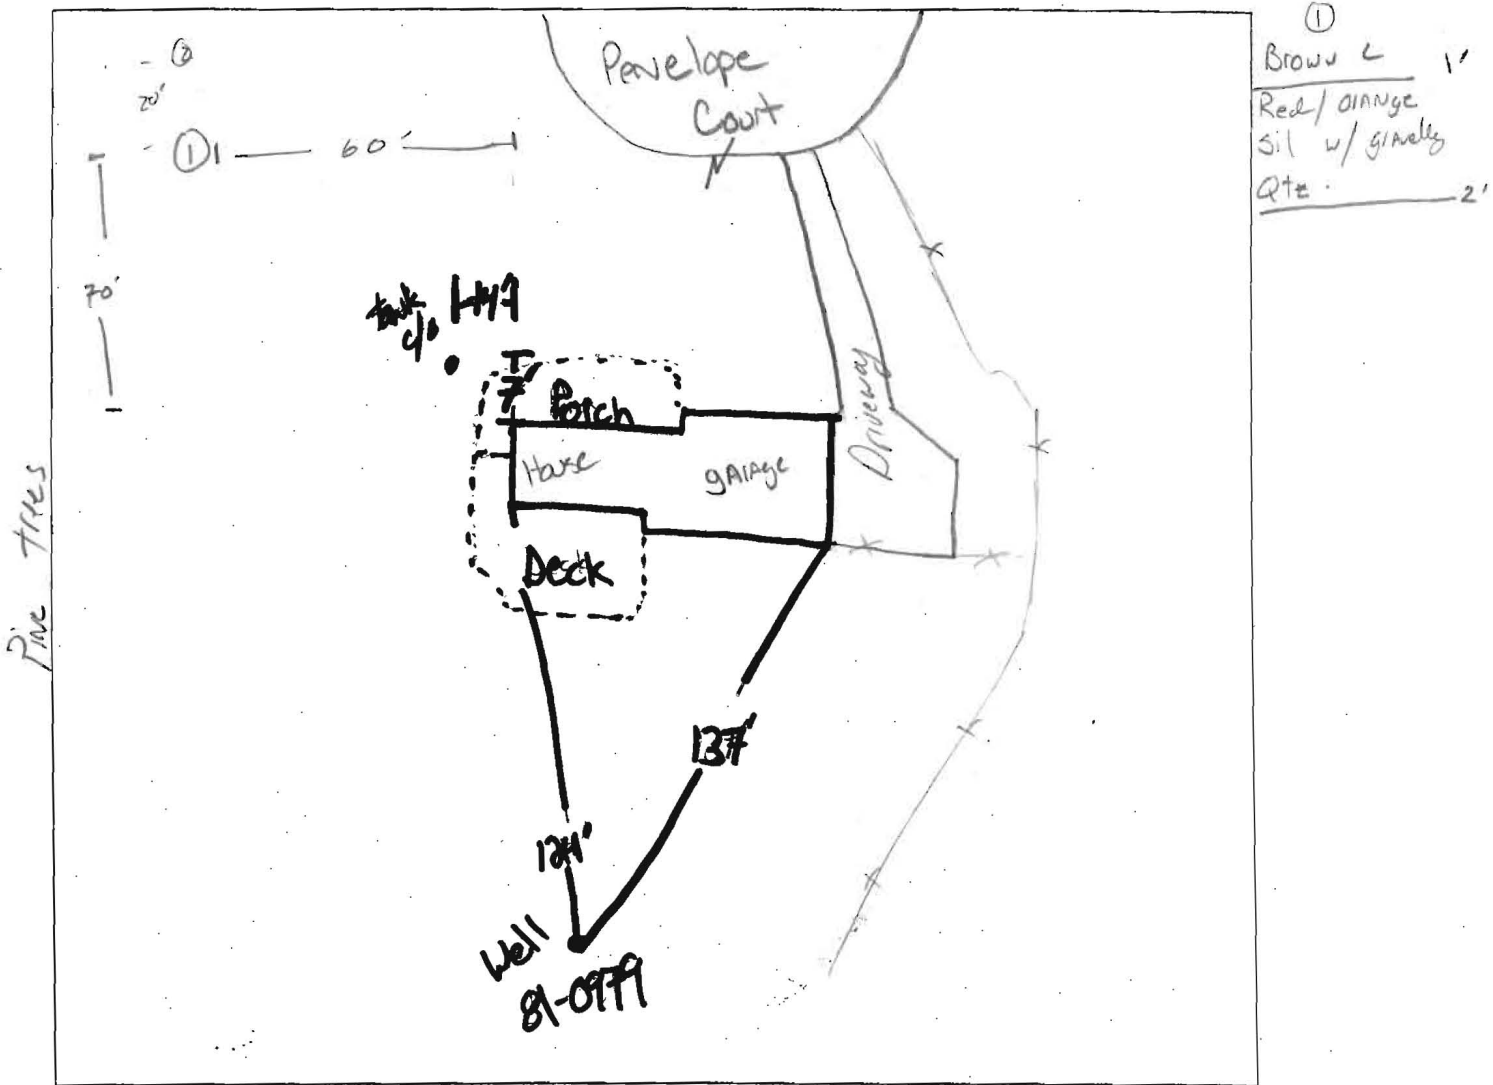

COMMENTS: only could get down 2' - hand auger couldnt get past the Qtz. on hold need a new plan showing additional 20' for SDA

DATE: 8/12/04 INSPECTOR: KTR