

TAX ID# 05-413788

9-4-86
AM
ASHP

7-4-86
Approved
S. Abel

PERMIT

P 37490

A 17766

SEWAGE DISPOSAL SYSTEM

MARYLAND STATE DEPARTMENT OF HEALTH

HOWARD COUNTY

BUREAU OF ENVIRONMENTAL HEALTH

~~XXXXXXXXXX~~
461-9933

ELLICOTT CITY

DISTRICT 5th

DATE 8/12/86

INDEXED

Dennis Feaga IS PERMITTED TO INSTALL ALIIS

ADDRESS 1625 Henryton Road, Marriottsville, MD 21104 PHONE 442-5623

SUBDIVISION Beaufort Park Estates ROAD 12404 Penelope Court LOT 20

PROPERTY OWNER Lawrence C. Gayer, Jr.

ADDRESS _____

IF GARBAGE GRINDER IS USED INCREASE SEPTIC TANK CAPACITY BY 50% AND ABSORPTION AREA BY 22%

GARBAGE GRINDER? YES _____ NO

SEPTIC TANK CAPACITY 1250 GALLONS NUMBER OF BEDROOMS 4

TRENCHES - 150 sq. ft. per bedroom. Trench to be 2 feet wide. Inlet 3 feet below original grade. Bottom maximum depth 7.5 feet below original grade. Effective area begins at 3 feet below original grade. 4.5 feet of stone below distribution pipe.

LOCATION - Place the distribution box or start the trench 35 feet from the right lot line and 100 feet from Penelop Court as seen when facing the lot from Penelope Court. Run trenches on contour toward the left lot line. **NOTE:** Maintain 100 feet from any well with septic tank or trench.

NOTE - No trench to exceed 100 feet in length. If more than one trench used, a distribution box is required. Call for inspection of trench before and after gravel is installed. Provide 6" - 8" diameter cleanout and cap to grade or above on septic tank. *only w*

PLANS APPROVED BY S. Abel DATE 5/26/86

COVER NO WORK UNTIL INSPECTED AND APPROVED

NEITHER THE HOWARD COUNTY COUNCIL NOR THE HEALTH DEPARTMENT IS RESPONSIBLE FOR THE SUCCESSFUL OPERATION OF ANY SYSTEM

NOTE IF TRENCH IS USED CALL FOR INSPECTION BEFORE AND AFTER PLACING GRAVEL IN TRENCH

NOTE NO DRY WELL SHALL EXCEED 15 FOOT IN DIAMETER. NO ABSORPTION TRENCH TO EXCEED 100 FEET IN LENGTH

NOTE ALL PIPE FROM HOUSE TO SEPTIC TANK MUST BE CAST IRON OR SCHEDULE 40 PVC OR ABS

PERMIT VOID AFTER THREE YEARS

NOTE INSTALL STAND PIPE ON SEPTIC TANK AND DRY WELL. STAND PIPES MUST BE 6 INCHES IN DIAMETER. CAST IRON, CONCRETE OR TERRA COTTA OR PVC OR ABS ACCEPTED. IF TOP OF SEPTIC TANK IS DEEPER THAN 3 FEET MANHOLE TO GRADE REQUIRED


***INSTALLER IS RESPONSIBLE FOR OBTAINING FINAL APPROVAL ON THIS PERMIT**

*CALL 992 2330 FOR INSPECTION OF SEPTIC SYSTEMS

EH 2 1082

A 1100

522068-K

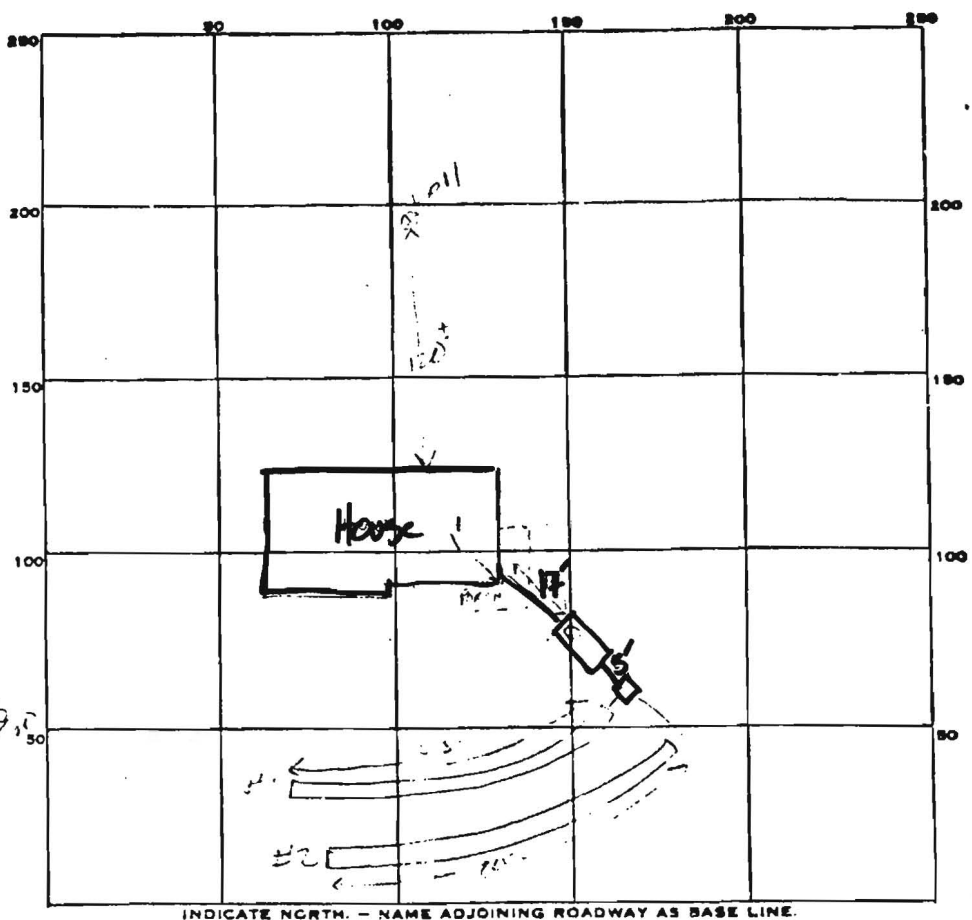

INDICATE NORTH - NAME ADJOINING ROADWAY AS BASE LINE.
PENNSYLVANIA

PERMIT CARD _____

SEPTIC TANK, LEVEL 1500 GAL ✓ CLEANOUTS ✓ 5T

DISTRIBUTION BOX, LEVEL ✓

TILE FIELD, DEPTH 7.5 FT FT. TRENCH WIDTH 2 FT. DIR 8"

GRAVEL DEPTH 4.5 FT IN. TOTAL LENGTH 100 FT. TOTAL 145

NUMBER OF TRENCHES 2 TOTAL BOTTOM AREA 150.54

SEEPAGE PITS, INSIDE DIAMETER _____ FT. DEPTH BELOW INLET _____ FT.

ABSORBENT AREA 1500 SQ. FT.

REMARKS 2.4.15

DATE SYSTEM APPROVED _____ INSPECTOR _____