


150.00

A 22316

Copy plane lot 4

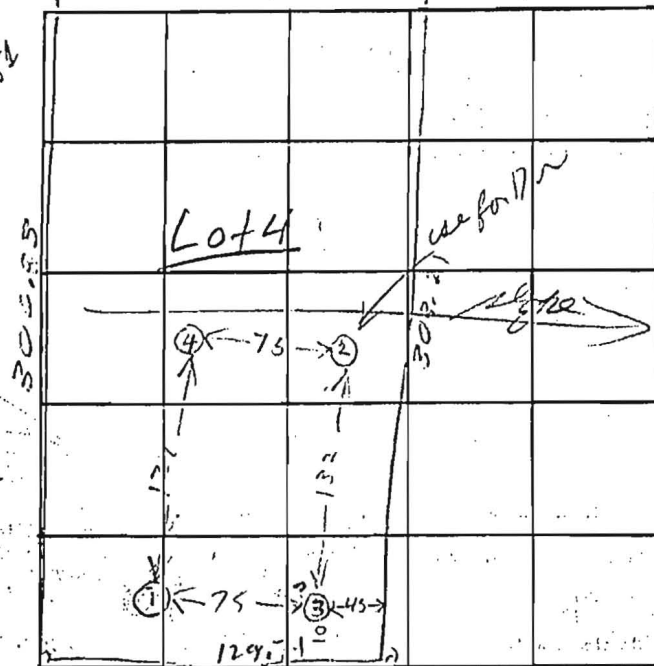

BP # 5-4573
318 75 shop Rd
lot 4 sec 3

42,113 sq ft

INDICATE NORTH - NAME ADJOINING ROADWAY AS BASE LINE.
TOP OVER MILLER SHARP RD

	DATE	TEST NO.	DEPTH	PRE-WET		TEST - 1" DROP		TIME
				START	STOP	START	STOP	
TOP 4 1/2 clay	10/23/75	1	12 1/2	142	147	147	156	9
		1A	5 1/2	142	144	144	147	3
TOP 5 1/2 clay		2	11 1/2	149	154	154	202	8
		2A	6	149	154	154	159	5
TOP 5 1/2 clay		3	12	157	200	200	206	6
	10/23/75	3A	6 1/2	157	200	200	205	5
		4	11 1/2	TOP 207	5K 6 1/2	CL 7 SA	174	177

air time 6
max depths

132

REMARKS

TYPE OF SOIL

TESTED BY RHOFS

ALSO PRESENT: *Resonance Peak*
Proctor