

513567-E


COUNTY #

SOIL PROFILE
134A

0" Topsoil
8" brown-orange sandy clay loam
3' tan sandy loam (fine)
10% saprolite

12' 130A
0" Topsoil
6" orange-brown clay loam
3' reddish brown sandy loam
50% saprolite
13'

128A
0" Topsoil
4" red-brown clay loam
3' reddish brown sandy loam (fine)
5% saprolite
13'

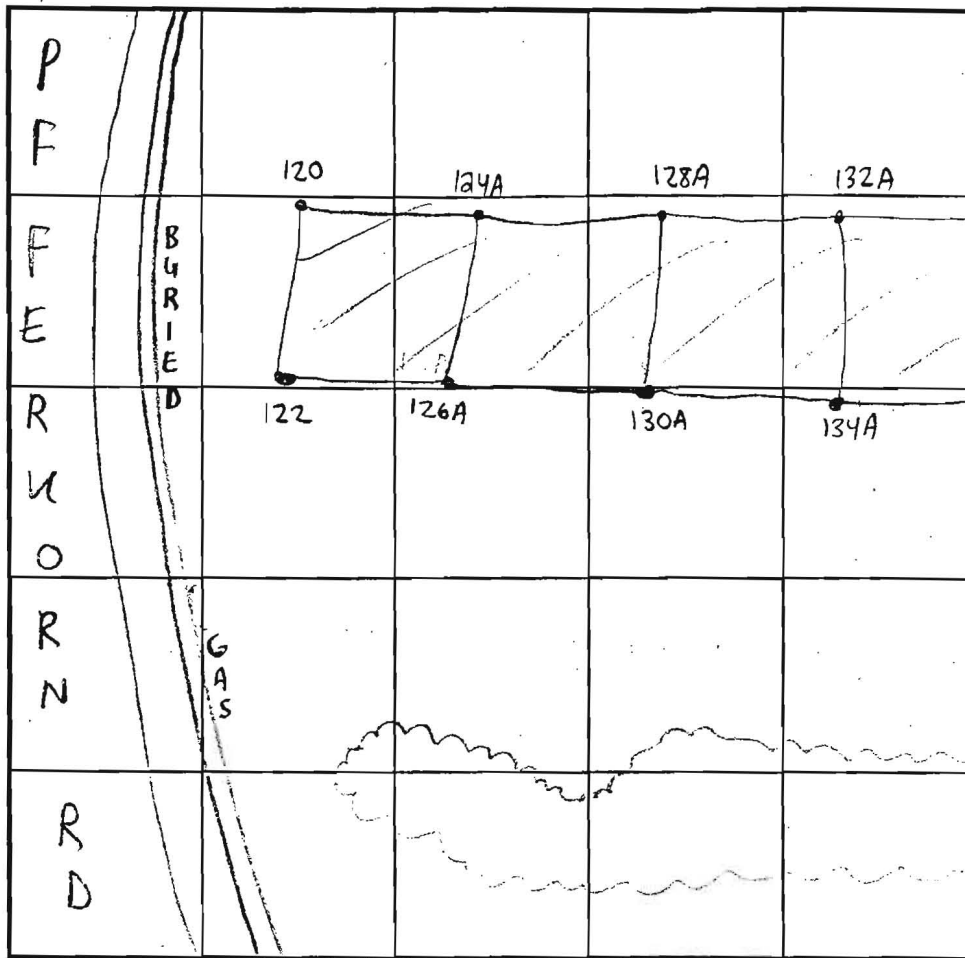

SOIL PROFILE
124A

0" Topsoil
6" red brown clay loam
3' reddish brown sandy loam
15-20% Saprolite
13'

INDICATE NORTH - NAME ADJOINING ROADWAY AS BASE LINE.

DATE	TEST NO.	DEPTH	PRE-WET		TEST - 1" DROP		TIME
			START	STOP	START	STOP	
6-26-00	134A	4' F	2:12pm	2:13pm	2:13pm	2:15pm	2min
		12' V	(SEE SOIL PROFILE)				OK
6-27-00	130A	4.5' F	10:18am	10:20am	10:20am	10:22am	2min
		13' V	(SEE SOIL PROFILE)				OK
	128A	4' F	10:30am	10:32am	10:32am	10:33am	OK
		13' V	(SEE SOIL PROFILE)				OK
	124A	4' F	10:36am	10:38am	10:38am	10:41am	3min
		13' V	(SEE SOIL PROFILE)				OK

REMARKS Soil pits consistent

TYPE OF SOIL Chester

TESTED BY Steven R. Krieg ALSO PRESENT Chuck Zepp and Robert Colson

TRENCH DESIGN DATA: AVERAGE PERCOLATION TIME _____ TRENCH WIDTH _____


INLET DEPTH _____ MAXIMUM BOTTOM DEPTH _____ SQ. FT./BEDROOM _____

OF WAY

F-03045
signed 8/4/04

WILLIAM ROBERT'S PFEFFERKORN
537/221

NATURAL CONSERVATION AREA AND
FOREST CONSERVATION AREA B
(NON-BUILDABLE)(SHADED)
8.59 AC.±

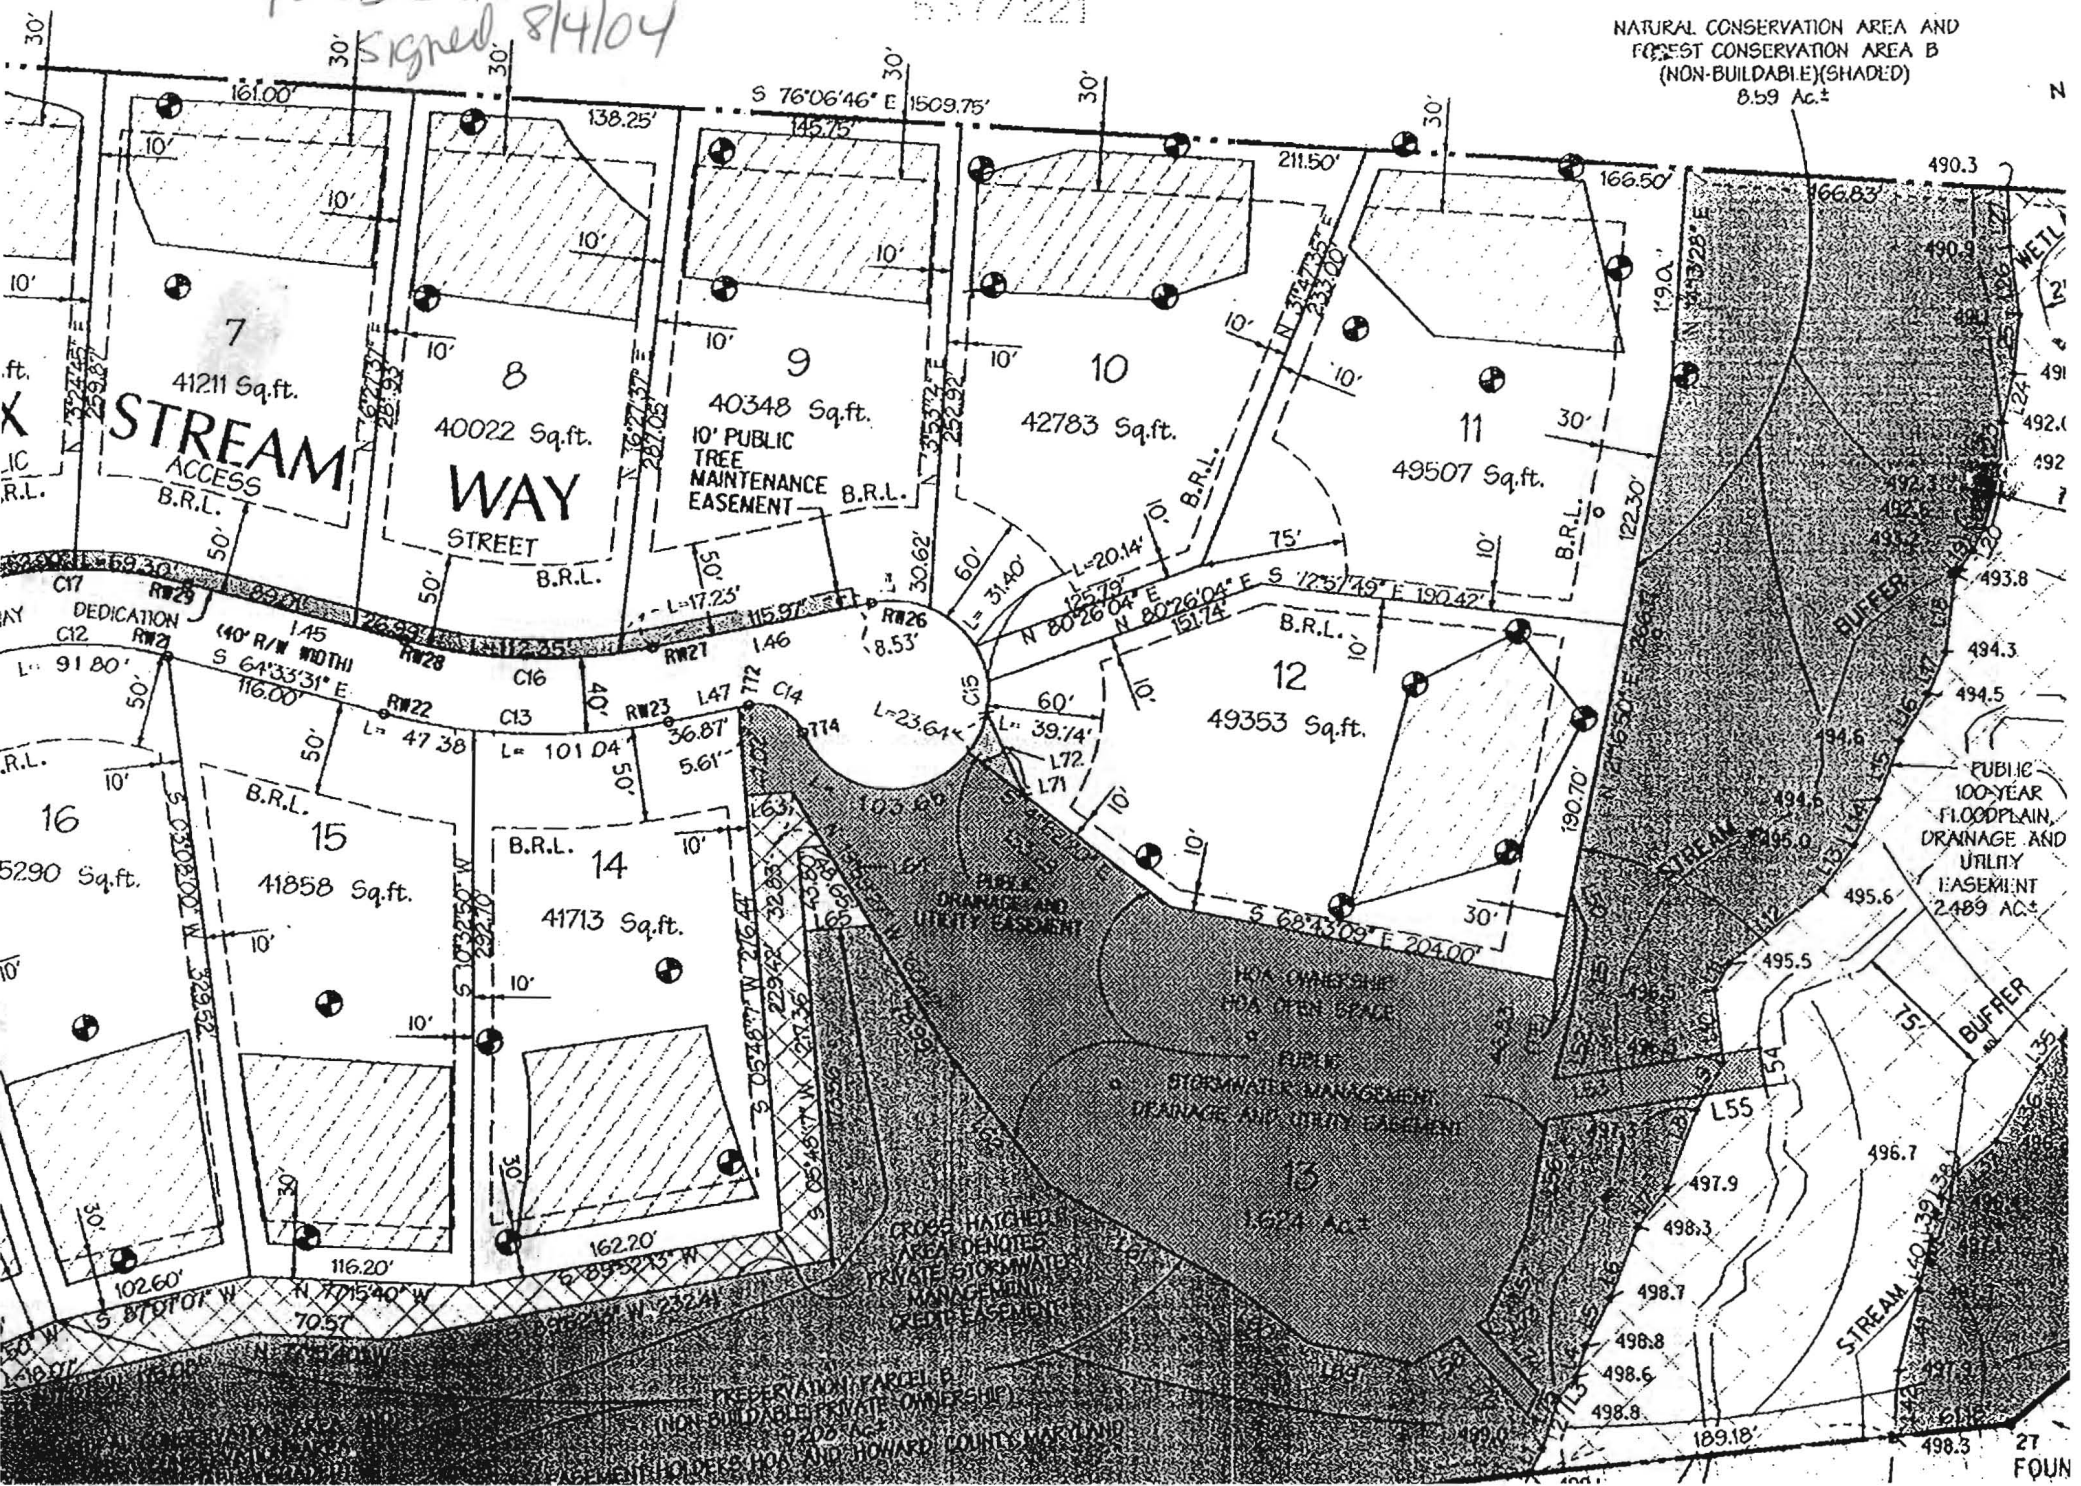

SBARRA MARK G
MONTGOMERY CATHELINE A J/T
5532/406
P.1695


PRES.
PARCEL A
(NON-BUILDABLE)

VER RD.

PROPOSED
PUBLIC
ACCESS

PLACE

PEEEF

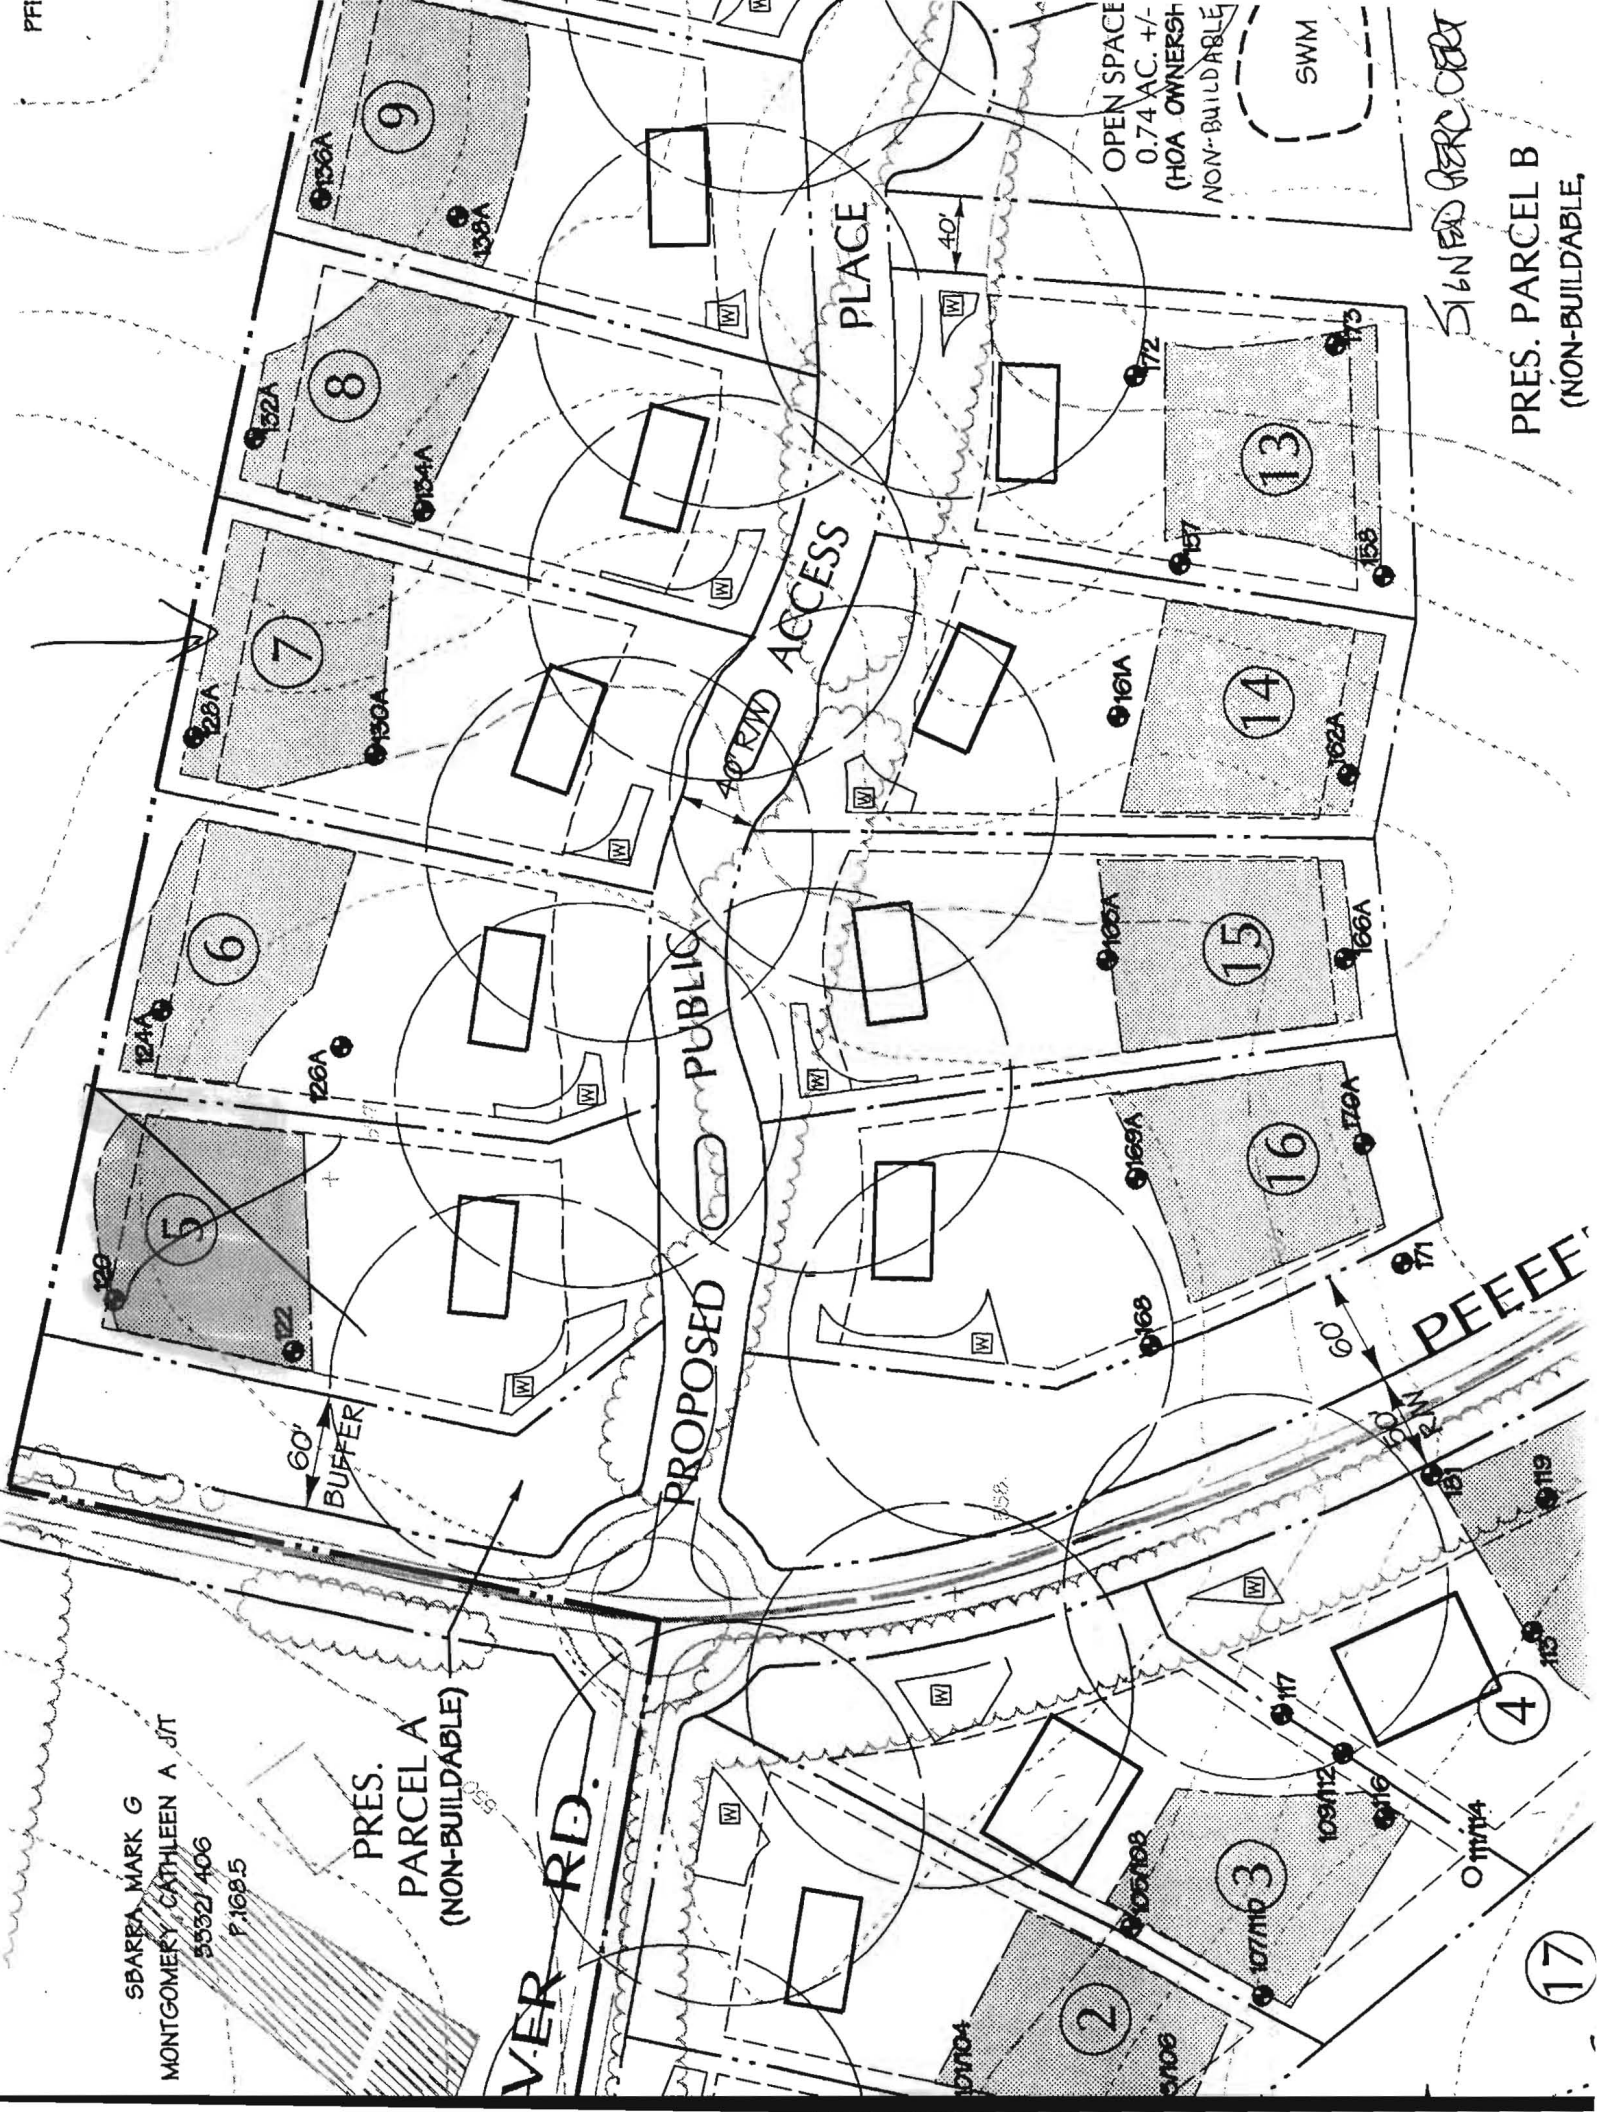

PRES. PARCEL B
(NON-BUILDABLE)

SIGNED PERC CERT

OPEN SPACE
0.74 AC. +/-
(HOA OWNERSH
NON-BUILDABLE)

SWM

17

4

3

2

103112

103116

103117

113

115

117

119

121

122

124

126A

128A

130A

132A

134A

136A

138A

140A

142A

144A

146A

148A

150A

160A

162A

164A

166A

168A

170A

172

174

176

744