


BARBARA
CIRCLE
(50' R/W)

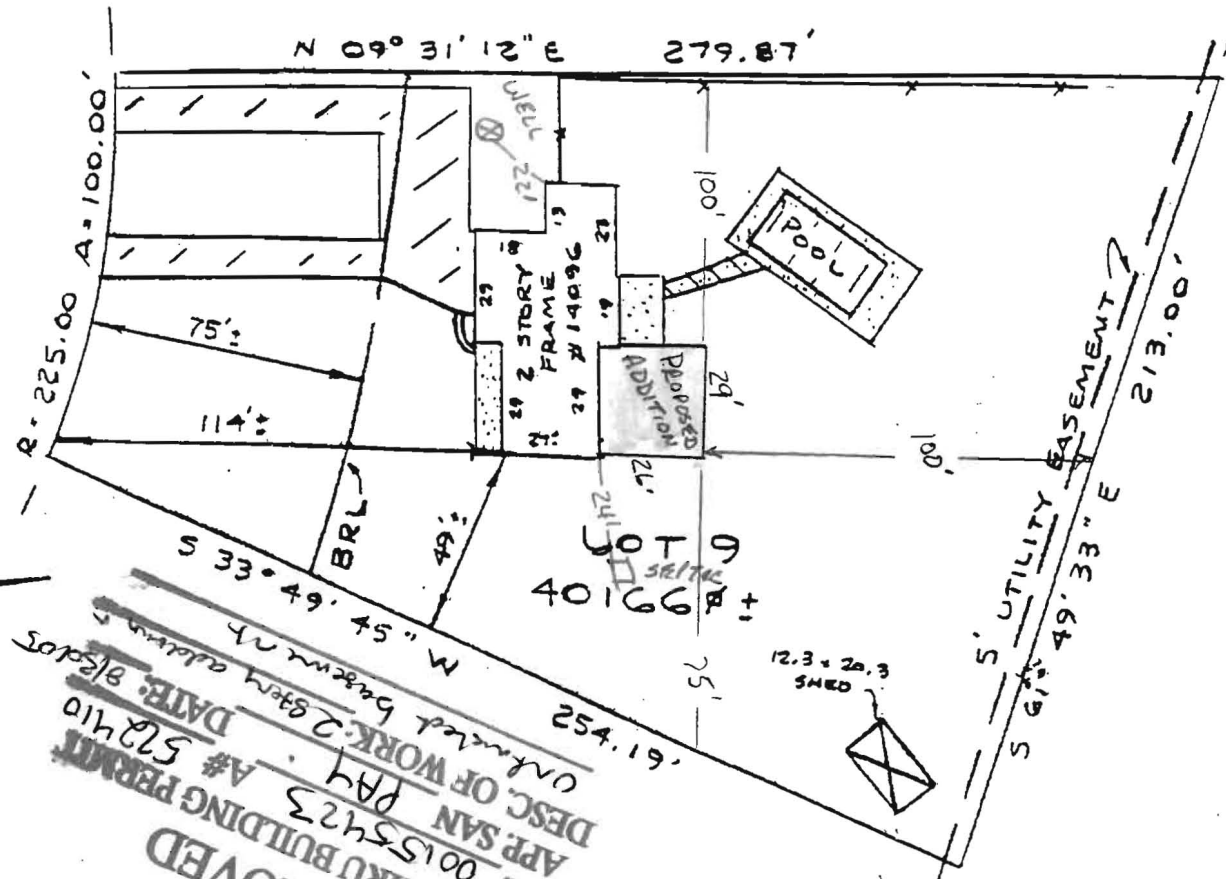

PROTECT: 26' x 29' Two Story Addition
w/ UNFINISHED BASEMENT

APPROVED
WALK-THRU BUILDING PERMIT
BP# 00155423
APP SAN PAY # 522410
DATE: 8/5/05
DESC. OF WORK: 2 story addition
w/ unfinished basement

LOCATION SURVEY

14096 BARBARA CIRCLE
VILLA MONTICELLO
4th ELECTION DISTRICT
HOWARD COUNTY, MD


THIS PLAT SHOWS ONLY THAT THE IMPROVEMENTS ARE
CONTAINED WITHIN THE OUTLINES OF THE LOT AND
IS NOT TO BE USED TO ESTABLISH PROPERTY LINES.

NTI ASSOCIATES INC. 16205 OLD FREDERICK ROAD
MT. AIRY, MARYLAND PHONE 646-5521 or 442-2031

This is to certify that I have surveyed the property known as lot #
9, 14096 BARBARA CIRCLE
sheet of recorded PLAT BK 21 No. 62 among the
land records of HOWARD County, Maryland for the purpose
of locating the improvements thereon.



BARBARA
CIRCLE
(50' R/W)

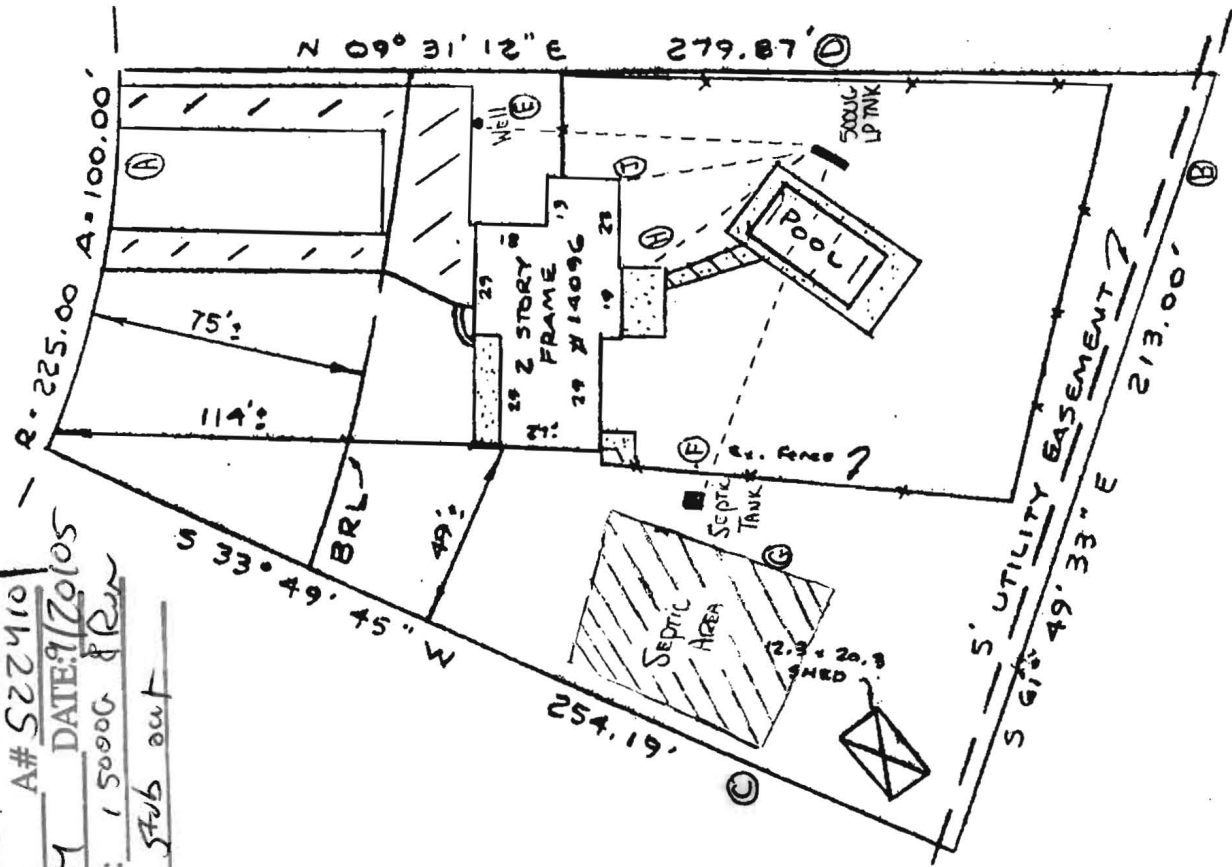

APPROVED

WALK-THRU BUILDING PERMIT

BP# 80056049 A# S22410

APP. SAN PA.7 DATE: 9/20/05

DESC. OF WORK: 1 5000G LP TANK

line to sub out

LOCATION SURVEY

14096 BARBARA CIRCLE
VILLA MONTICELLO
4th ELECTION DISTRICT
HOWARD COUNTY, MD

THIS PLAT SHOWS ONLY THAT THE IMPROVEMENTS ARE CONTAINED WITHIN THE OUTLINES OF THE LOT AND IS NOT TO BE USED TO ESTABLISH PROPERTY LINES.

NTT ASSOCIATES INC. 16205 OLD FREDERICK ROAD
MT. AIRY, MARYLAND PHONE 646-5521 or 442-2031

SCALE 1" = 50'
DATE 7/29/86

FIELD BY JLM
DRAWN BY JLM

DRAWING NUMBER
DB


This is to certify that I have surveyed the property known as lot # 9, 14096 BARBARA CIRCLE sheet of recorded PLAT BK 21 NO. 62 among the land records of HOWARD County, Maryland for the purpose of locating the improvements thereon.

James Carl Hudgins

J. Carl Hudgins PLS #96



BARBARA
CIRCLE
(50' R/W)

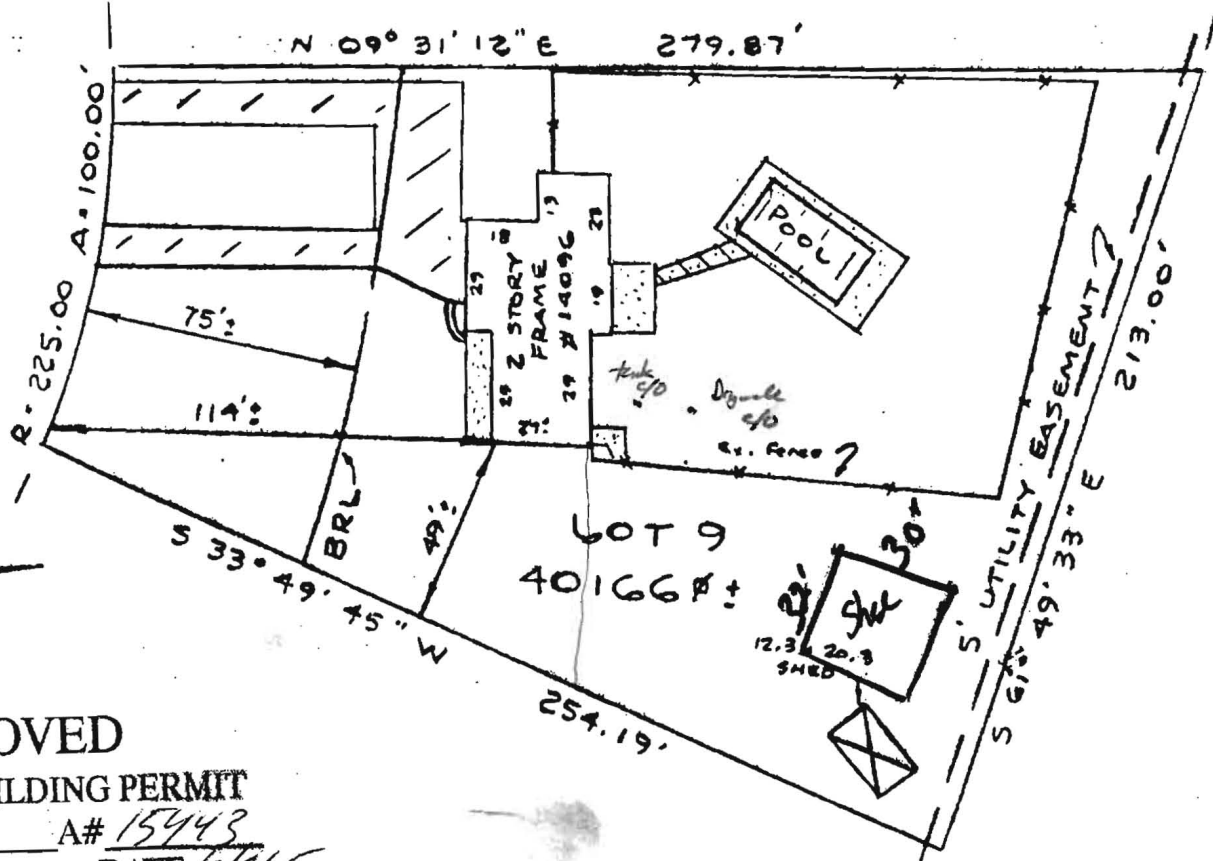

APPROVED

WALK-THRU BUILDING PERMIT

BP# _____ A# 15443
 APP. SAN KSB DATE 7/29/86
 DESC. OF WORK: Shed
30x32'

LOCATION SURVEY

14096 BARBARA CIRCLE
 VILLA MONTICELLO
 4th ELECTION, DISTRICT
 HOWARD COUNTY, MD

THIS PLAT SHOWS ONLY THAT THE IMPROVEMENTS ARE
 CONTAINED WITHIN THE OUTLINES OF THE LOT AND
 IS NOT TO BE USED TO ESTABLISH PROPERTY LINES.

NTT ASSOCIATES INC, 16205 OLD FREDERICK ROAD
 MT. AIRY, MARYLAND PHONE 646-5521 or 442-2031

SCALE 1" = 50'
 DATE 7/29/86

FIELD BY JLM
 DRAWN BY JLM

DRAWING NUMBER
 153


This is to certify that I have surveyed the property known as lot #
 9, 14096 BARBARA CIRCLE
 sheet of recorded PLAT BK 21 NO. 62 among the
 land records of HOWARD County, Maryland for the purpose
 of locating the improvements thereon.

James Carl Hudgins

J. Carl Hudgins PLS #96



BARBARA
CIRCLE
(50' R/W)

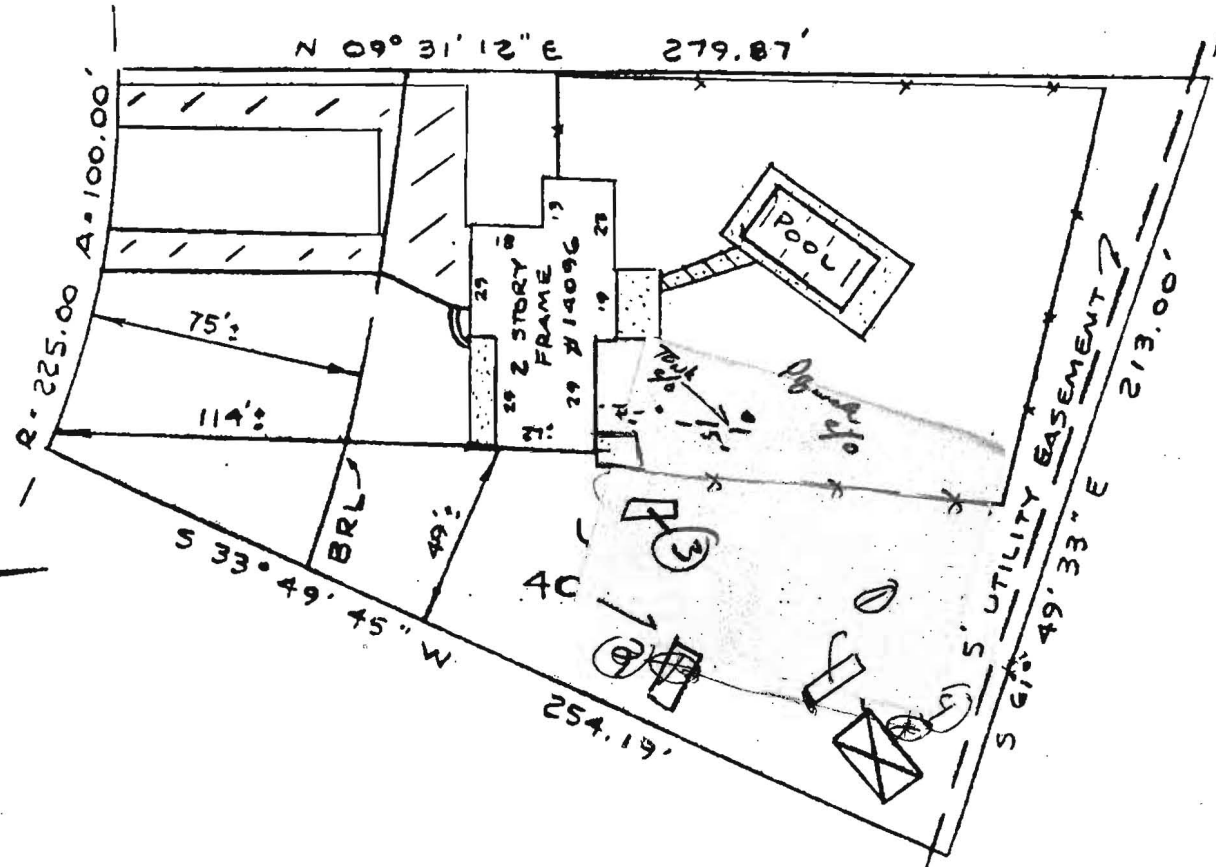

LOCATION SURVEY

14096 BARBARA CIRCLE
VILLA MONTICELLO
4th ELECTION DISTRICT
HOWARD COUNTY, MD

THIS PLAT SHOWS ONLY THAT THE IMPROVEMENTS ARE
CONTAINED WITHIN THE OUTLINES OF THE LOT AND
IS NOT TO BE USED TO ESTABLISH PROPERTY LINES.

NTT ASSOCIATES INC, 16205 OLD FREDERICK ROAD
MT. AIRY, MARYLAND PHONE 646-5521 or 442-2031

SCALE 1" = 50'
DATE 7/29/86

FIELD BY JLM
DRAWN BY JLM



DRAWING NUMBER
DB

This is to certify that I have surveyed the property known as lot #
9, 14096 BARBARA CIRCLE
sheet of recorded PLAT BK 21 No. 62 among the
land records of HOWARD County, Maryland for the purpose
of locating the improvements thereon.

James Carl Hudgins

J. Carl Hudgins PLS #96



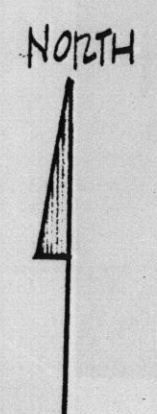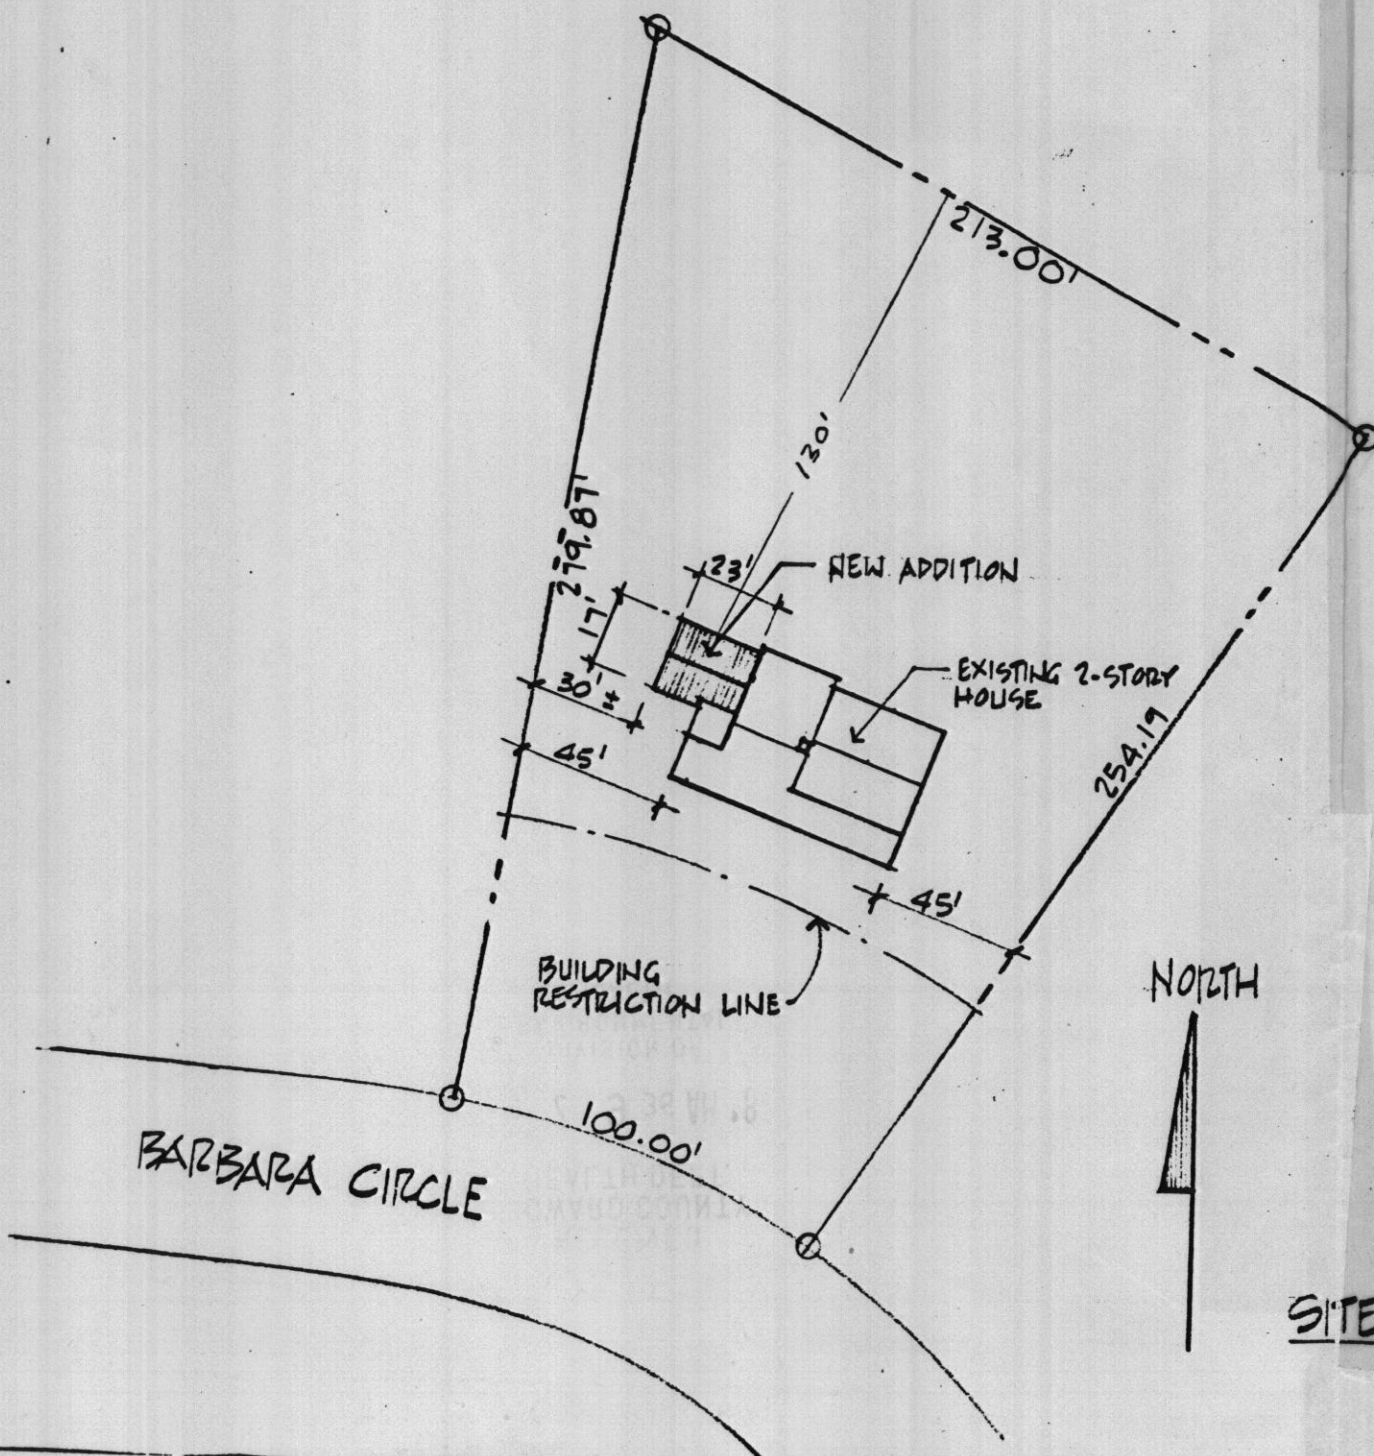

SITE PLAN

SECURITY BUILDERS <i>The most important thing we build is trust.</i>		6660 SECURITY BOULEVARD WEST WING BALTIMORE, MARYLAND 21207 PHONE: (301) 265-8000	
		SCALE: 1" = 50'-0" DATE: Nov. 23, 82	APPROVED BY: _____
ROOM ADDITION FOR MR. & MRS. W. POWERS			
14090 BARBARA CIRCLE COOKSVILLE, MD. 21723		SHEET 1 of 4	