

# APPLICATION

PERCOLATION TESTING

A 39165

P \_\_\_\_\_

HOWARD COUNTY HEALTH DEPARTMENT  
BUREAU OF ENVIRONMENTAL HEALTH  
P.O. BOX 476 ELLICOTT CITY, MARYLAND 21043  
TELEPHONE: 461-9933

DISTRICT 5

DATE 4/2/87

TO: THE COUNTY HEALTH OFFICER  
ELLICOTT CITY, MARYLAND

I, HEREBY, APPLY FOR THE NECESSARY TEST IN ORDER TO CONSTRUCT (OR RECONSTRUCT) A SEWAGE DISPOSAL SYSTEM.

PROPERTY OWNER ~~W.L. Research, Inc.~~ Hilltop Development Corp.

ADDRESS 7625 Brown Bridge Road PHONE \_\_\_\_\_

PROSPECTIVE BUYER Richard J. Demmitt

ADDRESS P.O. Box 208, Clarkeville, Md. 21029 PHONE 301-531-5539

PROPERTY LOCATION:

SUBDIVISION Waterman Estates, Section One LOT NO. 10 ~~LOT 10~~  
~~OPTIONAL~~

ROAD AND DESCRIPTION 7625 Brown's Bridge Road 12440 Petrillo Drive P/O New  
21

TAX MAP 40 PARCEL # 250

SIZE OF LOT 3 acres TYPE BLDG. \_\_\_\_\_  
(SINGLE FAMILY DWELLING OR COMMERCIAL)

THE SYSTEM INSTALLED UNDER THIS APPLICATION IS ACCEPTABLE ONLY UNTIL PUBLIC FACILITIES BECOME AVAILABLE. I FULLY UNDERSTAND THE

FEE CONNECTED WITH THE FILING OF THIS PERC TEST APPLICATION IS NON-REFUNDABLE UNDER ANY CIRCUMSTANCES. I ALSO AGREE TO COMPLY

WITH ALL M.O.S.H.A. REQUIREMENTS IN TESTING THIS LOT. Richard J. Demmitt  
(SIGNATURE OF APPLICANT)

APPROVED BY \_\_\_\_\_ FOR \_\_\_\_\_ DATE \_\_\_\_\_

REJECTED BY \_\_\_\_\_ FOR \_\_\_\_\_ DATE \_\_\_\_\_

HOLD PENDING FURTHER TESTS \_\_\_\_\_ DATE \_\_\_\_\_

REASONS FOR REJECTION OR HOLDING 5/24/87 Pinc. Sanitary - hold for test. SUFF

PERMIT 7/6/87  
AND RETURNED Serial # 26999  
SFD - 3 Bedroom

# THIS IS NOT A PERMIT



# APPLICATION

PERCOLATION TESTING

A 47655  
P \_\_\_\_\_

HOWARD COUNTY HEALTH DEPARTMENT  
BUREAU OF ENVIRONMENTAL HEALTH  
P.O. BOX 476 ELLICOTT CITY, MARYLAND 21043  
TELEPHONE 461-9933

DISTRICT 5th  
12/05/91  
DATE 10/25/91

TO: THE COUNTY HEALTH OFFICER  
ELLICOTT CITY, MARYLAND

I, HEREBY, APPLY FOR THE NECESSARY TEST IN ORDER TO CONSTRUCT (OR RECONSTRUCT) A SEWAGE DISPOSAL SYSTEM.

PROPERTY OWNER Potomac Electric Power Company

ADDRESS 1900 Pennsylvania Ave. N.W. Washington DC 20068 PHONE 202-872-3526

PROSPECTIVE BUYER \_\_\_\_\_

ADDRESS \_\_\_\_\_ PHONE \_\_\_\_\_

PROPERTY LOCATION:

SUBDIVISION Waterman Estates LOT NO. 21

ROAD AND DESCRIPTION Brown Bridge Road

TAX MAP 40 PARCEL # \_\_\_\_\_

SIZE OF LOT 3.86 acres TYPE BLDG. Single Family Dwelling  
(SINGLE FAMILY DWELLING OR COMMERCIAL)

THE SYSTEM INSTALLED UNDER THIS APPLICATION IS ACCEPTABLE ONLY UNTIL PUBLIC FACILITIES BECOME AVAILABLE. I FULLY UNDERSTAND THE FEE CONNECTED WITH THE FILING OF THIS PERC TEST APPLICATION IS NON-REFUNDABLE UNDER ANY CIRCUMSTANCES. I ALSO AGREE TO COMPLY WITH ALL M.O.S.H.A. REQUIREMENTS IN TESTING THIS LOT.

*AKB*

(SIGNATURE OF APPLICANT)

APPROVED BY \_\_\_\_\_ FOR \_\_\_\_\_ DATE \_\_\_\_\_

REJECTED BY \_\_\_\_\_ FOR \_\_\_\_\_ DATE \_\_\_\_\_

HOLD PENDING FURTHER TESTS \_\_\_\_\_ DATE \_\_\_\_\_

REASONS FOR REJECTION OR HOLDING 12/21/91 PERC OK BUT MAY HAVE TO CHANGE LOT LINES & SYSTEM FIRST BECAUSE OF PROXIMITY TO EXISTING WELLB HOLD FOR PLATR *Hodge*


# THIS IS NOT A PERMIT

HD-216

21  
A47655

56  
0 BROWN CLAY  
3 BEIGE FINE SAND LOAM  
12

① SOIL PROFILE  
0 BROWN CLAY  
3 BEIGE FINE SAND LOAM

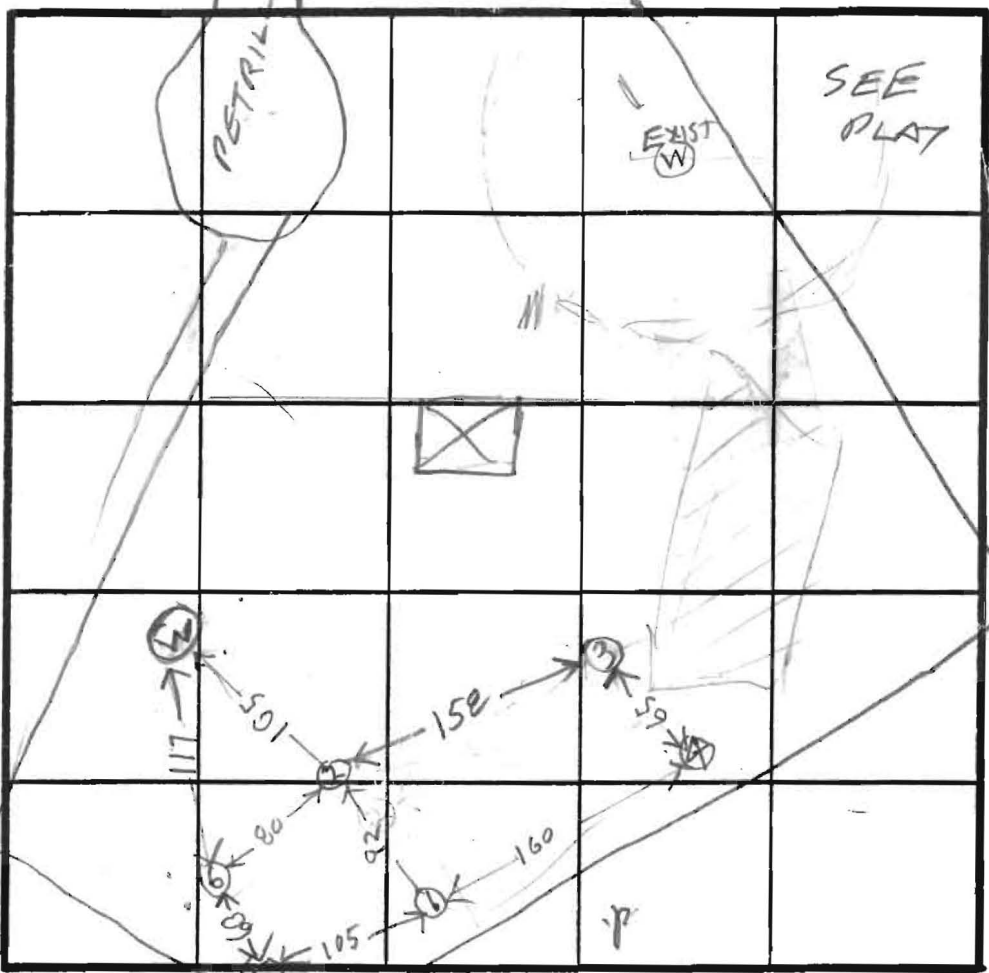

INDICATE NORTH - NAME ADJOINING ROADWAY AS BASE LINE.

② CLAY  
3 GRAY BROWN FINE SAND SILT LOAM

③  
0 BROWN CLAY  
4 GRAY SAND SILT LOAM  
6 1/2 WATER

④  
4 BROWN CLAY  
6 1/2 GRAY SAND SILT LOAM  
7

DATE	TEST NO.	DEPTH	PRE-WET		TEST - 1" DROP		TIME
			START	STOP	START	STOP	
4/19/91	15(306)	4	1137	1139	1139	1142	3
	1V	13	OK	-			
	25(307)	4	1148	1148	1148	1152	4
	2V	13	OK				
	3V	8	WATER 6 1/2 FT		FAIL		
	4V	7	WATER 6 1/2 FT		FAIL		
	5S	3	155	158	158	202	4
	5V	14	OK	OK			
12/19/91	6S	3	156	157	157	158	1
	6V	12	OK				

REMARKS: 2 Holes ①②③④ dug per revised Test Plat Holes ⑤⑥  
Dig differently May Have to Change Last Layer  
TESTED BY: R. HODGES ALSO PRESENT: K. HATFIELD  
Majed ABEDI