

LAYOUT _____ INSP 4 _____
INSP 2 _____ INSP 5 _____
INSP 3 _____ INSP 6 _____

ISSUE DATE: 5/10/2005

APPROVAL DATE: 09/14/2005

PERMIT

INDEXED

TAX ID #05-435420

P 522456

A 513574-N

**ON-SITE SEWAGE DISPOSAL SYSTEM
HOWARD COUNTY HEALTH DEPARTMENT
BUREAU OF ENVIRONMENTAL HEALTH**

Progen Septic Clean Inc IS PERMITTED TO INSTALL ALTER

ADDRESS: 580 Obrech Rd PHONE NUMBER: 410-795-5670

SUBDIVISION: Pindell Woods LOT NUMBER: 14

ADDRESS: 7245 Preservation Court PROPERTY OWNER: Dale Thompson Builders

SEPTIC TANK CAPACITY (GALLONS): 1500 1250 OUTLET Baffle FILTER REQUIRED

PUMP CHAMBER CAPACITY (GALLONS): N/a COMPARTMENTED TANK REQUIRED

NUMBER OF BEDROOMS: 4

SQUARE FEET PER BEDROOM: 210

LINEAR FEET OF TRENCH REQUIRED: 200 HOUSE SERVED BY PUBLIC WATER

TRENCHES:	Trench to be 3.0 feet wide. Inlet 3.0 feet below original grade. Bottom maximum depth 6.0 feet below original grade. Effective area begins at 4.5 feet below original grade. 3.0 feet of stone below distribution pipe.
LOCATION:	Place the distribution box in the highest elevation of the approved SDA.
NOTES:	No basement gravity service

PLANS APPROVED: Pete A. Yencsik Reviewed by: KD DATE: 2/25/05


NOTES: PERMIT VOID AFTER 2 YEARS
CONTRACTOR IS RESPONSIBLE FOR SCHEDULING A PRE-CONSTRUCTION INSPECTION FOR ALL INSTALLATIONS
WATERTIGHT SEPTIC TANKS REQUIRED
ALL PARTS OF SEPTIC SYSTEM SHALL BE 100 FEET FROM ANY WATER WELL UNLESS SPECIFICALLY AUTHORIZED
MANHOLE RISERS REQUIRED ON ALL SEPTIC TANKS AND PUMP CHAMBERS UNLESS SPECIFICALLY AUTHORIZED
CONTRACTOR RESPONSIBLE FOR COMPLIANCE WITH APPLICABLE REGULATIONS, GUIDELINES AND THE TERMS OF THIS PERMIT

**NEITHER THE HOWARD COUNTY COUNCIL NOR THE HEALTH DEPARTMENT IS
RESPONSIBLE FOR THE SUCCESSFUL OPERATION OF ANY SYSTEM
PERMITTEE RESPONSIBLE FOR OBTAINING FINAL APPROVAL ON THIS PERMIT
ALL 410-313-1771 FOR INSPECTION OF SEPTIC SYSTEM**

**BUILDING PERMIT SIGNED
AND RETURNED**

1/11/07- B07060122-Finish BSMT

P 522456

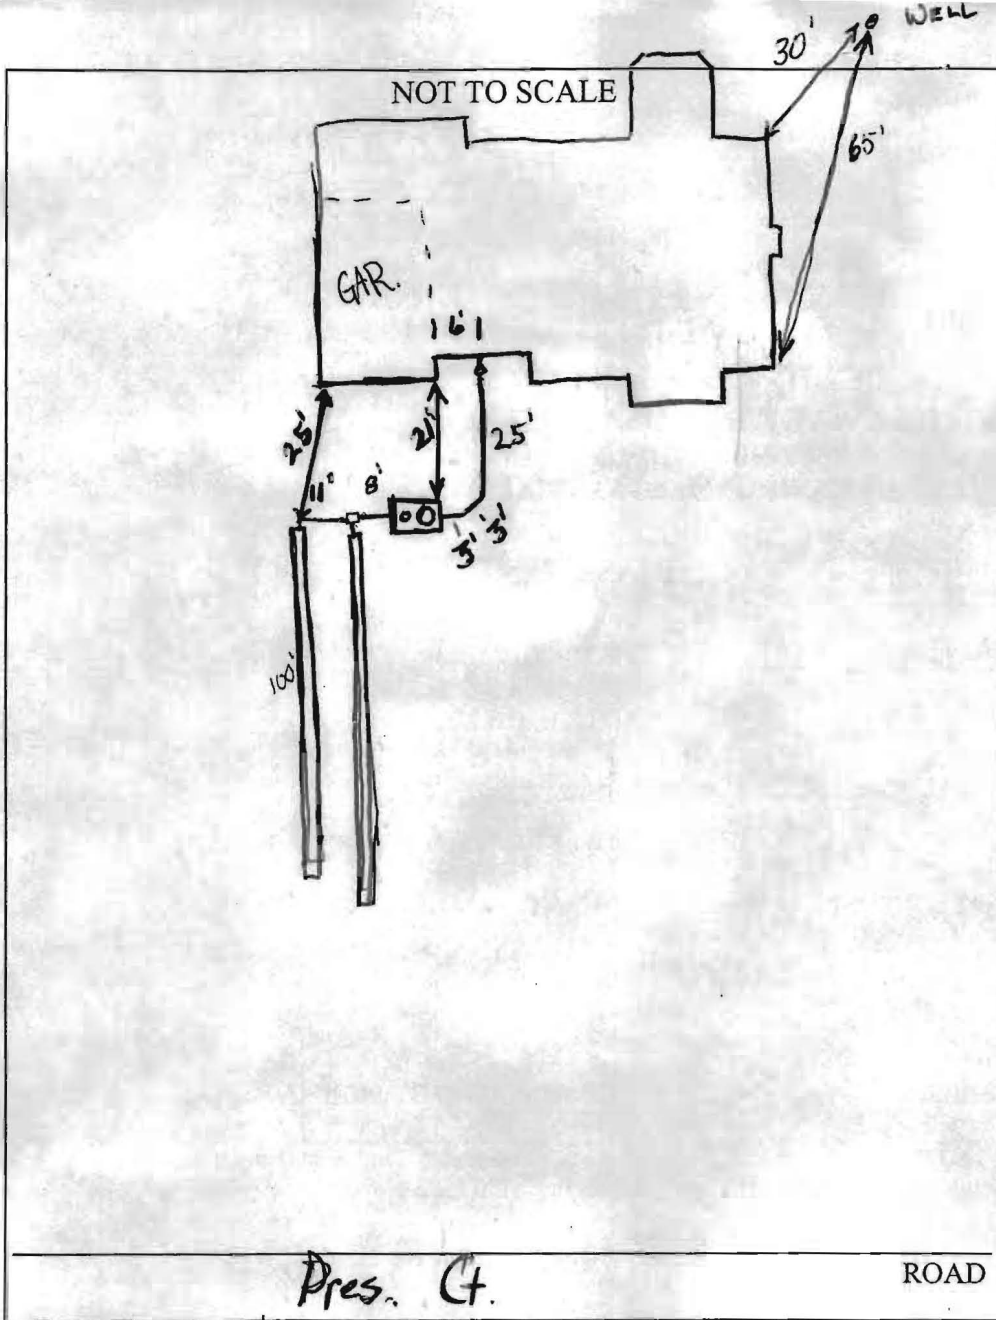


TRENCH/DRAINFIELD DATA		
WIDTH	INLET	BOTTOM
3'	3'	8'
NUMBER OF TRENCHES		2
TOTAL LENGTH		200'
ABSORPTION AREA		700 + bottom
DISTRIBUTION BOX LEVEL		Levelers
DISTRIBUTION BOX BAFFLE		yes
DISTRIBUTION BOX PORT		No

SEPTIC TANK DATA	
SEPTIC TANK 1 LEVEL	yes
CAPACITY	1500 GAL
SEAM LOC	Top
TANK LID DEPTH	1'
BAFFLES	yes 4
BAFFLE FILTER	No
MANHOLE LOC	Inlet
6" PORT LOC	Outlet
WATERTIGHT TEST	N/A
SEPTIC TANK 2 LEVEL	
CAPACITY	_____ GAL
SEAM LOC	_____
TANK LID DEPTH	_____
BAFFLES	_____
BAFFLE FILTER	_____
MANHOLE LOC	_____
6" PORT LOC	_____
WATERTIGHT TEST	_____

PRE-CONSTRUCTION ^{9/13/05} Ryn trenches along contour on left side of easement when facing house from road. Keep D-box out of area to be used for Driveway

INSTALLATION to avoid future complication. 9/14/05 Everything installed good. Okay to cover. (GAR)

FINAL INSPECTOR Garret A. Wright DATE OF APPROVAL 9/14/05

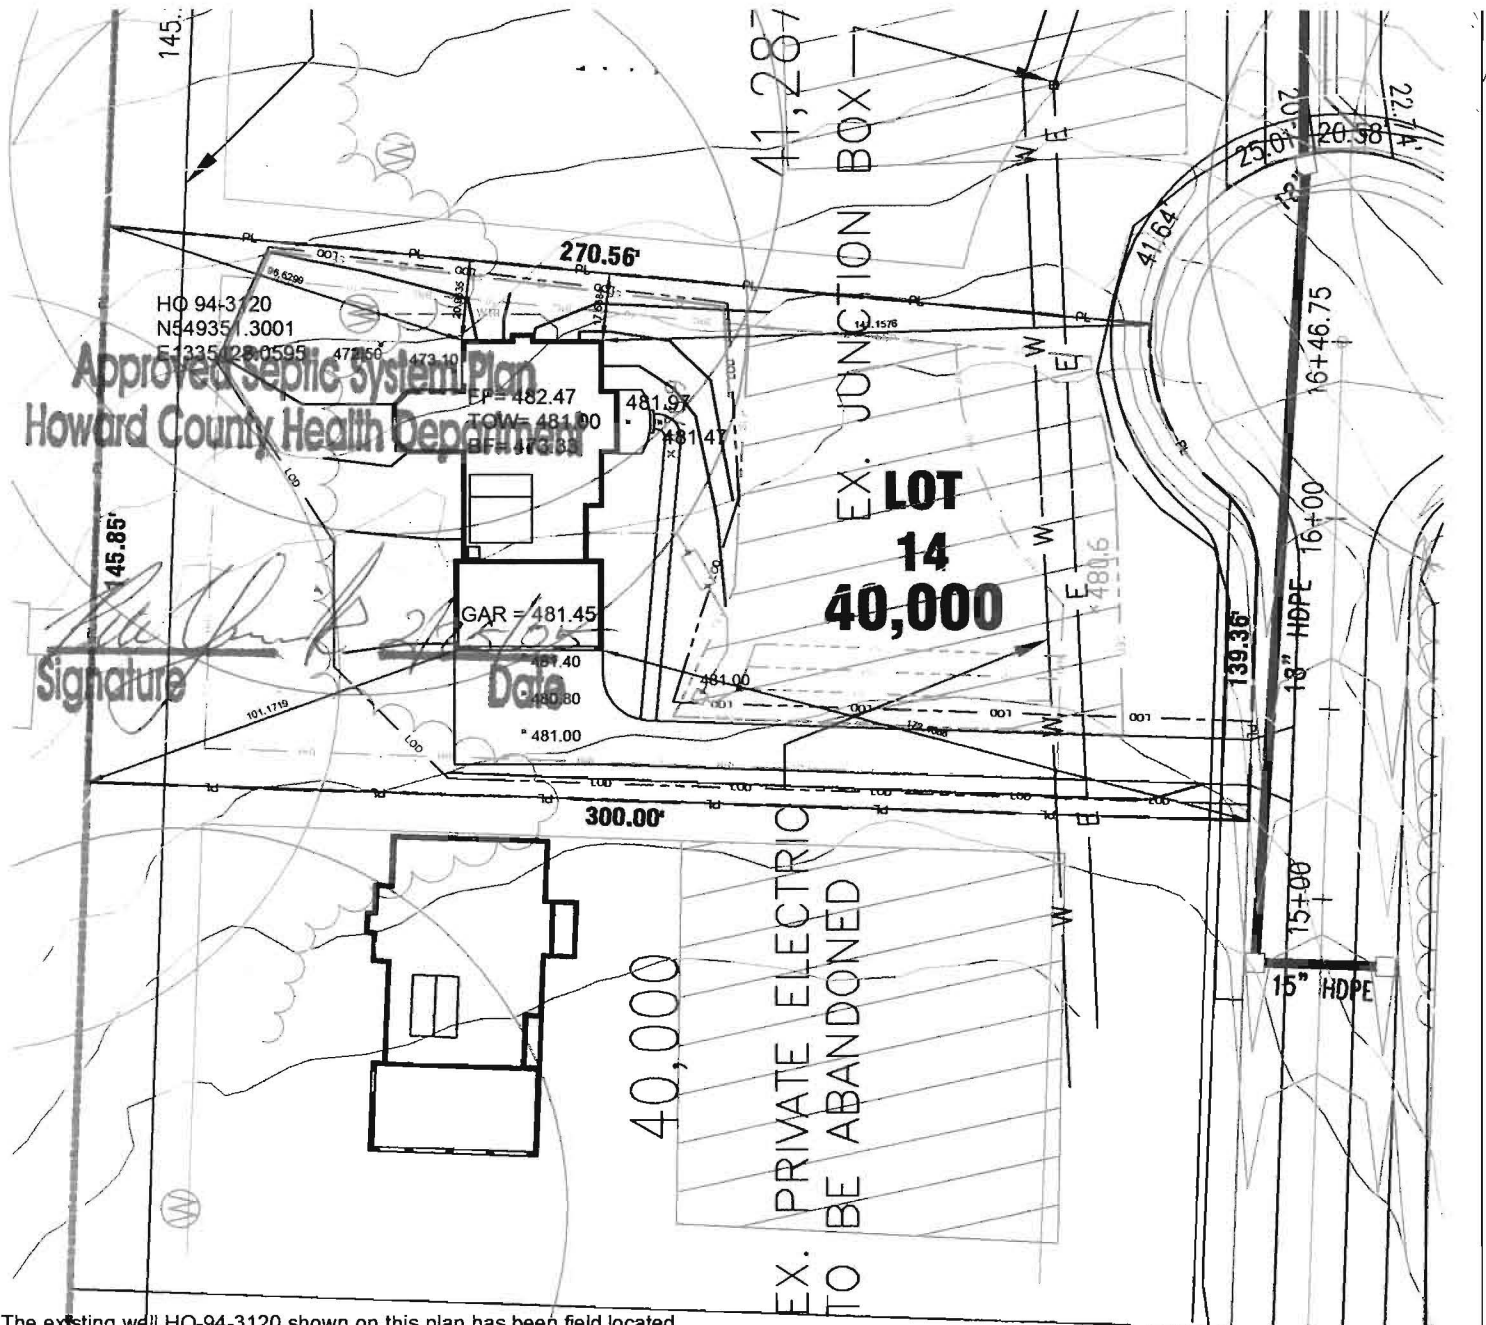


The existing wall HO-94-3120 shown on this plan has been field located by Marks & Associates, Professional Land Surveyor, and is accurately shown.

PLOT PLAN
 SINGLE FAMILY DWELLING
 THE CARTER RESIDENCE
LOT 14
 PINDELL WOODS
 HOWARD COUNTY, MD

DATE: 2-18-2005
 SCALE: 1" = 50'

OWNER/BUILDER:
DALE THOMPSON BUILDERS
 6300 WOODSIDE COURT, SUITE A
 COLUMBIA, MD. 21046
 410-995-6736

PROPOSED ELEVATIONS:	
BASEMENT FLOOR:	473.33
TOP OF FNDN WALL:	481.00
FIRST FLOOR:	482.47
INVERT OUT OF HOUSE:	479.24
INVERT INTO TANK:	478.64
INVERT INTO DISTRIBUTION BOX:	477.50
GRADE AT SEPTIC TANK:	480.50
GRADE AT DISTRIBUTION BOX:	481.00
PAVING SPECIFICATIONS:	
2" ASPHALT OVER 4" CR-6 OR	
2.5" ASPHALT OVER 1.5" OVERLAY	
50 LF OF FILTER CLOTH BEGINNING AT DRIVEWAY APRON	

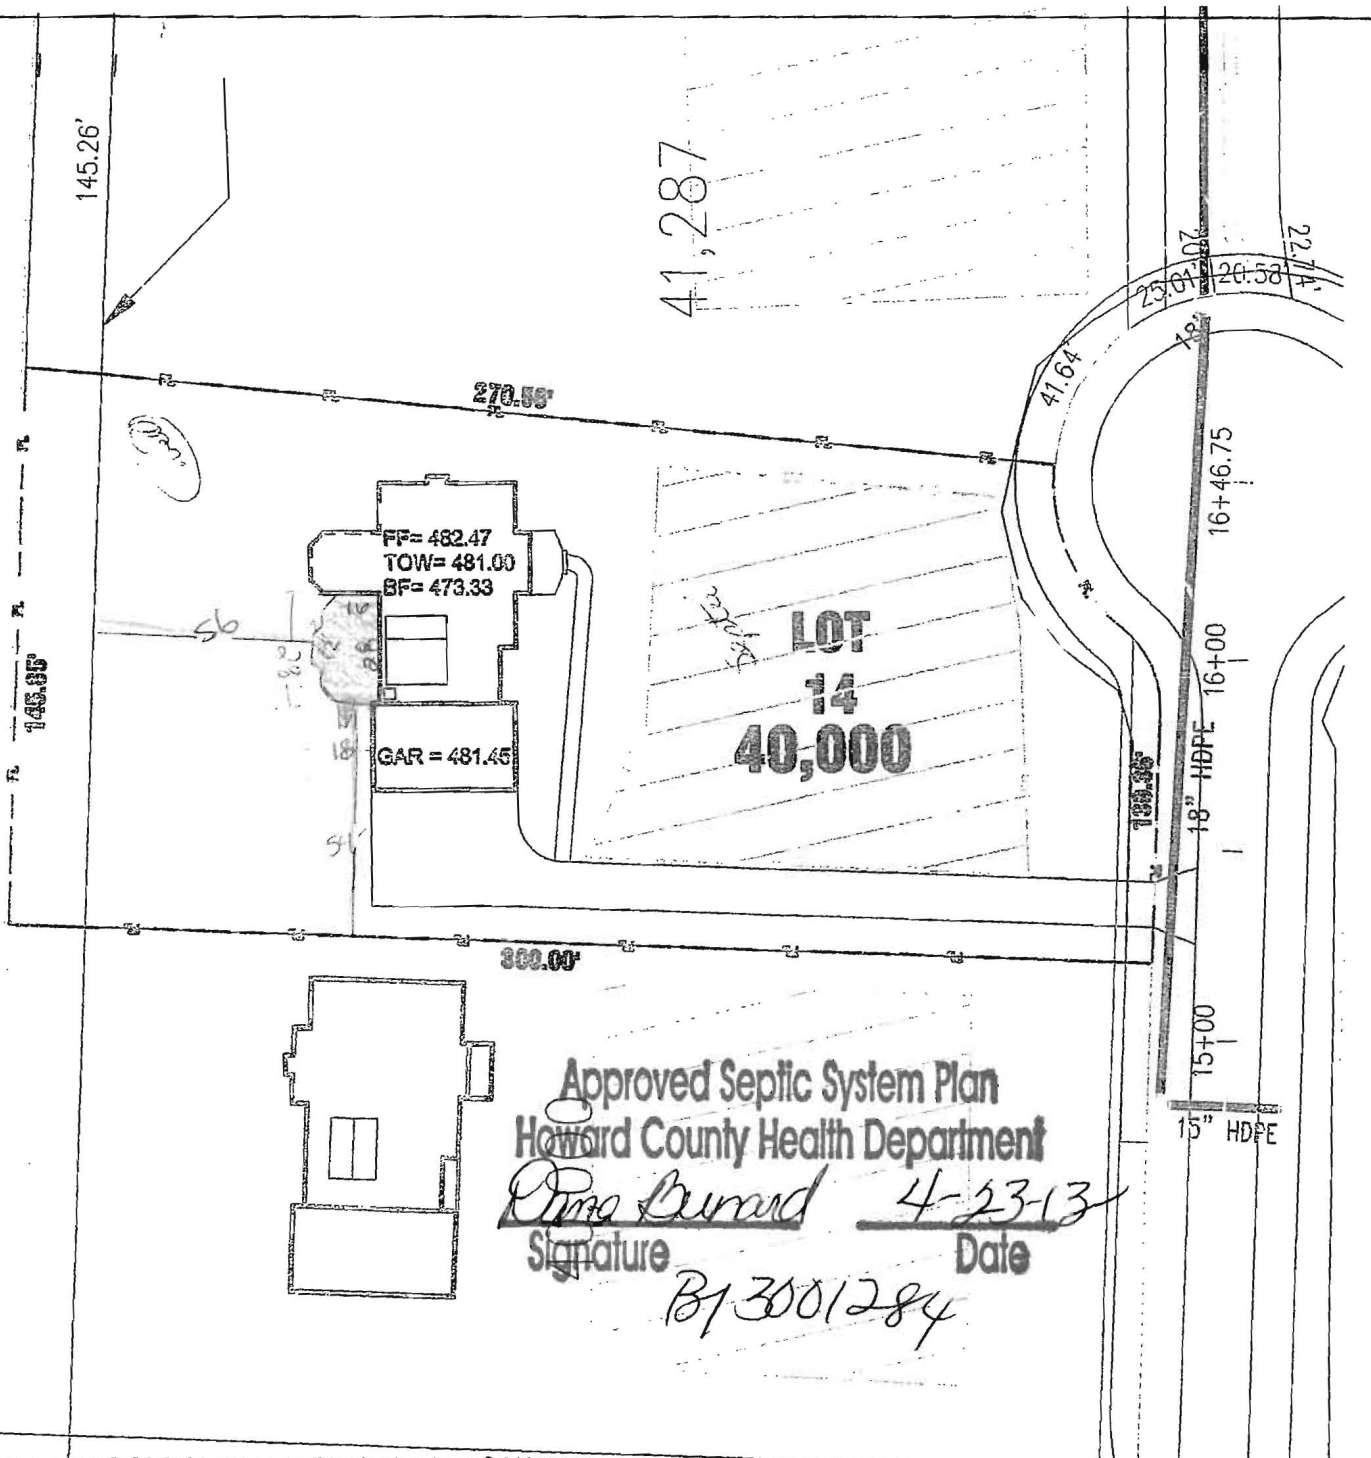

Approved Septic System Plan
 Howard County Health Department

Dina Duvard 4-23-13
 Signature Date

B13001284

Existing well HO-94-3120 shown on this plan has been field located by [Name] & Associates, Professional Land Surveyor, and is accurately shown.

LOT PLAN
3/4 SINGLE FAMILY DWELLING

CARTER RESIDENCE

JELL WOODS
HOWARD COUNTY, MD

DATE:
SCALE: 1" = 50'

OWNER/BUILDER:
DALE THOMPSON BUILDERS
6300 WOODSIDE COURT, SUITE A
COLUMBIA, MD. 21046
410-995-6736

PROPOSED ELEVATIONS:	
BASEMENT FLOOR:	473.33
TOP OF FNDN WALL:	481.00
FIRST FLOOR:	482.47
INVERT OUT OF HOUSE:	479.24
INVERT INTO TANK:	478.64
INVERT INTO DISTRIBUTION BOX:	477.50
GRADE AT SEPTIC TANK:	480.50
GRADE AT DISTRIBUTION BOX:	481.00
PAVING SPECIFICATIONS:	
2" ASPHALT OVER 4" CR-6 OR	
2.5" ASPHALT OVER 1.5" OVERLAY	
50 LF OF FILTER CLOTH BEGINNING AT DRIVEWAY APRON	