

PERMIT

SEWAGE DISPOSAL SYSTEM

MARYLAND STATE DEPARTMENT OF HEALTH

HOWARD COUNTY

ELLIGOTT CITY

DISTRICT 1

DATE 9/30/74

INDEXED

File

4/15/75
4/24/75

4/24/75
Final OK.
R. Tomer

P 3004
A 30077

Conrad C. Rose

IS PERMITTED TO INSTALL R ALTER

ADDRESS 1550 Calloway Ave., Silver Spring, MD,

PHONE (301) 708-1400

A SEWAGE DISPOSAL SYSTEM LOCATED AT _____

SUBDIVISION _____ ROAD Highland Rd. - 2000 ft. Lot 2
800 ft. from High Hollow Road

PROPERTY OWNER Conrad C. Rose & wife

ADDRESS _____

SPECIFICATIONS - 3 bedrooms

DRAIN FIELD _____ DEPTH _____ FEET. BOTTOM AREA _____ SQ. FT.

SEWAGE PITS _____ ABSORBENT SIDE-WALL AREA _____ SQ. FT.

SEPTIC TANK CAPACITY 2000 GALLONS

FOR GARBAGE GRINDER, INCREASE DISPOSAL AREA 25% & TANK CAPACITY 50%.

OTHER As seen from Highland Road the dry well will be located 90 ft. in from the

left property line and 30 ft. in from the rear property line. The lowest will be at 4 ft.

with a max. depth of 11 1/2 ft. There will be a minimum of 200 sq. ft. of sidewall area per

bedroom. *1 day volume, 7' above 2' from edge, 18" dia*

NOTE: ALL PIPE FROM HOUSE TO THE WELL MUST BE CAST IRON. *20' edge to edge*

MUST INCLUDE DRAIN PIPE IN SEPTIC TANK AND DRY WELL. STAIN PIPE MUST BE 6 INCH

PLANS APPROVED BY R. Huggins DATE 10/8/74

CAST IRON, CONCRETE OR FIBER COVER ACCEPTED.

ALL SEPTIC TANK AND DISTRIBUTION BOX WITH WATER BEFORE CALLING FOR AN INSPECTION. COVER NO WORK UNTIL INSPECTED AND APPROVED.


NEITHER THE HOWARD COUNTY COMMISSIONERS NOR THE HEALTH DEPARTMENT IS RESPONSIBLE FOR THE SUCCESSFUL OPERATION OF ANY SYSTEM.

7.5
40
300

65
1410
42
30

changed
R. Tomer
4/14/75

100611

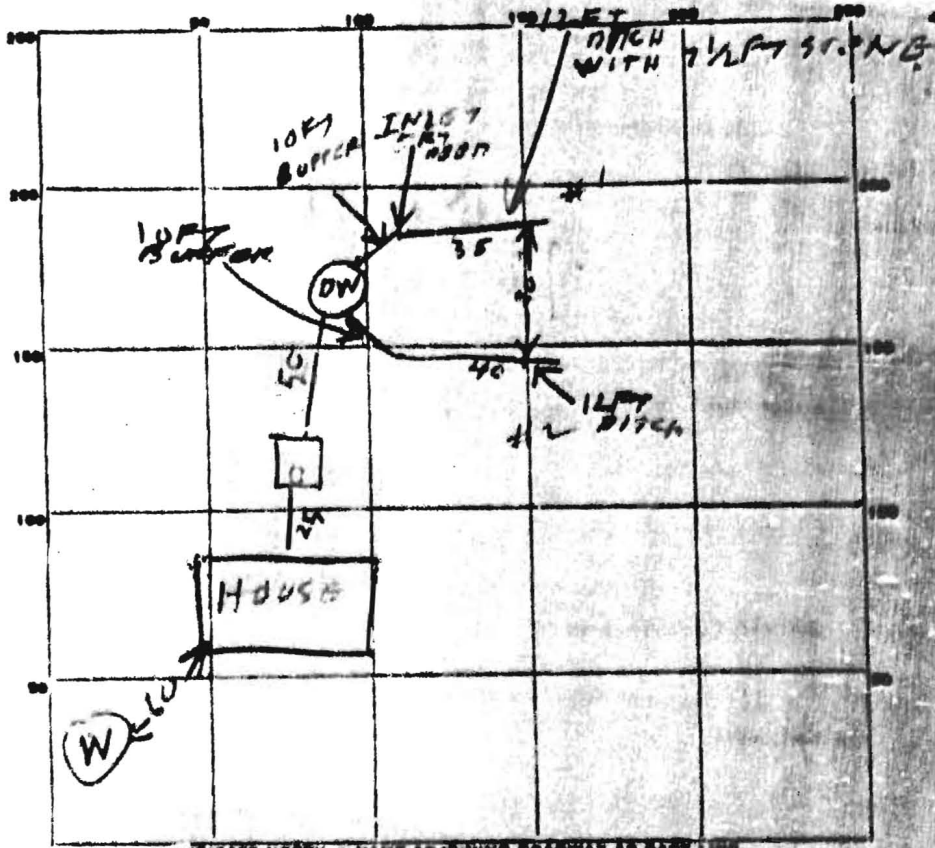

INDICATE NORTH - NAME ADJOINING ROADWAY AS BASE LINE.

PERMIT CARD _____

SEPTIC TANK, LEVEL CONCRETE CLEANOUTS OK

1500

DISTRIBUTION BOX, LEVEL _____

TILE FIELD, DEPTH 12 FT. TRENCH WIDTH 2 FT.

GRAVEL DEPTH 7 1/2\"/>

NUMBER OF TRENCHES 2 TOTAL SYSTEM AREA 525 sq ft

SEEPAGE PITS, INSIDE DIAMETER 40 FT. DEPTH BELOW INLET 7 1/2 FT.

ABSORBENT AREA 300 SQ. FT.

REMARKS: 4/18/75 DW INLET 4\"/>

DATE SYSTEM APPROVED 4/24/75 INSPECTOR B. Tunn