

APPLICATION

Recon.

11/20/78
1:30 P.M.
1ST

PKBLIN
MINOR SUB DIVISION

SEWAGE DISPOSAL TESTING

A 29107
P _____

STATE OF MARYLAND - DEPARTMENT OF HEALTH AND MENTAL HYGIENE

HOWARD COUNTY HEALTH DEPARTMENT
ENVIRONMENTAL HEALTH SERVICES

P.O. BOX 476 ELLICOTT, MARYLAND 21043
TELEPHONE: 992-2330

DISTRICT 4th

Drywell located 145' from center line of Frederick Pl. and 30 ft. from right side line. Inlet to be maximum 3 ft. below orig. grade and total max. depth 11 ft. Drywell to have 125 sq. ft. per. B.R.
DATE 10/25/78

TO: THE COUNTY HEALTH OFFICER
ELLICOTT CITY, MARYLAND

I, HEREBY, APPLY FOR THE NECESSARY TEST IN ORDER TO CONSTRUCT (OR RECONSTRUCT) A SEWAGE DISPOSAL SYSTEM.

PROPERTY OWNER Mathis property

#12392 ADDRESS Route 144, West Friendship, Md. PHONE Boender - 465-7777

PROPERTY LOCATION:

SUBDIVISION _____ LOT NO. _____

ROAD AND DESCRIPTION Route 144 - just before Fire Department - white house - will see Boender's truck there. Property will be subdivided into two lots if it percs.

SIZE OF LOT 80 acres (Existing house on property) TYPE BLDG. 3 or 4 bedrooms

THE SYSTEM INSTALLED UNDER THIS APPLICATION IS ACCEPTABLE ONLY UNTIL PUBLIC FACILITIES BECOME AVAILABLE.

I FULLY UNDERSTAND THE FEE CONNECTED WITH THE FILING OF THIS PERC TEST APPLICATION IS NON-REFUNDABLE UNDER ANY CIRCUMSTANCES.

BLDG. PERMIT SIGNED
AND RETURNED 1/24/79
Serial No. 37978

SIGNATURE OF APPLICANT /s/ Jack Boender for Gorman F. & Ruth A. Summers

APPROVED BY _____ FOR _____ DATE _____



REJECTED BY _____ FOR _____ DATE _____

HOLD PENDING FURTHER TESTS _____ DATE _____

REASONS FOR REJECTION OR HOLDING 11/21/78 PERC OK HOLD FOR PLAT RIT

THIS IS NOT A PERMIT

①
SOIL PROFILE

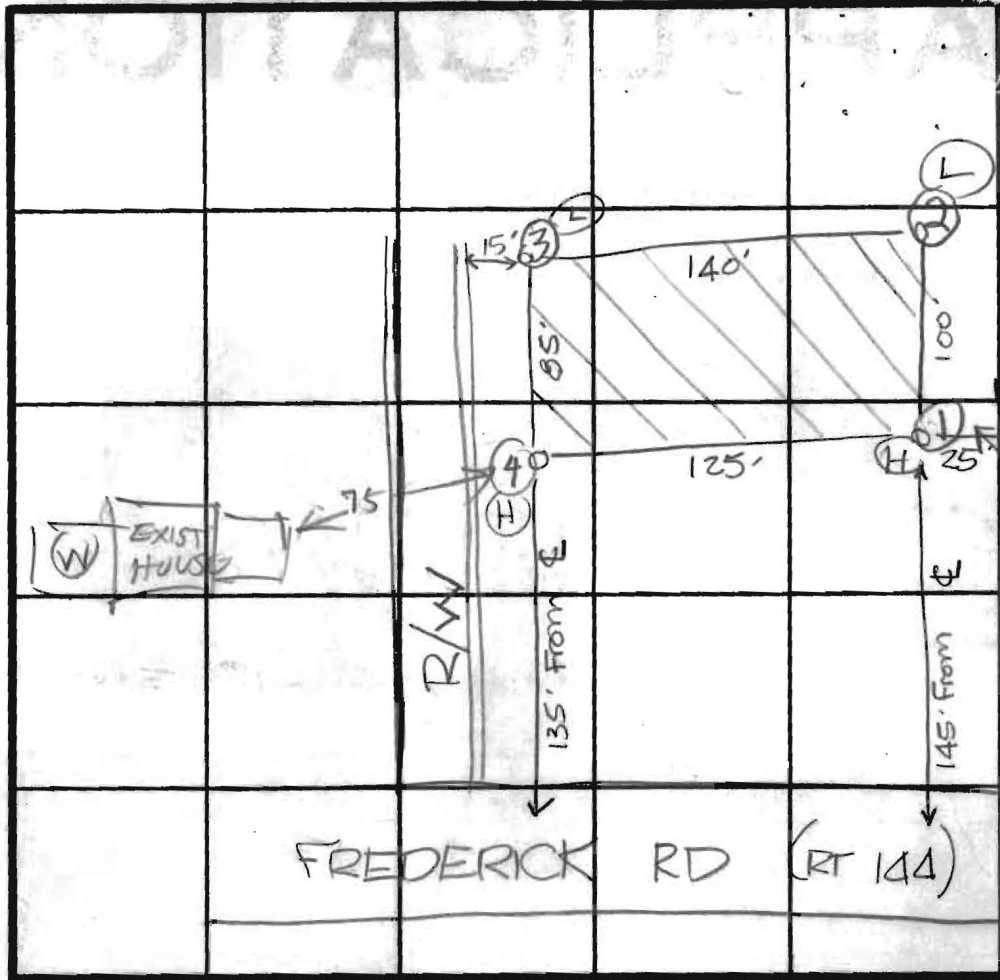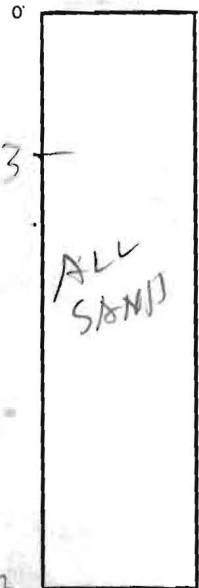

INDICATE NORTH - NAME ADJOINING ROADWAY AS BASE LINE.



DATE	TEST NO.	DEPTH	PRE-WET		TEST - 1" DROP		TIME	
			START	STOP	START	STOP		
11/20/78	1 D	13	140	144	144	150	6	
11/20/78	1 S	4 1/2	140	141	141	142	1	
	2 D	13	149	148	148	149	1	
	2 S	4 1/2	148	149	149	151	2	
	3 S	4 1/2	154	150	150	204	6	
	3 D	13 1/2	154	155	155	150	3	
	4 V	12 1/2	ALL SAND					

REMARKS _____

TYPE OF SOIL _____

TESTED BY BH ALSO PRESENT DEVRA MRS