

9/12/64  
incomplete  
PWA

# PERMIT

SEWAGE DISPOSAL SYSTEM

MARYLAND STATE DEPARTMENT OF HEALTH

HOWARD COUNTY

08735  
P. 07359  
A. 08735 07359

## INDEXED

ELLICOTT CITY  
DISTRICT  
DATE 7/9/64

Winfred Mayfield IS PERMITTED TO INSTALL  ALTER

ADDRESS 1116 Briggs Chaney Rd., Silver Spring PHONE EV 4-1811

A SEWAGE DISPOSAL SYSTEM LOCATED AT Hipsley Mill & Jones Rd., Cabin River Farms

Route 97 to Jennings Chaple 3 Miles ; turn left on Hipsley Mill 1/2 mi. to lot on left of road; corner lot  
3530 Hipsley Mill Road

SUBDIVISION Cabin River Farms ROAD 1116-Briggs-Chaney Rd. LOT 1 Sec. A

PROPERTY OWNER Winfred Mayfield David + Norma Hoff, Sr.

ADDRESS 1116 Briggs Chaney Rd.

### SPECIFICATIONS

DRAIN FIELD \_\_\_\_\_ DEPTH \_\_\_\_\_ FEET, BOTTOM AREA \_\_\_\_\_ SQ. FT.

SEEPAGE PITS  ABSORBENT SIDE-WALL AREA 480 SQ. FT.

SEPTIC TANK CAPACITY 1,000 GALLONS

FOR GARBAGE GRINDER, INCREASE DISPOSAL AREA 22% & TANK CAPACITY 50%.

OTHER Dry Well- 480 sq. ft. absorbent sidewall area to begin below the inlet pipe.

Place Dry Well 200 to 230 ft. from front lot. line (Hipsly Mill Rd.) and 50 to 110 ft.

from right side of lot determined as you face lot from Hipsly Mill Rd.

PLANS APPROVED BY Donald W. Monaghan DATE 7/9/64


FILL SEPTIC TANK AND DISTRIBUTION BOX WITH WATER BEFORE CALLING FOR AN INSPECTION. COVER NO WORK UNTIL INSPECTED AND APPROVED.

NEITHER THE HOWARD COUNTY COMMISSIONERS NOR THE HEALTH DEPARTMENT IS RESPONSIBLE FOR THE SUCCESSFUL OPERATION OF ANY SYSTEM.

REC'D PERMIT DIVISION  
AND RETURNED 8/4/64  
Serial # 20314 - prod.

A 07359

A # 07.359

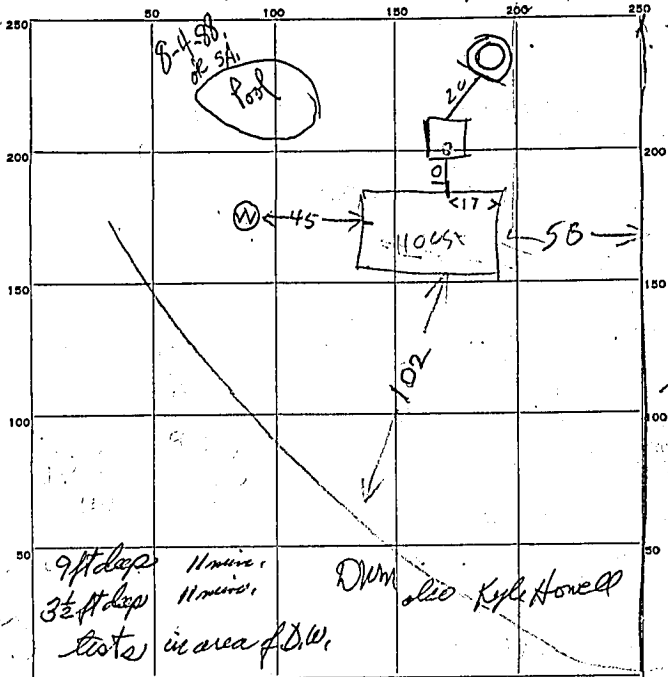

9-7-63,

9ft deep 11 min  
3 1/2 ft deep 11 min  
lots in area of DW.

INDICATE NORTH. -- NAME ADJOINING ROADWAY AS BASE LINE.

PERMIT CARD \_\_\_\_\_

SEPTIC TANK, LEVEL OK HOME MADE 1100 gals CLEANOUTS \_\_\_\_\_  
Gravel Level

DISTRIBUTION BOX, LEVEL \_\_\_\_\_

TILE FIELD, DEPTH \_\_\_\_\_ FT. TRENCH WIDTH \_\_\_\_\_ FT.

GRAVEL DEPTH \_\_\_\_\_ IN. TOTAL LENGTH \_\_\_\_\_ FT.

NUMBER OF TRENCHES \_\_\_\_\_ TOTAL BOTTOM AREA \_\_\_\_\_

SEEPAGE PITS, INSIDE DIAMETER 13 FT. DEPTH BELOW INLET 11 FT.

ABSORBENT AREA 4740 SQ. FT. counting stone

15 Sept 64  
REMARKS Dry Well inlet is 1 ft below grade  
System is OK except septic tank lid & Dry Well  
Top is incomplete. Pour Tank lid & Dry Well top &  
call for reinspection 8/11

DATE SYSTEM APPROVED \_\_\_\_\_ INSPECTOR \_\_\_\_\_