

PROPERTY KNOWN AS:  
4562 F. 129  
WARD COUNTY, MD

THIS PLAT CAN NOT BE USED TO ESTABLISH  
PROPERTY LINES OR CORNERS.

N 28° 26' W 121.20'

P.O.B. IN  
3rd LINE  
HWB 228 F. 189

367.07'

1 AC ±

146.4'

351.80'

APPROVED

WALK-THRU BUILDING PERMIT

BP# 800154848 A# 522550


APP. SAN KJR DATE: 7/7/05

DESC. OF WORK: Alone

Ground pool 20' x 50'

S 62° 52' W

Well

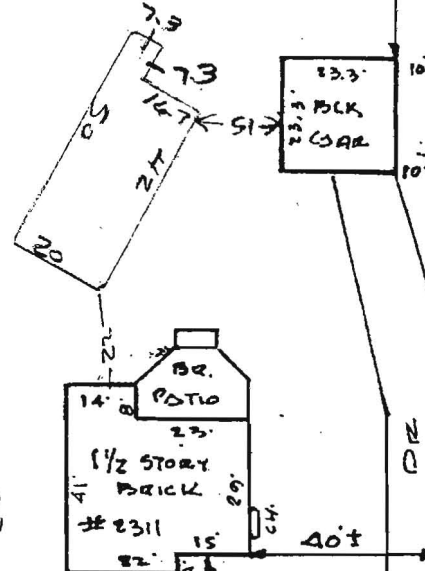

N 62° 52' E

S 31° 28' E 50'

DANIELS ROAD