

APPLICATION

A 02986
P 03297

SEWAGE DISPOSAL TESTING

MARYLAND STATE DEPARTMENT OF HEALTH

HOWARD COUNTY 750 Gallon Tank ELLICOTT CITY
Dry Wells - 477 sq ft DISTRICT 5
Builder - Pas - 6897 sidewall DATE 9/22/60
area below the top 5 ft of clay

Place the dry wells about 150 ft to 175 ft
from Cherry Drive and about 40 ft to
70 ft from the left side of the lot

TO: THE COUNTY HEALTH OFFICER
ELLICOTT CITY, MARYLAND

I, HEREBY, APPLY FOR THE NECESSARY TESTS IN ORDER TO CONSTRUCT (OR RECONSTRUCT) A SEWAGE DISPOSAL SYSTEM.

as seen when facing the
lot from Cherry Drive

PROPERTY OWNER Vorce, James
ADDRESS Cherry Drive PHONE _____

PROPERTY LOCATION:
SUBDIVISION Hopkins Meade LOT NO. 18

ROAD AND DESCRIPTION Oakcrest Lane and Cherry Drive

OCCUPANT _____ PHONE _____

PERSON TO CONSTRUCT SYSTEM _____
ADDRESS _____ PHONE _____

SIZE OF LOT 1 acre TYPE BLDG. 3
NUMBER OF BEDROOMS _____

IF NOT SINGLE RESIDENCE DESCRIBE _____

SIGNATURE OF APPLICANT Paul Schild

APPROVED BY Raymond Hodges FOR Dry Well DATE 9/27/60
(KIND OF SYSTEM)


REJECTED BY _____ FOR _____ DATE _____
(KIND OF SYSTEM)

HOLD PENDING FURTHER TESTS RH DATE 9/27/60

REASONS FOR REJECTION OR HOLDING little pipe

lot

THIS IS NOT A PERMIT

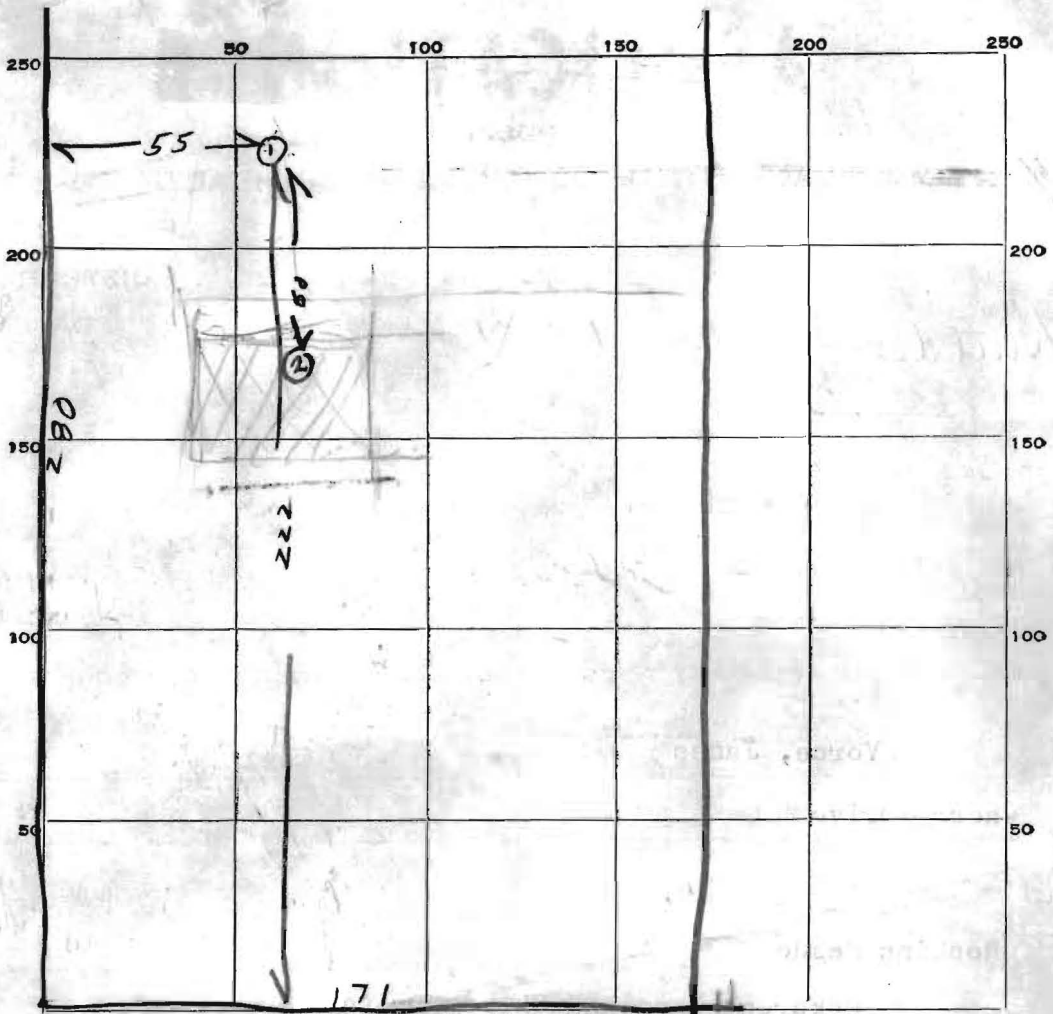

INDICATE NORTH. - NAME ADJOINING ROADWAY AS BASE LINE.

CHERRY DRIVE DAK CREST LA →

DATE	TEST NO.	DEPTH	PRE-WET		TEST - 1" DROP		TIME
			START	STOP	START	STOP	
9/23/60	1	9	1039	1110	Bottle perc		
9/27/60	2	9	1022	1034	1034	1053	19 min

SOIL AUGER FINDING top 5' clay Bottom 4' clay spec sent

TESTED BY Raymond Hodges 9/27/60 RH

REMARKS

ALSO PRESENT Indy Schlicht 9/27/60 LOT NO

Alvin Schlicht