

Ch. mt

1/19/61 approved File

Indeped

PERMIT

P 03297

A 02986

SEWAGE DISPOSAL SYSTEM

MARYLAND STATE DEPARTMENT OF HEALTH

HOWARD COUNTY

ELLCOTT CITY

INDEXED

DISTRICT 5

DATE 1-6-61

Lawrence Knoch IS PERMITTED TO INSTALL ALTER

ADDRESS 803 Cliff Edge Road Baltimore 8 PHONE Hu 6-8591

A SEWAGE DISPOSAL SYSTEM LOCATED AT Hopkins Meade subdivision on Oakcrest Lane and Cherry Drive

SUBDIVISION Hopkins Meade ROAD Oakcrest Lane and Cherry Drive LOT 18

PROPERTY OWNER Vorce, James

ADDRESS Cherry Drive

SPECIFICATIONS

DRAIN FIELD _____ DEPTH _____ FEET, BOTTOM AREA _____ SQ. FT.

SEEPAGE PITS ABSORBENT SIDE-WALL AREA 477 SQ. FT.

SEPTIC TANK CAPACITY 750 GALLONS

FOR GARBAGE GRINDER, INCREASE DISPOSAL AREA 22% & TANK CAPACITY 50%.

OTHER Dry Well- 477 sq. ft. sidewall area below the top 5 ft. of clay


Place the dry wells about 150 ft. to 175 ft. from Cherry Drive and about 40 ft. to 70 ft. from the left side of the lot as seen when facing the lot from Cheery Drive.

PLANS APPROVED BY Raymond Hodges DATE 9-27-60

FILL SEPTIC TANK AND DISTRIBUTION BOX WITH WATER BEFORE CALLING FOR AN INSPECTION. COVER NO WORK UNTIL INSPECTED AND APPROVED.

NEITHER THE HOWARD COUNTY COMMISSIONERS NOR THE HEALTH DEPARTMENT IS RESPONSIBLE FOR THE SUCCESSFUL OPERATION OF ANY SYSTEM.

A 02986

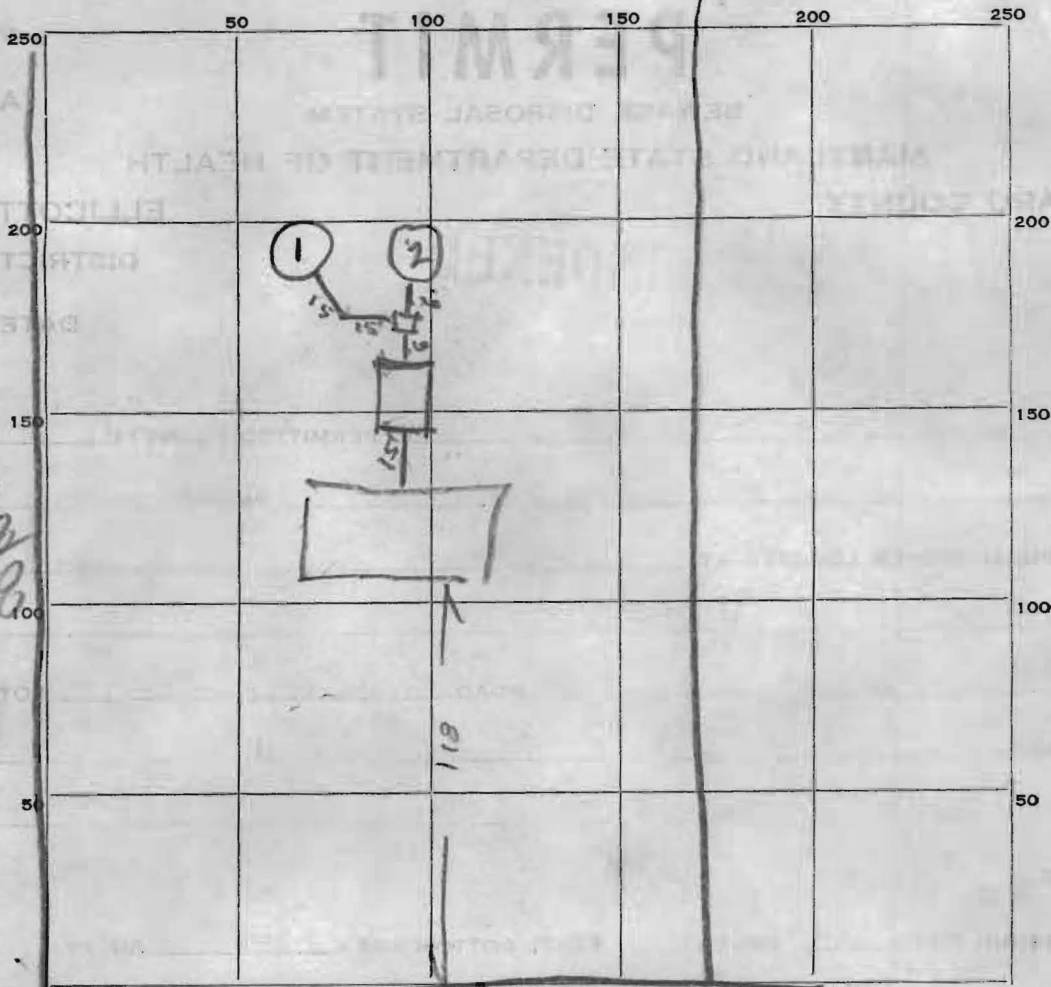

INDICATE NORTH. - NAME ADJOINING ROADWAY AS BASE LINE.

CHERRY DR.

PERMIT CARD Yes

SEPTIC TANK, LEVEL OK 750

CLEANOUTS OK

DISTRIBUTION BOX, LEVEL _____

TILE FIELD, DEPTH _____ FT. TRENCH WIDTH _____ FT.

GRAVEL DEPTH _____ IN. TOTAL LENGTH _____ FT.

NUMBER OF TRENCHES _____ TOTAL BOTTOM AREA _____

SEEPAGE PITS, INSIDE DIAMETER _____ FT. DEPTH BELOW INLET _____ FT.

ABSORBENT AREA 475 sq ft total sidewall area SQ. FT.

REMARKS: DW #1 Inlet 5 ft below grade 6-12" gravel
 10 ft in diameter x 7 ft deep below inlet
 DW #2 Inlet 4 ft below grade 6" to 12" stone
 around outside of Ring Well 6" to 12" gravel
 around DW 10 ft in diameter x 8 ft deep

DATE SYSTEM APPROVED 1/18/61

INSPECTOR Raymond Hodges

37
 227

3 1/8
 248

27
 248
 475

35

59.5'

FRONT

Well

House

← 35' →

Septic

286.14'

280.35'

10/19/92
OK TO SIGN
VISITED SITE
3045.740
RH
106' →

← 30' →

24' x 32'

20' ↓

BACK PROP. 171.33'