

PUB. SEWER STATUS VERIFIED BY \_\_\_\_\_

ISSUE DATE: 9/28/05

P 523388

APPROVAL DATE: 10/19/05

A REPAIR

# PERMIT

## INDEXED

06-438334

### ON-SITE SEWAGE DISPOSAL SYSTEM HOWARD COUNTY HEALTH DEPARTMENT BUREAU OF ENVIRONMENTAL HEALTH

D. A. Sensenig, Inc. IS PERMITTED TO INSTALL  ALTER

ADDRESS: 10360 Oak Hill Road, Keymar MD 21757 PHONE NUMBER: 301-845-8806

SUBDIVISION: \_\_\_\_\_ LOT NUMBER: \_\_\_\_\_

ADDRESS: 10300 Gorman Road PROPERTY OWNER: KINGDOM GOULD  
Floyd Wennerberg

SEPTIC TANK CAPACITY (GALLONS): Existing

PUMP CHAMBER CAPACITY (GALLONS): N/A

NUMBER OF BEDROOMS: 3

SQUARE FEET PER BEDROOM: 180

LINEAR FEET OF TRENCH REQUIRED: 154'

3' Wide  
Inlet 2'  
Bottom 4'  
2' Stone Below Pipe

TRENCHES:	Trench to be _____ feet wide. Inlet _____ feet below original grade. Bottom maximum depth _____ feet below original grade. Effective area begins at _____ feet below original grade. _____ feet of stone below distribution pipe.
LOCATION:	
PURPOSE:	Existing septic system has failed. Call for inspection when ground is opened so sanitarian can recommend repair.


PLANS APPROVED: \_\_\_\_\_ DATE: \_\_\_\_\_

- NOTE: PERMIT VOID AFTER 2 YEARS
- NOTE: CONTRACTOR RESPONSIBLE FOR SCHEDULING A PRE-CONSTRUCTION INSPECTION FOR ALL INSTALLATIONS
- NOTE: WATERTIGHT SEPTIC TANKS REQUIRED
- NOTE: ALL PARTS OF SEPTIC SYSTEM SHALL BE 100 FEET FROM ANY WATER WELL
- NOTE: MANHOLE RISERS REQUIRED ON ALL SEPTIC TANKS AND PUMP CHAMBERS

**NEITHER THE HOWARD COUNTY COUNCIL OR THE HEALTH DEPARTMENT IS RESPONSIBLE FOR THE SUCCESSFUL OPERATION OF ANY SYSTEM PERMITTEE RESPONSIBLE FOR OBTAINING FINAL APPROVAL ON THIS PERMIT CALL 410-313-2640 FOR INSPECTION OF SEPTIC SYSTEM**

1523388

NOT TO SCALE

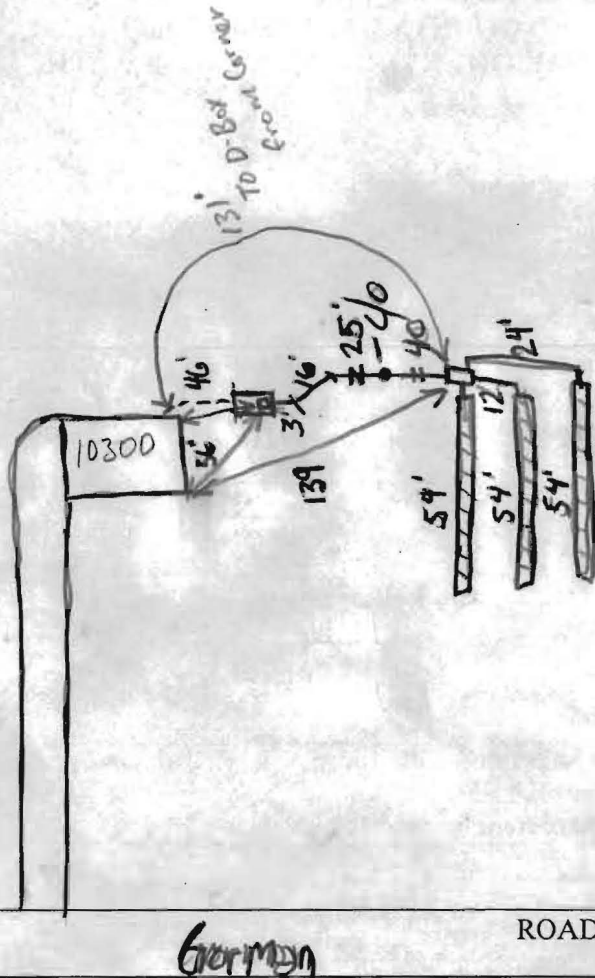

TRENCH/DRAINFIELD DATA		
WIDTH	INLET	BOTTOM
3'	2'	4'
NUMBER OF TRENCHES		3
TOTAL LENGTH		162
ABSORPTION AREA		
DISTRIBUTION BOX LEVEL		Yes
DISTRIBUTION BOX BAFFLE		Yes
DISTRIBUTION BOX PORT		No

SEPTIC TANK DATA	
SEPTIC TANK 1 LEVEL	?
CAPACITY	1250 <sup>?</sup> GAL
SEAM LOC	MID
TANK LID DEPTH	2 1/2
BAFFLES	New Outlet
BAFFLE FILTER	No
MANHOLE LOC	No
6" PORT LOC	No
WATERTIGHT TEST	No
SEPTIC TANK 2 LEVEL	
CAPACITY	GAL
SEAM LOC	
TANK LID DEPTH	
BAFFLES	
BAFFLE FILTER	
MANHOLE LOC	
6" PORT LOC	
WATERTIGHT TEST	

PRE-EXISTING

PRE-CONSTRUCTION 10/5/05 Install 3 - 5' or 52' trenches on contour near test hole A. Keep trenches near or above hole A. (BB)

INSTALLATION 10/19/05 Everything installed. New baffle on outlet of existing Tank. OK to Backfill. (GAC)

FINAL INSPECTOR Gabriel A. Crighton DATE OF APPROVAL 10/19/05

2/25/75 final approval F.S.

# PERMIT

SEWAGE DISPOSAL SYSTEM

P 21138

A 20901

MARYLAND STATE DEPARTMENT OF HEALTH

HOWARD COUNTY

ELLICOTT CITY

DISTRICT 6th

## INDEXED

DATE 2/18/75

Jack Fyock \_\_\_\_\_ IS PERMITTED TO INSTALL  ALTER \_\_\_\_\_

ADDRESS Ten Oaks Road, Glenelg, Maryland \_\_\_\_\_ PHONE 286-2939 \_\_\_\_\_

A SEWAGE DISPOSAL SYSTEM LOCATED AT \_\_\_\_\_

SUBDIVISION \_\_\_\_\_ ROAD Gorman Road - see plat \_\_\_\_\_ LOT \_\_\_\_\_  
FOR DIRECTIONS

PROPERTY OWNER Mr. and Mrs. Floyd Wennerberg \_\_\_\_\_

ADDRESS 7502 Brown Bridge Road, Highland, Md. 21 20777 Phone: 774-6898 \_\_\_\_\_

SPECIFICATIONS 3 bedrooms

DRAIN FIELD \_\_\_\_\_ DEPTH \_\_\_\_\_ FEET. BOTTOM AREA \_\_\_\_\_ SQ. FT.

SEEPAGE PITS \_\_\_\_\_ ABSORBENT SIDE-WALL AREA \_\_\_\_\_ SQ. FT.

SEPTIC TANK CAPACITY 1000 \_\_\_\_\_ GALLONS

FOR GARBAGE GRINDER, INCREASE DISPOSAL AREA 22% & TANK CAPACITY 50%.

~~OTHER~~ ~~CONCRETE~~ ~~PIPE~~ ~~FIELD~~ ~~Two (2) 90 ft. trenches, 2 1/2 ft. wide, 10 ft. apart~~  
~~center to center. Dig trenches 4 ft. deep, install 1 ft. of gravel under distribu-~~  
~~tion pipe, then cover pipe with gravel. Cover with building paper. Locate first~~  
~~trench 10 ft. from existing private driveway and 20 ft. off 114.93 ft. lot line~~  
~~and run across slope. Place second trench approximately 10 ft. downslope from first~~  
~~trench. One trench 5 1/2 to 6 ft. wide, 100 ft. length, same depth and gravel.~~

NOTE: ALL PIPE FROM HOUSE TO DISPOSAL AREA MUST BE CAST IRON.

PERMIT VOID AFTER THREE YEARS.

NOTE: INSTALL STAND PIPE ON SEPTIC TANK AND DRY WELL. STAND PIPES MUST BE 6 INCHES IN DIAMETER - CAST IRON, CONCRETE OR TERRA COTTA ACCEPTED.


PLANS APPROVED BY William W. Zepp & Fred Frommelt \_\_\_\_\_ DATE 11/18/74 & 2/18/75

FILL SEPTIC TANK AND DISTRIBUTION BOX WITH WATER BEFORE CALLING FOR AN INSPECTION. COVER NO WORK UNTIL INSPECTED AND APPROVED.

NEITHER THE HOWARD COUNTY COMMISSIONERS NOR THE HEALTH DEPARTMENT IS RESPONSIBLE FOR THE SUCCESSFUL OPERATION OF ANY SYSTEM.

A 20901

20901

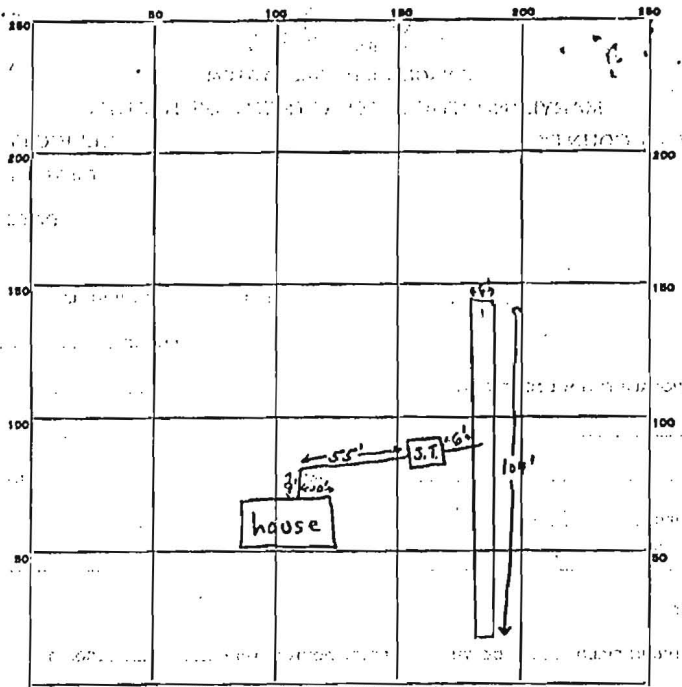

INDICATE NORTH. - NAME ADJOINING ROADWAY AS BASE LINE.  
German Road

PERMIT CARD septic cover all work

SEPTIC TANK, LEVEL  CLEANOUTS  S.T.

DISTRIBUTION BOX, LEVEL \_\_\_\_\_ OTHER \_\_\_\_\_

TILE FIELD, DEPTH 4 FT. - TRENCH WIDTH 6 FT.

GRAVEL DEPTH 1 ft. below pipe IN. TOTAL LENGTH 104 FT.

NUMBER OF TRENCHES 1 TOTAL BOTTOM AREA 624 sq. ft.

SEEPAGE PITS, INSIDE DIAMETER \_\_\_\_\_ FT. DEPTH BELOW INLET 1 FT.

ABSORBENT AREA  $\pm 624$  SQ. FT.

REMARKS 2/25/75 Trench 104' long gravel to within 2' of ground surface

NEITHER THE HOWARD COUNTY COMMISSIONERS NOR THE HEALTH DEPARTMENT IS RESPONSIBLE FOR THE SUCCESSFUL OPERATION OF ANY SYSTEM

DATE SYSTEM APPROVED 2/25/75 INSPECTOR F. Skinner