


Locate
 ~ 170' off
 R of W.

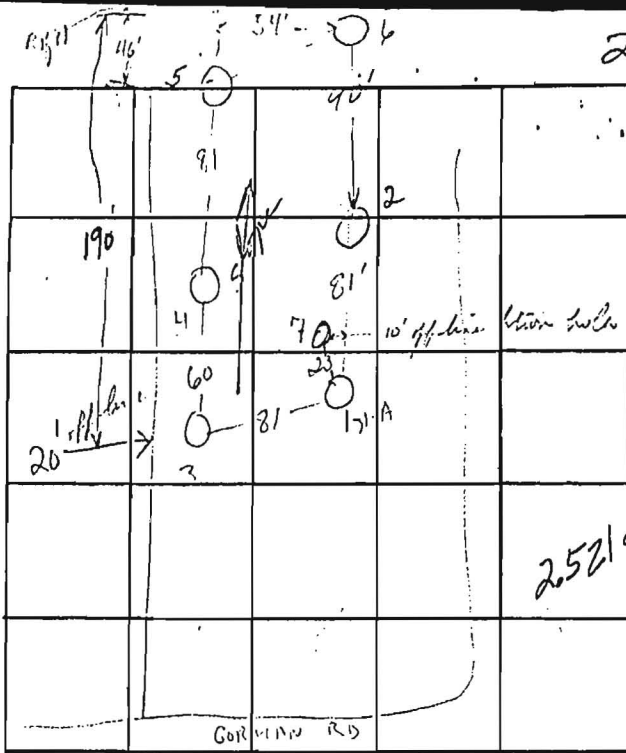

INDICATE NORTH. - NAME ADJOINING ROADWAY AS BASE LINE.

DATE	TEST NO.	DEPTH	PRE-WET		TEST - 1" DROP		TIME
			START	STOP	START	STOP	
3/74	1	3	1:33	1:35	1:35	1:40	5
	1-A	5	1:37	1:38	1:38	1:45	7
	2	9 1/2	1:44	1:47	1:47	1:55	8
	3	4	Rock				
	4	2	1:56	1:58	2:02	2:29	26
	4-A	8	1:56	1:59	1:59	2:05	6
	5	3	2:07	2:08	2:07	2:10	2
	5-A	9 1/2	2:07	2:13	2:13	2:24	11
	6	5'	Visual	rock @ bottom			
	7	7'	Rock				

$T = 11 \text{ min}$
 120 #/BC
 $20\% = 24\%$
 148 #/BC

REMARKS Tile field specs as per P.F.W.
 TYPE OF SOIL Sandy, then rock shallow stry ~ 4' off rock over
 TESTED BY W.W.F. ALSO PRESENT: contract purchaser