

8/10/73: Vertical Pipe - 1 1/2 ft. down to sewer.

APPLICATION

A 09006
P _____

SEWAGE DISPOSAL TESTING

8/30/73
2:30

HOWARD COUNTY MARYLAND STATE DEPARTMENT OF HEALTH
ELLICOTT CITY

DISTRICT 3
DATE 9/9/64

Septic Tank: Shedroom - 1000 gal
" " " - 2500 gal
" " " - 1500 gal

Dry Well - 100 sq ft. area below unit pipe per bedroom. Unit pipe no larger than 4 1/2 ft below grade. Prop. depth 1 1/2 ft. for dry well. Place dry well about 40 ft from front lot line and about 35 ft from right side or run within 10 ft from Street B.

TO: THE COUNTY HEALTH OFFICER
ELLICOTT CITY, MARYLAND

8/30/73 12:21 AM
R. Tamm

I, HEREBY, APPLY FOR THE NECESSARY TESTS IN ORDER TO CONSTRUCT (OR RECONSTRUCT) A SEWAGE DISPOSAL SYSTEM.

PROPERTY OWNER Burnt Woods Development Co., Inc. - James Filbeck
788-7594
ADDRESS 212 Crownwood Road, D. C., Md. PHONE HO 5-7545

PROPERTY LOCATION:
SUBDIVISION Burnt Wood LOT NO. 10, Blk. B, Sec. 2
ROAD AND DESCRIPTION Street "B" Castlebar Drive

OCCUPANT _____ PHONE _____

PERSON TO CONSTRUCT SYSTEM _____

ADDRESS _____ PHONE _____

SIZE OF LOT 150' x 265' TYPE BLDG. 3 tent per bedroom
NUMBER OF BEDROOMS

IF NOT SINGLE RESIDENCE DESCRIBE _____

SIGNATURE OF APPLICANT /s/ M. A. Wakefield, Jr.


APPROVED BY D.W. Monaghan FOR Dry Well DATE 9/19/64
(KIND OF SYSTEM)

REJECTED BY _____ FOR _____ DATE _____
(KIND OF SYSTEM)

HOLD PENDING FURTHER TESTS _____ DATE _____

REASONS FOR REJECTION OR HOLDING _____

THIS IS NOT A PERMIT

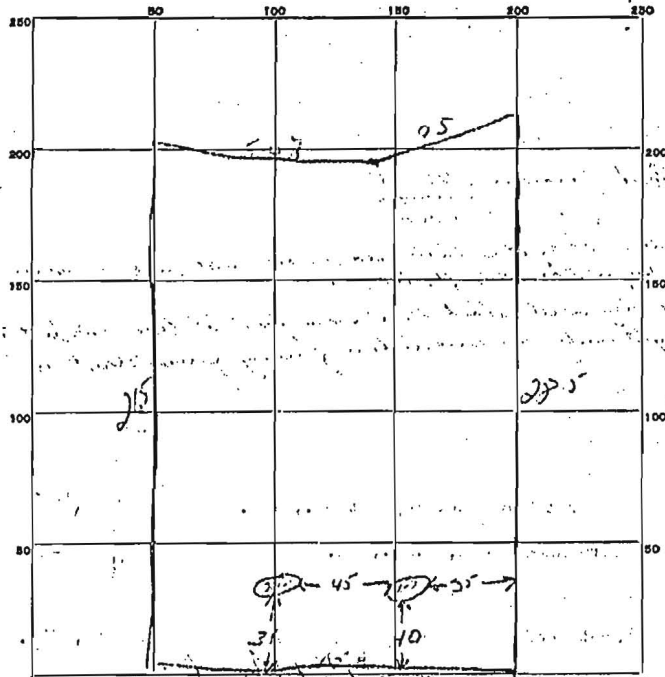

INDICATE NORTH & NAME ADJOINING ROADWAY AS BASE LINE.

Street B

DATE	TEST NO.	DEPTH	PRE-WET		TEST - 1" DROP		TIME
			START	STOP	START	STDP	
9/16/11	1	5 1/2 ft	1000	1002	1002	1007	5 min
	2	11 ft	1001	1002	1002	1007	5 min
	3	5 1/2 ft	1003	1007	1007	1015	8 min
	4	11 ft	1003	1004	1004	1008	4 min

SOIL AUGER FINDING

TESTED BY

John H. B. 11/16/11

REMARKS

S. B. 11/16/11

ALSO PRESENT

LOT NO.

10 B. pr. 3, part 1