

APPLICATION

PERCOLATION TESTING

Resigned #

A 498886

P _____

DISTRICT FOURTH

DATE DECEMBER 8, 1993

*Test # Resigned
From old lot 5 (Prelim #) which was not tested*

HOWARD COUNTY HEALTH DEPARTMENT
BUREAU OF ENVIRONMENTAL HEALTH
3525-H ELLICOTT MILLS DRIVE/ELLICOTT CITY, MARYLAND 21043
TELEPHONE: 313-2640

TO: THE COUNTY HEALTH OFFICER
ELLICOTT CITY, MARYLAND

I HEREBY APPLY FOR THE NECESSARY TEST PRIOR TO APPLICATION FOR PERMIT TO CONSTRUCT (OR RECONSTRUCT) A SEWAGE DISPOSAL SYSTEM.

PROPERTY OWNER LEROY H HEWITT

ADDRESS 13900 MONTICELLO DRIVE, COOKESVILLE, MD. 21723 PHONE 442-2753

AGENT ~~OR PROSPECTIVE BUYER~~ FISHER COLLINS & CARTER INC.

ADDRESS 9171 Balto. National Ave suite 100 PHONE 461-2855
ELLICOTT CITY MD. 21042

PROPERTY LOCATION:

SUBDIVISION HARLESS MAJOR LOT NO. 22A *Prelim 30 Final 6/19*

ROAD AND DESCRIPTION MONTICELLO DRIVE

TAX MAP DC6 B AND 9 PARCEL # 9,252 and 32A

SIZE OF LOT 1 A.C.± TYPE BLDG. SINGLE FAMILY DETACHM
(SINGLE FAMILY DWELLING OR COMMERCIAL)

THE SYSTEM INSTALLED UNDER THIS APPLICATION IS ACCEPTABLE ONLY UNTIL PUBLIC FACILITIES BECOME AVAILABLE. I FULLY UNDERSTAND THE FEE CONNECTED WITH THE FILING OF THIS PERC TEST APPLICATION IS NON-REFUNDABLE UNDER ANY CIRCUMSTANCES. I ALSO AGREE TO COMPLY WITH ALL M.O.S.H.A. REQUIREMENTS IN TESTING THIS LOT.

Zacharia J. Ficks (agent)
(SIGNATURE OF APPLICANT)

APPROVED BY _____ FOR _____ DATE _____

DISAPPROVED BY _____ FOR _____ DATE _____

HOLD PENDING FURTHER TESTS _____

REASONS FOR REJECTION OR HOLDING _____



PERCOLATION TEST PLAT/PRELIMINARY PLAT - TITLE OR I.D. # _____ DATE _____

SITE DEVELOPMENT PLAN/FINAL PLAT - TITLE OR I.D. # _____ DATE _____




THIS IS NOT A PERMIT

Lot 22A 49888 Hwy 655 Manor
 COUNTY # 6
 Final Lot 19

SOIL PROFILE
 366 A

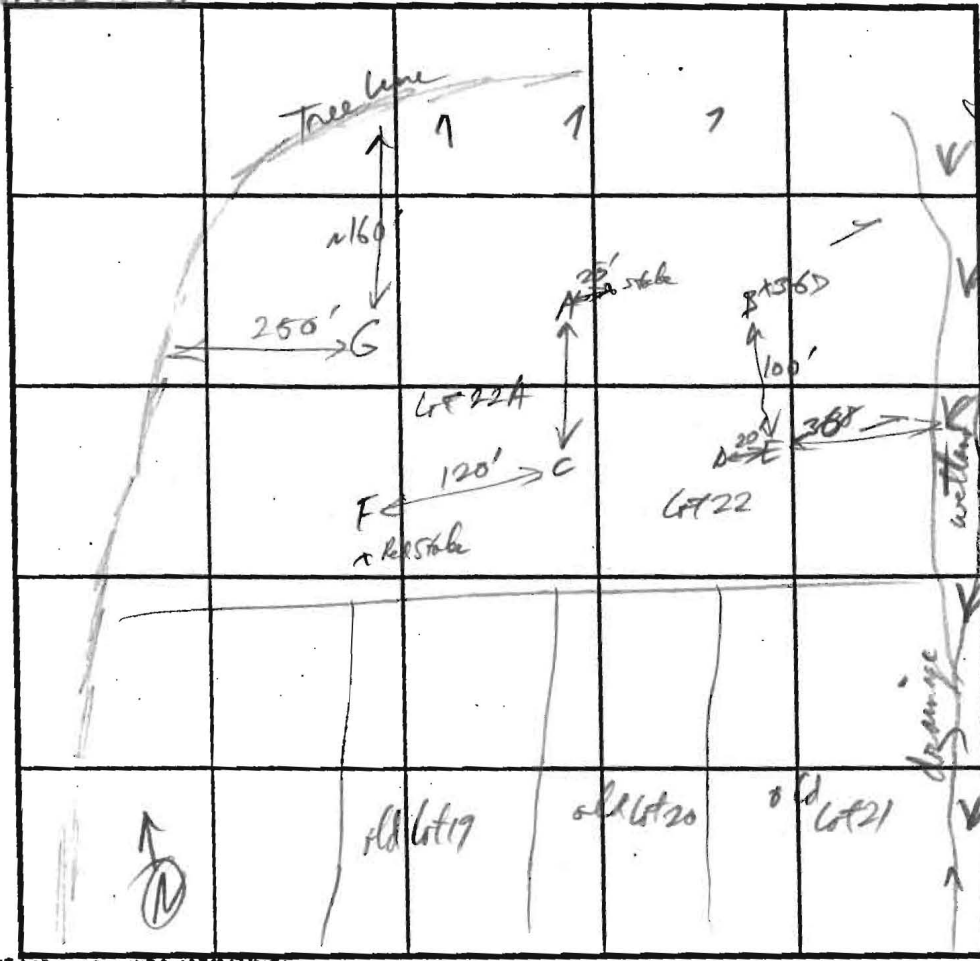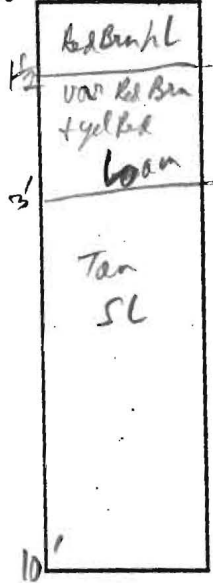

SOIL PROFILE
 365 K

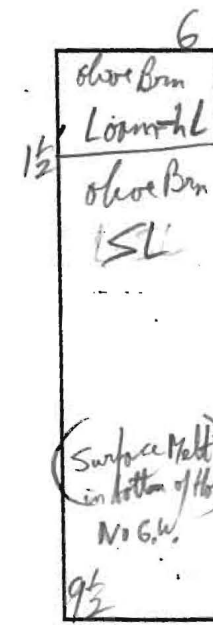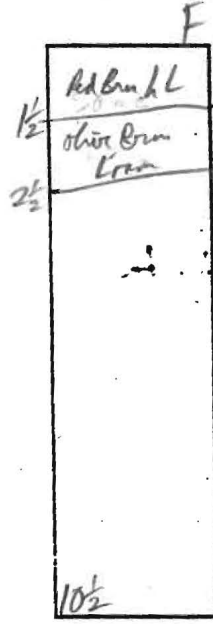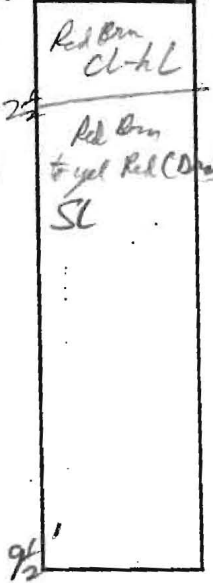


INDICATE NORTH - NAME ADJOINING ROADWAY AS BASE LINE.

DATE	TEST NO.	DEPTH	PRE-WET		TEST - 1" DROP		TIME	
			START	STOP	START	STOP		
3-7-94	F	3'	3:21:50	3:24:00	3:24:00	3:28:00	4 min	OK
		V 10 1/2'						
	6	3'	3:29:00	3:30:20	3:30:20	3:32:25	2 min	OK
		V 9 1/2'						
	366 A	2 1/2'	2:37	2:41	2:41:00	2:45:00	4 min	
		V 10'						
	367 C	3 1/2'	3:08:20	3:10:50	3:10:5	3:15:27	4 1/2 min	
		V 9 1/2' ? better	3:08:40	3:09:40	3:08:40	3:12:08	2 1/2 min	

REMARKS _____
 TYPE OF SOIL 6 hardy - Manor photo
 TESTED BY [Signature] ALSO PRESENT _____
 TRENCH DESIGN DATA: AVERAGE PERCOLATION TIME 4 min TRENCH WIDTH 3
 INLET DEPTH 2 MAXIMUM BOTTOM DEPTH 4 SQ. FT./BEDROOM 180

OAKLAND FARMS
 LOT 1
 PLAT 9306 & 9307
 ZONED: RC-DEO

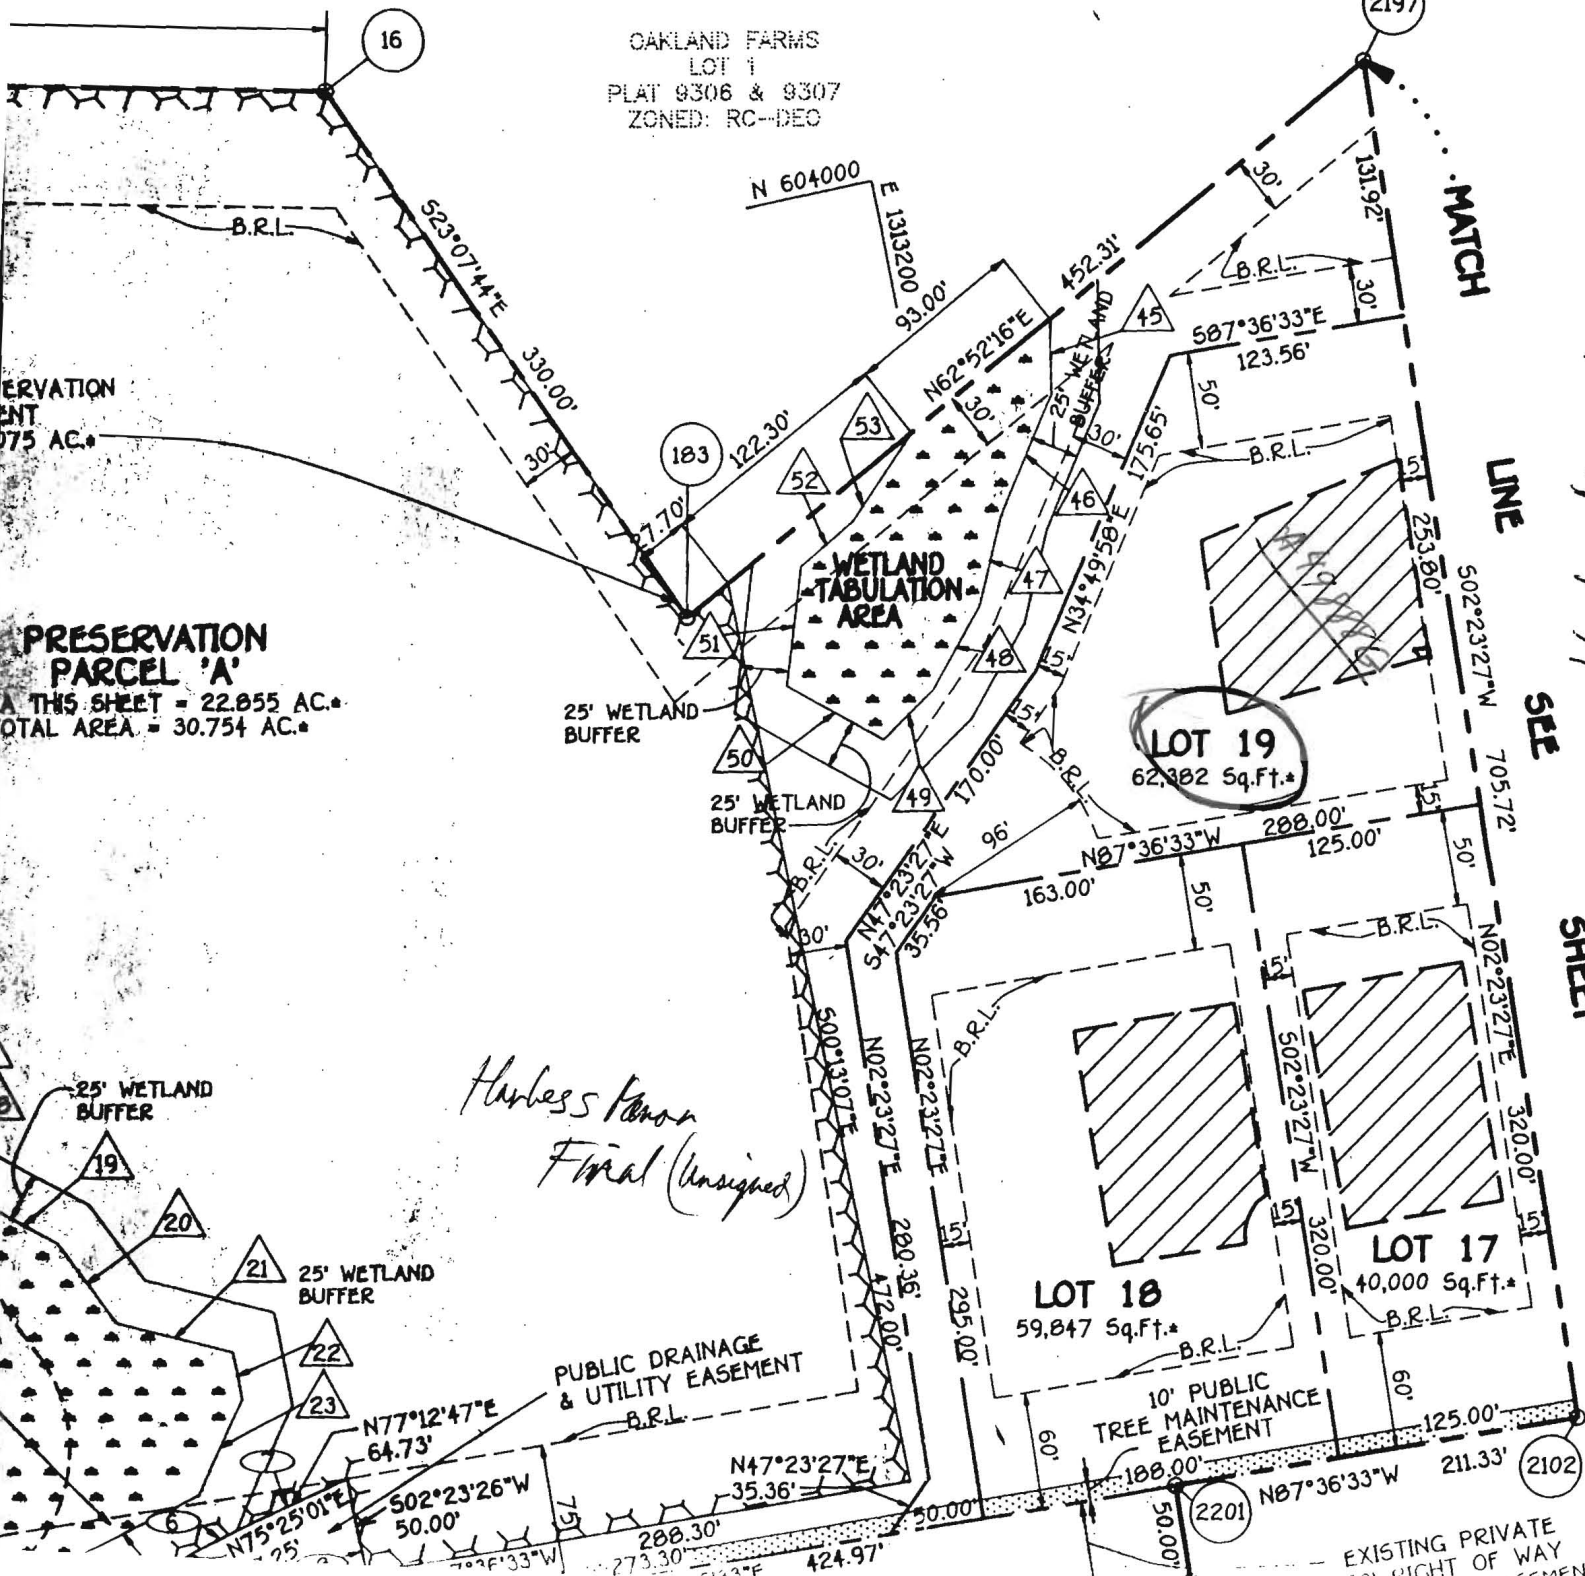

PRESERVATION PARCEL 'A'
 THIS SHEET = 22.055 AC.
 TOTAL AREA = 30.754 AC.

Harless Manor
Final (Unsigned)

ARPA		
SYM.	BEARING & DISTANCE	
▲	576°33'36"W	25.39'
▲	541°21'04"W	52.07'
▲	512°54'49"W	55.27'
▲	523°13'03"E	41.24'
▲	512°33'34"E	60.65'
▲	501°46'55"E	57.95'
▲	522°14'21"E	20.85'
▲	529°49'10"E	37.17'
▲	502°24'55"E	47.29'
▲	563°18'46"E	58.78'
▲	572°08'12"E	77.40'
▲	585°13'43"E	71.27'
▲	513°05'09"W	40.07'
▲	537°47'39"E	60.29'
▲	519°40'43"E	77.27'
▲	570°04'43"E	41.80'
▲	514°37'59"W	46.33'
▲	550°21'23"E	53.54'
▲	550°30'17"E	39.44'
▲	525°05'09"E	51.28'
▲	564°14'04"E	62.21'
▲	500°22'01"E	24.52'
▲	536°31'18"W	53.91'
▲	575°25'01"W	57.80'
▲	578°15'08"W	67.09'
▲	N54°35'12"W	63.00'
▲	N45°35'52"W	71.63'
▲	N03°25'16"E	31.60'
▲	N22°32'07"W	28.69'
▲	S88°33'08"W	64.08'
▲	N66°15'01"W	49.70'
▲	N08°34'54"E	65.18'
▲	N47°10'38"W	64.18'
▲	N30°37'04"W	70.81'
▲	N20°27'03"W	77.31'
▲	N08°59'24"W	101.32'
▲	N03°34'39"E	58.30'
▲	N18°53'33"W	44.11'
▲	N28°22'41"W	73.83'
▲	N33°19'11"W	60.95'
▲	N16°44'57"W	53.66'
▲	N00°44'00"W	52.58'
▲	N08°56'20"W	39.51'
▲	N05°04'37"E	33.07'
▲	S10°31'46"W	38.87'
▲	S34°28'17"W	67.33'
▲	S24°56'59"W	47.50'
▲	S41°00'23"W	48.60'
▲	S57°40'22"W	37.21'
▲	N49°30'40"W	57.56'
▲	N18°18'38"E	61.38'
▲	N61°18'30"E	35.18'
▲	N45°45'24"E	55.07'

EXISTING PRIVATE
 50' RIGHT OF WAY
 EASEMENT


PUBLIC DRAINAGE



HOWARD COUNTY HEALTH DEPARTMENT

Diane L. Matuszak, M.D., M.P.H., County Health Officer

December 12, 2001

TO: Harless Manor Lot Files Still Outstanding
FROM: Mark Rifkin 
RE: Possible Water Quality Issues

On this date, Bert Nixon received a phone call from Eric Dougherty of MDE reporting some abnormally high levels of TDS (total dissolved solids), chloride and calcium in one well on an unidentified lot in Harless Manor. These levels may result in a salty taste to the water.

Applicants pursuing Certificates of Potability on any of the remaining lots are encouraged, but not required, to test for these parameters to avoid adverse reactions from homebuyers.

MR

Signed Prelim Equiv Sctd Plan
Harless Manor

NO. 6 (TYPE 'A')

