

PUB. SEWER STATUS VERIFIED BY \_\_\_\_\_

ISSUE DATE: 7/25/05

P 522997

APPROVAL DATE: 8/1/05

A REPAIR

# PERMIT

## INDEXED

TAX ID# 04-355091

### ON-SITE SEWAGE DISPOSAL SYSTEM HOWARD COUNTY HEALTH DEPARTMENT BUREAU OF ENVIRONMENTAL HEALTH

Fyock Septic Service, Inc. IS PERMITTED TO INSTALL  ALTER

ADDRESS: PO Box 89, Glenelg, MD 21737 PHONE NUMBER: 410-531-2939

SUBDIVISION: Choi Property LOT NUMBER: 12

ADDRESS: 3367 Danmark Drive PROPERTY OWNER: Terry Mcaulay

SEPTIC TANK CAPACITY (GALLONS): 1500

PUMP CHAMBER CAPACITY (GALLONS): NIA

NUMBER OF BEDROOMS: \_\_\_\_\_

SQUARE FEET PER BEDROOM: \_\_\_\_\_

LINEAR FEET OF TRENCH REQUIRED: \_\_\_\_\_

TRENCHES:	Trench to be _____ feet wide. Inlet _____ feet below original grade. Bottom maximum depth _____ feet below original grade. Effective area begins at _____ feet below original grade. _____ feet of stone below distribution pipe.
LOCATION:	<b>SEPTIC TANK TO BE REPLACED.</b>
PURPOSE:	<del>Existing septic system has failed.</del> Call for inspection when ground is opened so sanitarian can recommend repair.

PLANS APPROVED: \_\_\_\_\_ DATE: \_\_\_\_\_

- NOTE: PERMIT VOID AFTER 2 YEARS
- NOTE: CONTRACTOR RESPONSIBLE FOR SCHEDULING A PRE-CONSTRUCTION INSPECTION FOR ALL INSTALLATIONS
- NOTE: WATERTIGHT SEPTIC TANKS REQUIRED
- NOTE: ALL PARTS OF SEPTIC SYSTEM SHALL BE 100 FEET FROM ANY WATER WELL
- NOTE: MANHOLE RISERS REQUIRED ON ALL SEPTIC TANKS AND PUMP CHAMBERS

**NEITHER THE HOWARD COUNTY COUNCIL OR THE HEALTH DEPARTMENT IS RESPONSIBLE FOR THE SUCCESSFUL OPERATION OF ANY SYSTEM PERMITTEE RESPONSIBLE FOR OBTAINING FINAL APPROVAL ON THIS PERMIT**


**BUILDING PERMIT SIGNED** CALL 410-313-2640 FOR INSPECTION OF SEPTIC SYSTEM

**AND RETURNED**

8/3/05 BO155284 - FINISH BASEMENT

P 522997

NOT TO SCALE

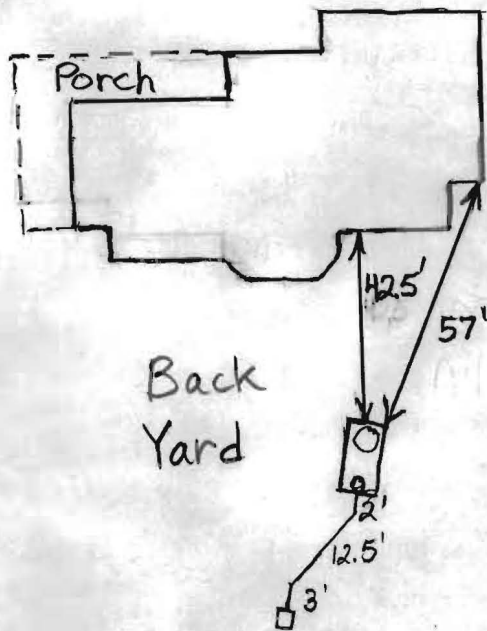

ROAD

TRENCH/DRAINFIELD DATA		
WIDTH	INLET	BOTTOM
_____	_____	_____
NUMBER OF TRENCHES _____		
TOTAL LENGTH _____		
ABSORPTION AREA _____		
DISTRIBUTION BOX LEVEL _____		
DISTRIBUTION BOX BAFFLE <u>Yes</u>		
DISTRIBUTION BOX PORT <u>No</u>		

SEPTIC TANK DATA		
SEPTIC TANK 1 LEVEL <u>Yes</u>		
CAPACITY	<u>1500</u>	GAL
SEAM LOC	<u>Top</u>	
TANK LID DEPTH	<u>1'-1.5'</u>	
BAFFLES	<u>Yes</u>	
BAFFLE FILTER	<u>No</u>	
MANHOLE LOC	<u>Front</u>	
6" PORT LOC	<u>Rear</u>	
WATERTIGHT TEST	<u>No</u>	
<del>SEPTIC TANK 2 LEVEL <u>N/A</u></del>		
<del>CAPACITY _____ GAL</del>		
<del>SEAM LOC _____</del>		
<del>TANK LID DEPTH _____</del>		
<del>BAFFLES _____</del>		
<del>BAFFLE FILTER _____</del>		
<del>MANHOLE LOC _____</del>		
<del>6" PORT LOC _____</del>		
<del>WATERTIGHT TEST _____</del>		

PRE-CONSTRUCTION \_\_\_\_\_

INSTALLATION 7/28/05 New tank set. Old tank pumped out and filled in. Robert to put manhole cleanout on front of tank.

BB

BUILDING PERMIT SIGNED  
AND RETURNED

FINAL INSPECTOR B. Baker

DATE OF APPROVAL 8/1/05



# HOWARD COUNTY HEALTH DEPARTMENT

05 22997

DATE  
7 / 25 / 05

Received From Hyack Septic Service Inc PHONE # 410-531-2937

PO Box 89, Glenly MD 21737

For Septic Permit - Tank Replacement

CASH  
 CHECK

3367 Danmark Drive

NO.

1404

One hundred sixty-five and 00/100 Dollars

\$

165 00

Received By Mary L Buggin