

Howard County
Permit

App 27-11-74

PERMIT

19643

18462

SEWAGE DISPOSAL SYSTEM

MARYLAND STATE DEPARTMENT OF HEALTH

HOWARD COUNTY

ELLICOTT CITY

INDEXED

DISTRICT 5

DATE 3/12/74

Frederick C. Dickson

IS PERMITTED TO INSTALL ALTER

ADDRESS 13985 Rt. 108 - Highland, Md.

PHONE 286-2661

A SEWAGE DISPOSAL SYSTEM LOCATED AT

SUBDIVISION

ROAD Rt. 108 (see appl. for better directions) LOT

PROPERTY OWNER SAME AS ABOVE

ADDRESS

SPECIFICATIONS 1 bedroom

DRAIN FIELD DEPTH FEET, BOTTOM AREA SQ. FT.

SEEPAGE PITS ABSORBENT SIDE-WALL AREA SQ. FT.

SEPTIC TANK CAPACITY 1,000 GALLONS

FOR GARBAGE GRINDER, INCREASE DISPOSAL AREA 22% & TANK CAPACITY 50%

OTHER Dry well to have 115 sq. ft. effective absorbent sidewall area per bedroom

below inlet. Inlet to be 3 ft. below original grade and max. depth 11 ft. Location

per certified plat 90 ft. from right side line of property and 40 ft. in from front

of lot when facing lot from front where right-of-way is indicated on certified plat.

NOTE: ALL PIPE FROM HOUSE TO DRY WELL MUST BE CAST IRON.

PERMIT VOID AFTER THREE YEARS

NOTE: INSTALL STAND PIPE ON SEPTIC TANK AND DRY WELL.


PLANS APPROVED BY C. Streaker DATE 3/10/74

FILL SEPTIC TANK AND DISTRIBUTION BOX WITH WATER BEFORE CALLING FOR AN INSPECTION. COVER NO WORK UNTIL INSPECTED AND APPROVED.

NEITHER THE HOWARD COUNTY COMMISSIONERS NOR THE HEALTH DEPARTMENT IS RESPONSIBLE FOR THE SUCCESSFUL OPERATION OF ANY SYSTEM.

A18462

DATE SYSTEM APPROVED INSPECTOR

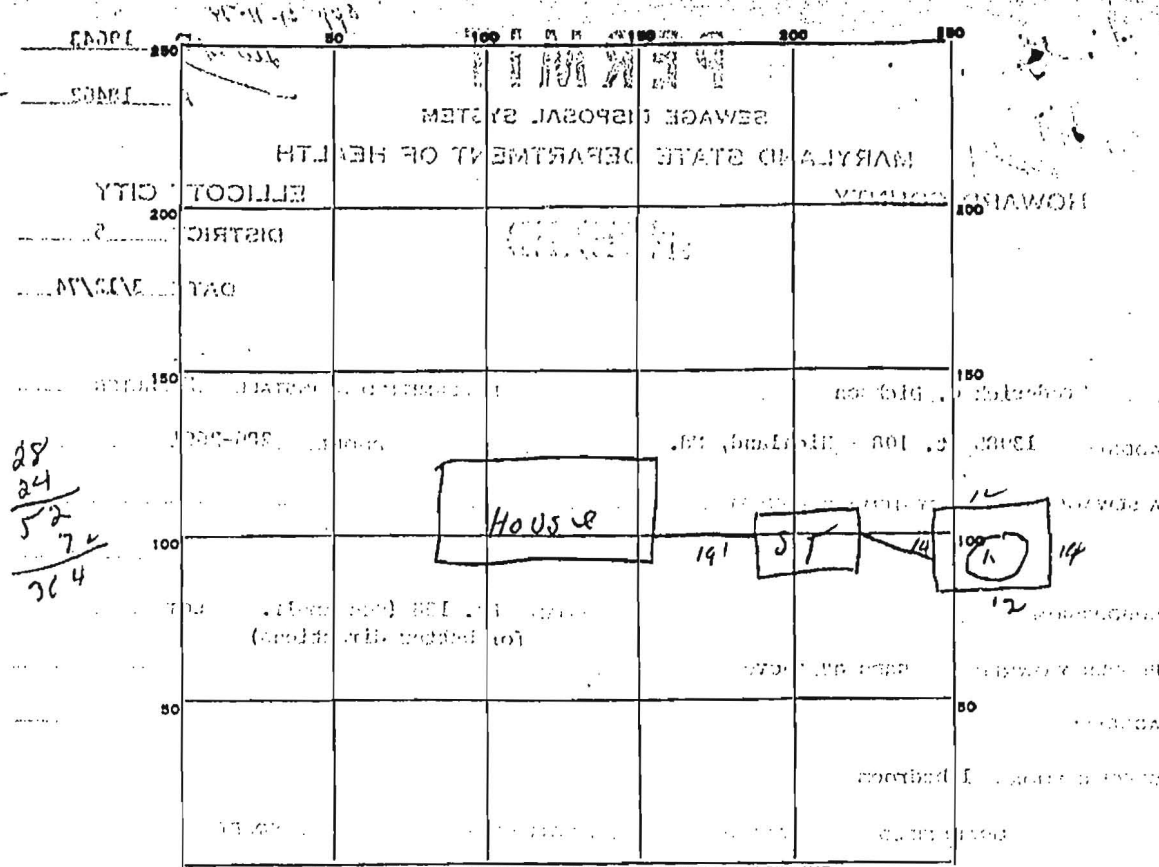

INDICATE NORTH. - NAME ADJOINING ROADWAY AS BASE LINE.

PERMIT CARD OK

SEPTIC TANK, LEVEL OK CLEANOUTS OK

DISTRIBUTION BOX, LEVEL _____

TILE FIELD, DEPTH _____ FT. TRENCH WIDTH _____ FT.

GRAVEL DEPTH _____ IN. TOTAL LENGTH _____ FT.

NUMBER OF TRENCHES _____ TOTAL BOTTOM AREA _____

SEEPAGE PITS, INSIDE DIAMETER Perimeter 52 FT. DEPTH BELOW INLET 72 FT.

ABSORBENT AREA 364 SQ. FT.

REMARKS _____

DATE SYSTEM APPROVED 4-11-74 INSPECTOR Bill Managhen