

Preliminary

APPLICATION

A 18462

SEWAGE DISPOSAL TESTING

P _____

STATE OF MARYLAND - DEPARTMENT OF HEALTH AND MENTAL HYGIENE

HOWARD COUNTY HEALTH DEPARTMENT
ENVIRONMENTAL HEALTH SERVICES
P. O. BOX 476, ELLICOTT CITY, MARYLAND 21043
TELEPHONE: 463-5000, EXT. 386

DISTRICT 5th
DATE April 22, 1973

TO: THE COUNTY HEALTH OFFICER
ELLICOTT CITY, MARYLAND

I, HEREBY, APPLY FOR THE NECESSARY TEST IN ORDER TO CONSTRUCT (OR RECONSTRUCT) A SEWAGE DISPOSAL SYSTEM.

PROPERTY OWNER Eliza F. Cox and Geraldine W. Cox

ADDRESS Route #108, Highland, Maryland 20777 PHONE 924-2541

PROPERTY LOCATION:

SUBDIVISION _____ LOT NO. _____

ROAD AND DESCRIPTION last visible house from road on left side of Route #108, before reaching Montgomery County Line

SIZE OF LOT 65 plus acres TYPE BLDG. 4 bedroom
NUMBER OF BEDROOMS

IF NOT SINGLE RESIDENCE DESCRIBE _____

THE SYSTEM INSTALLED UNDER THIS APPLICATION IS ACCEPTABLE ONLY UNTIL PUBLIC FACILITIES BECOME AVAILABLE.

SIGNATURE OF APPLICANT *Eliza F. Cox*
Eliza F. Cox

APPROVED BY _____ FOR _____ DATE _____
(KIND OF SYSTEM)

REJECTED BY _____ FOR _____ DATE _____
(KIND OF SYSTEM)

HOLD PENDING FURTHER TESTS _____ DATE _____

REASONS FOR REJECTION OR HOLDING _____

THIS IS NOT A PERMIT

APPLICATION

	(1+2)	(3)	(4+5) see H

INDICATE NORTH - NAME ADJOINING ROADWAY AS BASE LINE.

PX 108 P.H. Test was back off rd.

DATE	TEST NO.	DEPTH	PRE-WET		TEST - 1" DROP		TIME
			START	STOP	START	STOP	
6/1/73	1	3' s	10:32	10:36	10:36	10:42	6
	2	11' 0	10:34	10:37	10:37	10:45	8m
	3	8 1/2' s	Visual similar		7		1+2
	4	2 1/2' s	10:47	10:50	10:50	10:55	5m
	5	10 1/2' 0	10:49	10:51	10:51	10:58	9m
	6	9'	Visual similar		7		4+5


2nd
3rd

checked
3'

115 sq ft per hole

REMARKS: Hold low concentrations of holes
 TYPE OF SOIL: Mica + loose Notes: per in open field High

#1877 Francis Dickson
8-14-73

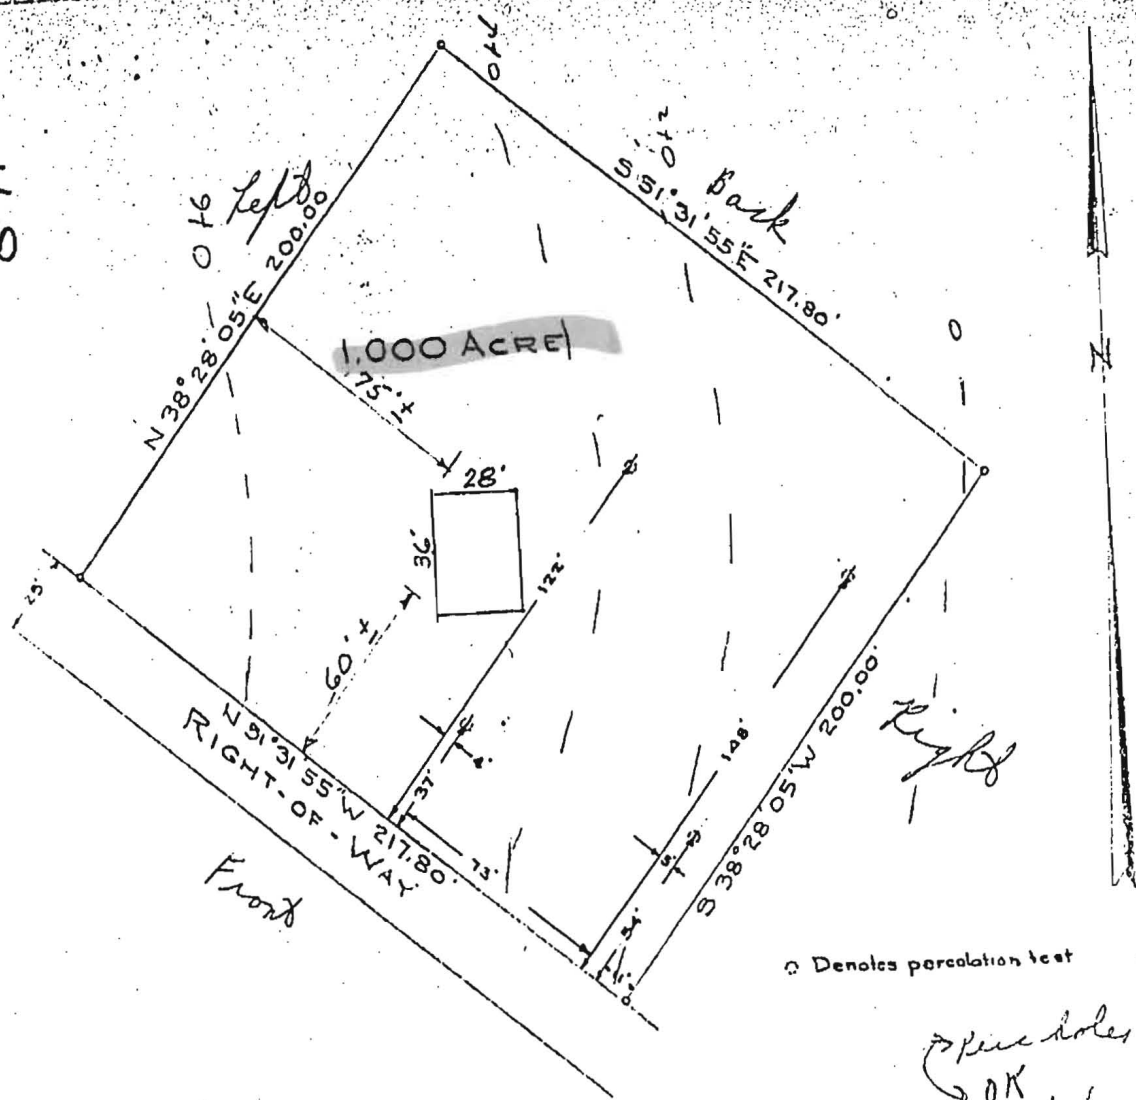

○ Denotes percolation test

Percolation test
OK
9/7/73


PLAT OF SURVEY
 FOR
ROBERT A. DICKSON
 FIFTH ELECTION DISTRICT, HOWARD COUNTY,
 HIGHLAND, MARYLAND
 SCALE: 1" = 50 FT. JULY 7, 1973

Note: The lot shown hereon complies with the minimum lot area and ownership as required by the Maryland State Health Department

Approved: Private Water and Private Sewer

Howard County Health Officer _____ Date _____

Charles M. [Signature]
A 3658 B

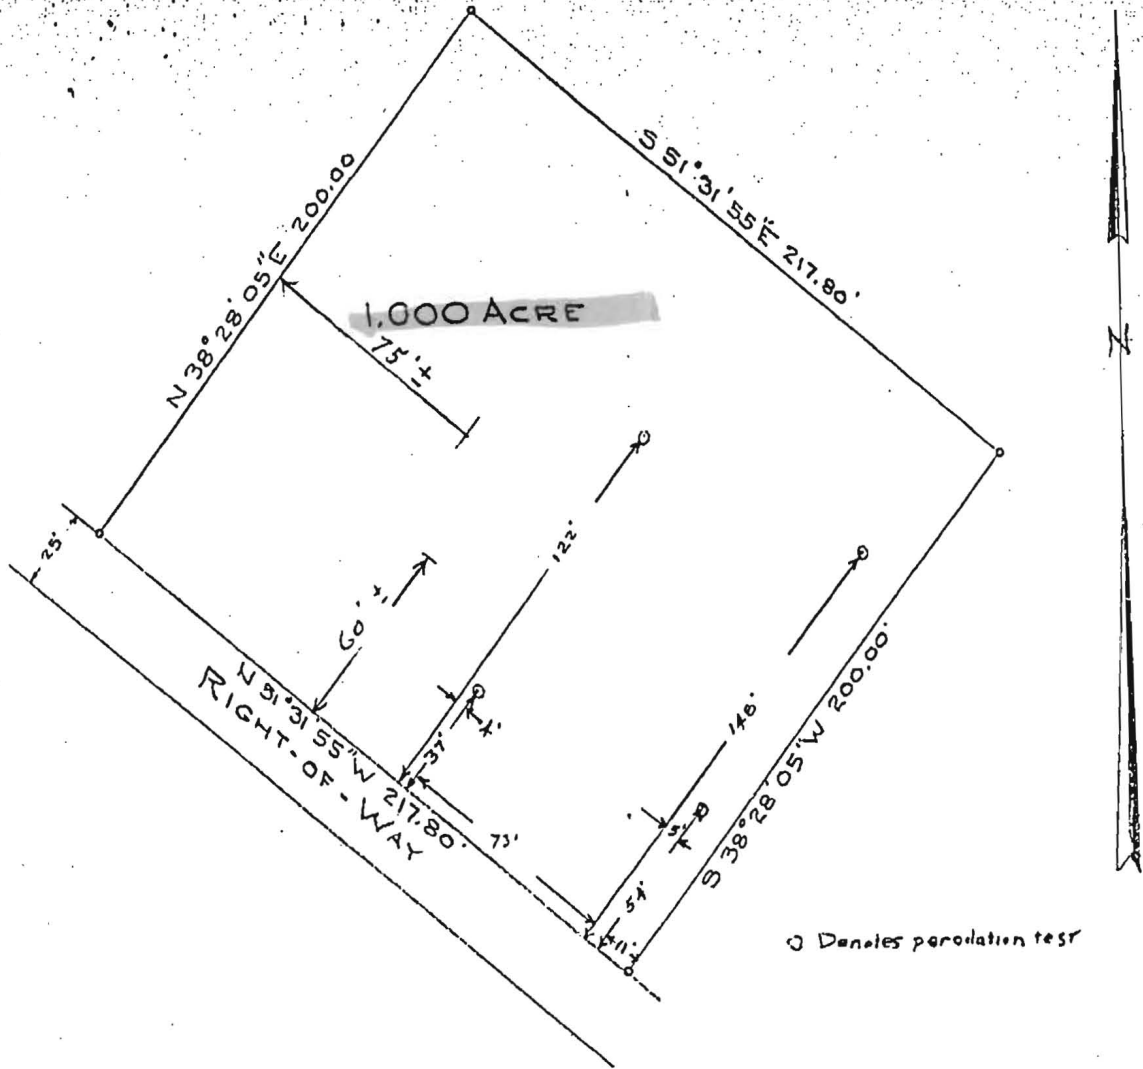

PLAT OF SURVEY
FOR

ROBERT A. DICKSON
FIFTH ELECTION DISTRICT, HOWARD COUNTY,
HIGHLAND, MARYLAND
SCALE: 1 IN = 50 FT. JULY 7, 1973

Note: The lot shown hereon complies with the minimum lot area and ownership as required by the Maryland State Health Department

Approved: Private Water and Private Sewer

[Signature]
Howard County Health Officer

9/10/73
Date



[Signature]
A 3658-B