

9/1/66  
9/6/66 - after  
12

9/1/66 - Not ready - JHK  
T.C.C. approved - *Bev*

# PERMIT

P 12102

SEWAGE DISPOSAL SYSTEM

A 04469

MARYLAND STATE DEPARTMENT OF HEALTH

HOWARD COUNTY TAX ID 05362334

ELLICOTT CITY

INDEXED

DISTRICT 5

DATE 8/17/66

Walter A. Shank IS PERMITTED TO INSTALL  ALTER

ADDRESS Folly Quarter Rd., Ellicott City, Md. PHONE 286-3410

A SEWAGE DISPOSAL SYSTEM LOCATED AT \_\_\_\_\_

SUBDIVISION Harland Hills ROAD Brighton Dan LOT 30, Plat 2

PROPERTY OWNER G. R. Canby & Francis Miller

ADDRESS \_\_\_\_\_

SPECIFICATIONS - 4 bedrooms

DRAIN FIELD \_\_\_\_\_ DEPTH \_\_\_\_\_ FEET, BOTTOM AREA \_\_\_\_\_ SQ. FT.

SEEPAGE PITS \_\_\_\_\_ ABSORBENT SIDE-WALL AREA \_\_\_\_\_ SQ. FT.

SEPTIC TANK CAPACITY 1,600 GALLONS

FOR GARBAGE GRINDER, INCREASE DISPOSAL AREA 22% & TANK CAPACITY 50%.

OTHER Dry well - 402 sq. ft. absorbent sidewall area below inlet pipe for 4 bedrooms.

Place the dry well 138 ft. to 158 ft. from the front lot line and 86 ft. to 106 ft. from the right side of the lot as seen when facing the lot from the road.

PLANS APPROVED BY D. W. Monaghan DATE 11/7/61


FILL SEPTIC TANK AND DISTRIBUTION BOX WITH WATER BEFORE CALLING FOR AN INSPECTION. COVER NO WORK UNTIL INSPECTED AND APPROVED.

NEITHER THE HOWARD COUNTY COMMISSIONERS NOR THE HEALTH DEPARTMENT IS RESPONSIBLE FOR THE SUCCESSFUL OPERATION OF ANY SYSTEM.

## NOTIFY THE HEALTH DEPARTMENT 48 HOURS BEFORE EXCAVATIONS ARE TO BE BACK FILLED.

*004469*

$$\begin{array}{r} 357.6 \\ 11 \\ \hline 376 \\ 376 \\ \hline 413.6 \\ 57.6 \frac{1}{3} \\ \hline 148 \\ 26 \\ \hline 39.48 \end{array}$$

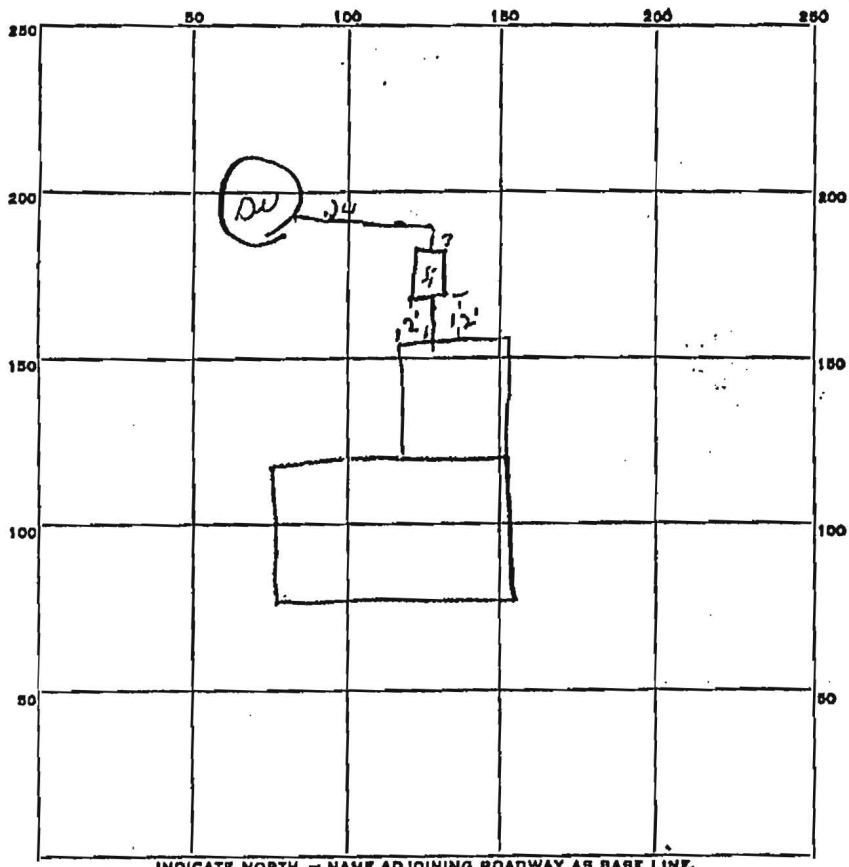

INDICATE NORTH. - NAME ADJOINING ROADWAY AS BASE LINE.

PERMIT CARD OK Brighton Dam Rd  
 SEPTIC TANK, LEVEL OK CLEANOUTS OK  
 DISTRIBUTION BOX, LEVEL \_\_\_\_\_  
 TILE FIELD, DEPTH \_\_\_\_\_ FT. TRENCH WIDTH \_\_\_\_\_ FT.  
 GRAVEL DEPTH \_\_\_\_\_ IN. TOTAL LENGTH \_\_\_\_\_ FT.  
 NUMBER OF TRENCHES \_\_\_\_\_ TOTAL BOTTOM AREA \_\_\_\_\_  
 SEEPAGE PITS, INSIDE DIAMETER 12 FT. DEPTH BELOW INLET 10 1/2 FT.  
 ABSORBENT AREA 394.8 SQ. FT.

REMARKS 9/1/66 - not ready - need pipe from house to tank  
and from tank to well - also cleanout of well  
9/6/66 - system has 6" or more around Dec 61

DATE SYSTEM APPROVED 9-6-66 INSPECTOR W. Monaghan