

APPLICATION

A 23988

SEWAGE DISPOSAL TESTING

P _____

STATE OF MARYLAND - DEPARTMENT OF HEALTH AND MENTAL HYGIENE

HOWARD COUNTY HEALTH DEPARTMENT
ENVIRONMENTAL HEALTH SERVICES
P. O. BOX 476, ELLICOTT CITY, MARYLAND 21043
TELEPHONE: 465-5000, EXT. 356

DISTRICT Fifth

DATE 9/15/76

TO: THE COUNTY HEALTH OFFICER
ELLICOTT CITY, MARYLAND

I, HEREBY, APPLY FOR THE NECESSARY TEST IN ORDER TO CONSTRUCT (OR RECONSTRUCT) A SEWAGE DISPOSAL SYSTEM.

PROPERTY OWNER Mr. Walter Bucher Highland Lake

ADDRESS Highland Partnership
8777 First Avenue PHONE (8) 588-3100
Silver Spring, MD 20901

PROPERTY LOCATION:

SUBDIVISION Highland Lake LOT NO. 40 [#] 40

ROAD AND DESCRIPTION Holly Loch Lane

SIZE OF LOT one acre m/l TYPE BLDG. 3 or 4 bedroom
NUMBER OF BEDROOMS _____

IF NOT SINGLE RESIDENCE DESCRIBE _____

THE SYSTEM INSTALLED UNDER THIS APPLICATION IS ACCEPTABLE ONLY UNTIL PUBLIC FACILITIES BECOME AVAILABLE.

SIGNATURE OF APPLICANT /s/ Mr. Walter Bucher

APPROVED BY _____ FOR _____ DATE _____
(KIND OF SYSTEM)


REJECTED BY _____ FOR _____ DATE _____
(KIND OF SYSTEM)

HOLD PENDING FURTHER TESTS _____ DATE _____

REASONS FOR REJECTION OR HOLDING _____

THIS IS NOT A PERMIT

Gave the Dimensions to Burdette by phone
 A23988

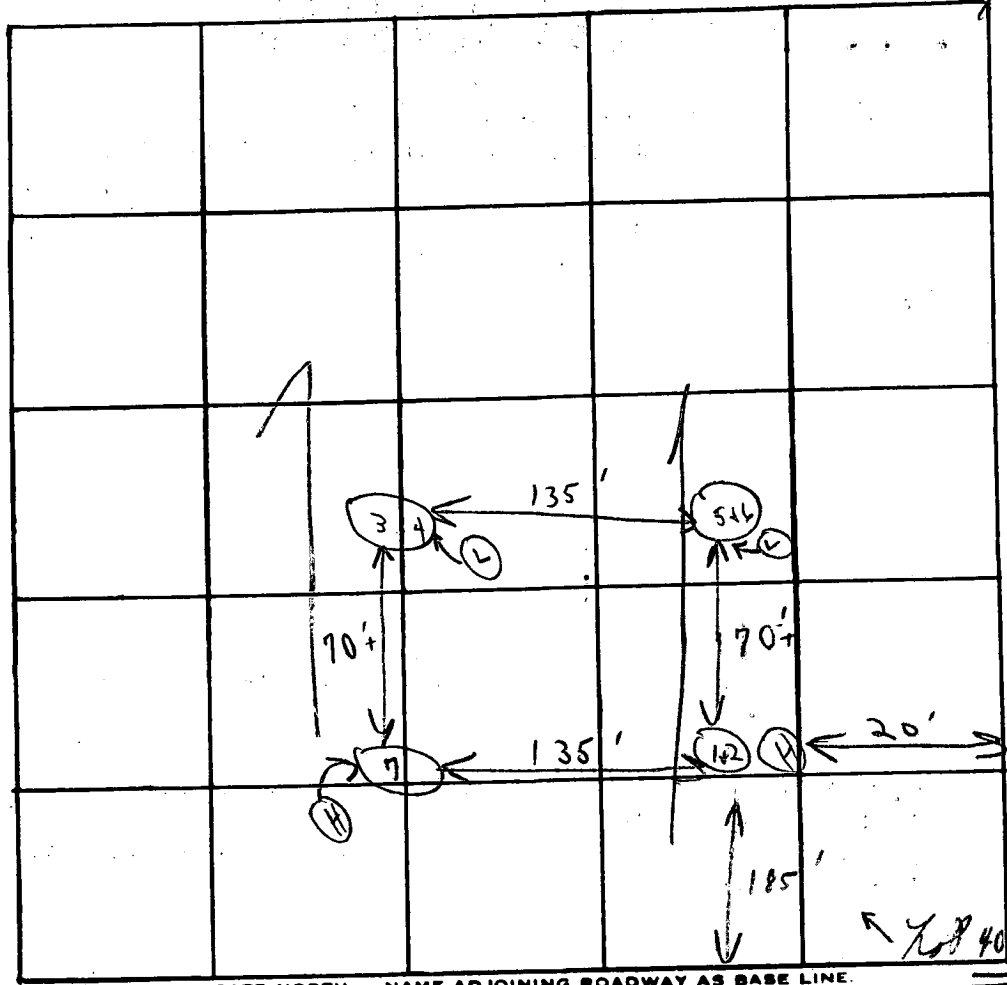

INDICATE NORTH. - NAME ADJOINING ROADWAY AS BASE LINE.

R216

#25

New #29

Hyland

DATE	TEST NO.	DEPTH	PRE-WET		TEST - 1" DROP		TIME
			START	STOP	START	STOP	
5/7/76	Clay 1-5 1/2	4'	11:46	11:47	11:47	11:50	3 in
	(H) 2	12'	11:45	11:47	11:47	11:51	4 in
12 1/2	Clay 1-4'	4'	11:20	11:21	11:21	11:24	3 in
	(L) 4	12 1/2'	11:20	11:23	11:23	11:33	10 in
12'	Clay 1-3	3'	11:36	11:39	11:39	11:44	5 in
	(L) 6	12'	11:35	11:36	11:36	11:38	2 in
	(H) 7	12 1/2'	Visual similar to other				5 in
			1-4" clay		6		27

12' {
 12 1/2 {
 12' {

160 g of soil
 water 4'

5 in

REMARKS Open field
 TYPE OF SOIL Sandy loam
 TESTED BY C.B.S. ALSO PRESENT: Ketterman