

LAYOUT 8/17/05 INSP 4 _____
 INSP 2 8/18/05 INSP 5 _____
 INSP 3 _____ INSP 6 _____

ISSUE DATE: 8/15/05
 APPROVAL DATE: 8/18/05

P 523131
 A 513618-T

PERMIT
 INDEXED

TAX ID #05-436362

**ON-SITE SEWAGE DISPOSAL SYSTEM
 HOWARD COUNTY HEALTH DEPARTMENT
 BUREAU OF ENVIRONMENTAL HEALTH**

Hatfield's Equipment IS PERMITTED TO INSTALL ALTER

ADDRESS: 13785 Burntwoods Road PHONE NUMBER: 410-531-6773

SUBDIVISION: Buckskin Ridge LOT NUMBER: 19

ADDRESS: 4285 Buckskin Wood Drive PROPERTY OWNER: Columbia Builders, Inc.

SEPTIC TANK CAPACITY (GALLONS): 1500 OUTLET BAFFLE FILTER REQUIRED

PUMP CHAMBER CAPACITY (GALLONS): _____ COMPARTMENTED TANK REQUIRED

NUMBER OF BEDROOMS: 5

SQUARE FEET PER BEDROOM: 180

LINEAR FEET OF TRENCH REQUIRED: 150 HOUSE SERVED BY PUBLIC WATER

TRENCHES:	Trench to be 3.0 feet wide. Inlet 3.0 feet below original grade. Bottom maximum depth 7.0 feet below original grade. Effective area begins at 4.0 feet below original grade. 4.0 feet of stone below distribution pipe.
LOCATION:	Place the distribution box in the northwest corner at the highest elevation and run 2-75' trenches.
NOTES:	No basement gravity service.

PLANS APPROVED: Pete Yencsik Reviewed by: [Signature] DATE: 2/1/05

NOTES: PERMIT VOID AFTER 2 YEARS
 CONTRACTOR IS RESPONSIBLE FOR SCHEDULING A PRE-CONSTRUCTION INSPECTION FOR ALL INSTALLATIONS
 WATERTIGHT SEPTIC TANKS REQUIRED
 ALL PARTS OF SEPTIC SYSTEM SHALL BE 100 FEET FROM ANY WATER WELL UNLESS SPECIFICALLY AUTHORIZED
 MANHOLE RISERS REQUIRED ON ALL SEPTIC TANKS AND PUMP CHAMBERS UNLESS SPECIFICALLY AUTHORIZED
 CONTRACTOR RESPONSIBLE FOR COMPLIANCE WITH APPLICABLE REGULATIONS, GUIDELINES AND THE TERMS OF THIS PERMIT


NEITHER THE HOWARD COUNTY COUNCIL NOR THE HEALTH DEPARTMENT IS RESPONSIBLE FOR THE SUCCESSFUL OPERATION OF ANY SYSTEM PERMITTEE RESPONSIBLE FOR OBTAINING FINAL APPROVAL ON THIS PERMIT

BUILDING PERMIT SIGNED AND RETURNED

4/24/06 BOO 159 229-DECK/SCREENED POLE

P-523131

NOT TO SCALE

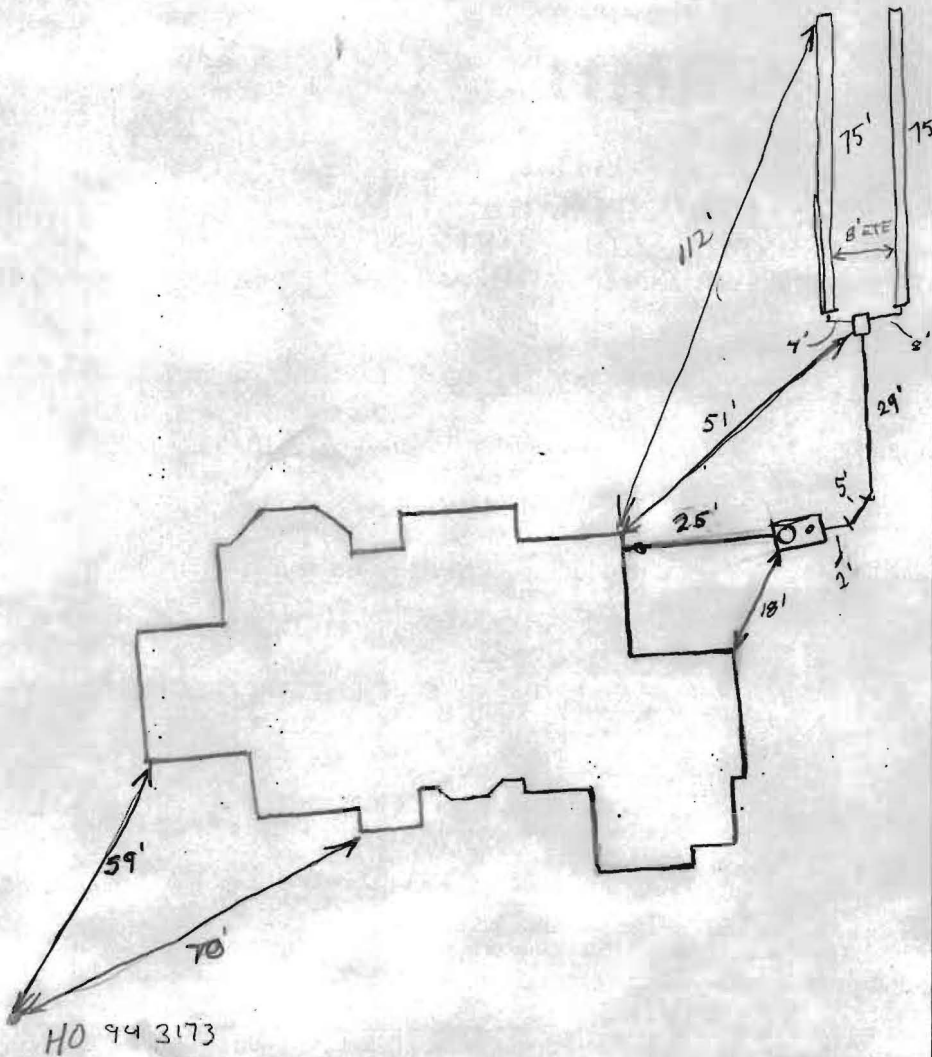

TRENCH/DRAINFIELD DATA		
WIDTH	INLET	BOTTOM
3	3 1/2-3	7 1/2-7'
NUMBER OF TRENCHES	2	
TOTAL LENGTH	150	
ABSORPTION AREA	900 sq ft	
DISTRIBUTION BOX LEVEL	speed Levelers	
DISTRIBUTION BOX BAFFLE	✓	
DISTRIBUTION BOX PORT	✓	

SEPTIC TANK DATA		
SEPTIC TANK 1 LEVEL	✓	
2 ^{comp} _{Boylston} CAPACITY	1500	GAL
SEAM LOC	Top	
TANK LID DEPTH	3'	
BAFFLES	✓	
BAFFLE FILTER	N/A	
MANHOLE LOC	Inlet	
6" PORT LOC	Outlet	
WATERTIGHT TEST	N/A	
SEPTIC TANK 2 LEVEL		
CAPACITY	_____	GAL
SEAM LOC	_____	
TANK LID DEPTH	_____	
BAFFLES	_____	
BAFFLE FILTER	_____	
MANHOLE LOC	_____	
6" PORT LOC	_____	
WATERTIGHT TEST	_____	

Buckskin Wood Drive

PRE-CONSTRUCTION ^{8/17/05} Install 2 x 75' trenches along top of easement on contour.

ok to make uppermost trench 1/2' deeper inlet and bottom to use

INSTALLATION very top of area and make gravity. **GAC**

8/18/05 Trenches installed exactly as instructed. OK to cover

GAC

BUILDING PERMIT SIGNED
AND RETURNED

FINAL INSPECTOR


Devin A. Creyer

DATE OF APPROVAL

8/18/05


GENERAL NOTES:

- 1) THIS LOCATION DRAWING IS PREPARED FOR THE BENEFIT OF THE CLIENT SIGNING THE HOUSE LOCATION SURVEY APPROVAL FORM INsofar AS IT IS REQUIRED BY A LENDER OR TITLE INSURANCE COMPANY OR ITS AGENTS IN CONNECTION WITH THE CONTEMPLATED TRANSFER, FINANCING OR REFINANCING OF THE PROPERTY SHOWN HEREON. UNLESS INDICATED AS BEING A BOUNDARY SURVEY, THIS LOCATION DRAWING IS NOT INTENDED FOR USE IN THE ESTABLISHMENT OF PROPERTY LINES AND IS NOT TO BE RELIED UPON FOR THE ESTABLISHMENT OR LOCATIONS OF FENCES, GARAGES, BUILDINGS OR OTHER EXISTING OR FUTURE IMPROVEMENTS. AS A RESULT, THIS LOCATION DRAWING DOES NOT PROVIDE FOR ACCURATE IDENTIFICATION OF PROPERTY LINES, BUT SUCH IDENTIFICATION MAY NOT BE REQUIRED FOR THE TRANSFER OF TITLE OR SECURING FINANCING FOR RE-FINANCING.
- 2) SUBJECT PROPERTY IS SHOWN IN ZONE C ON THE NATIONAL FLOOD INSURANCE PROGRAM FLOOD INSURANCE RATE MAP OF HOWARD COUNTY, MARYLAND, COMMUNITY PANEL No. 2400440021B EFFECTIVE DEC. 4, 1986.
- 3) THE OFFSETS FROM BUILDING LINE TO PROPERTY LINE AS SHOWN ON THE PLAT HEREON ARE TO AN ACCURACY OF PLUS OR MINUS 0.2' (+)
- 4) NO TITLE REPORT FURNISHED. SUBJECT TO ALL EASEMENTS, RIGHTS OF WAY AND CONDITIONS OF RECORD.
- 5) THE EXISTING WELL SHOWN ON THIS PLAN (IDENTIFIED WITH THE ATTACHED WELL TAG NUMBER HO-94-3173) HAS BEEN FIELD LOCATED BY FISHER, COLLINS AND CARTER, INC. PROFESSIONAL LAND SURVEYORS AND IS ACCURATELY SHOWN.

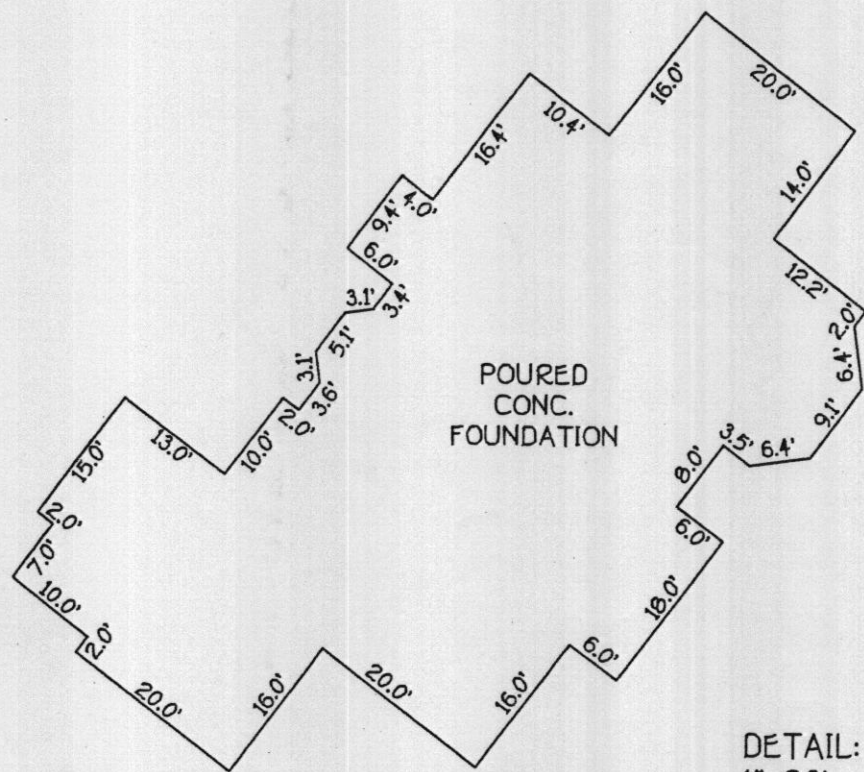

Mark L. Robel 6/03/05
 PROFESSIONAL LAND SURVEYOR DATE
 REG. #339

4285 BUCKSKIN WOOD DRIVE
 B.R.L. = BUILDING RESTRICTION LINE
 TOP OF FOUNDATION ELEV. = 628.3'

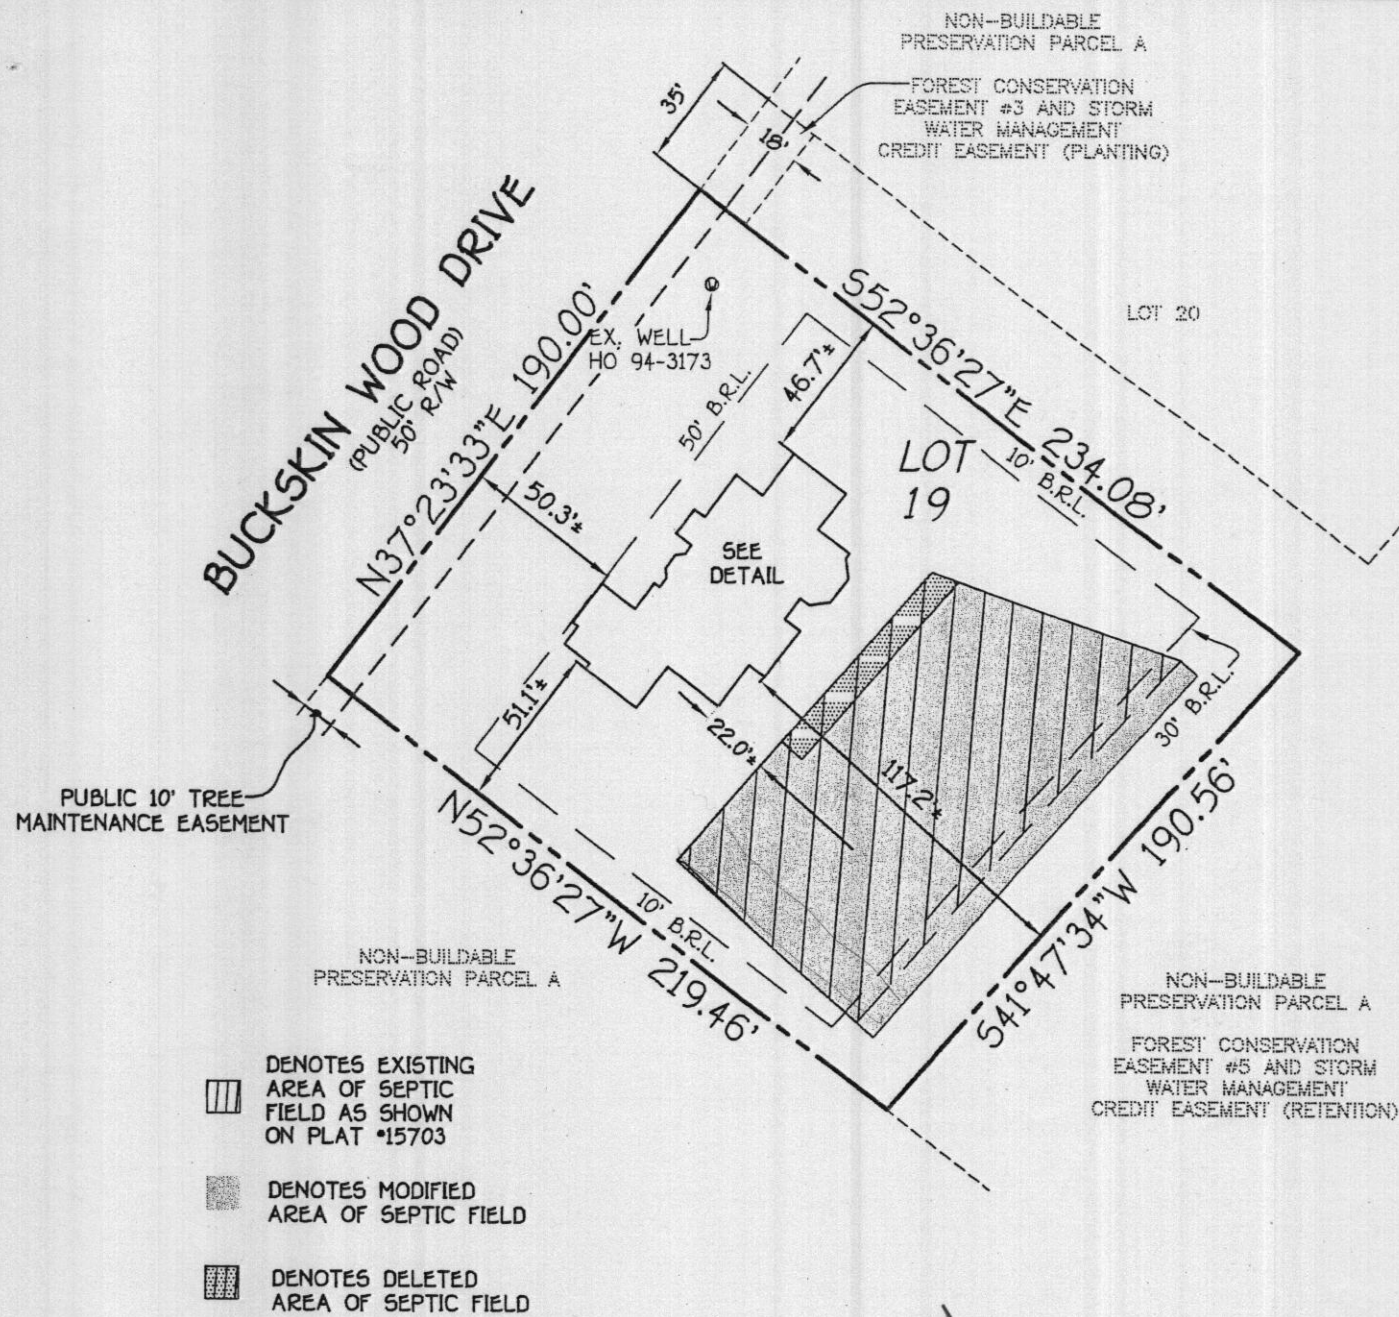

HOUSE LOCATION DRAWING

FOUNDATION LOCATION: 5/13/05
 FINAL LOCATION: _____
 BOUNDARY SURVEY: _____


SCALE: 1"=60'
 DATE: 06/03/05
 DRAWN BY: VLJ
 CHECKED BY: MLR
 PROJECT No.: 61700

Wall + well checked O.K.

LOT 19
 REVISION PLAT
 BUCKSKIN RIDGE
 LOTS 1 THRU 47 AND
 PRESERVATION PARCEL A
 FIFTH ELECTION DISTRICT
 HOWARD COUNTY, MARYLAND
 PLAT NO. 15703

RECEIVED

FISHER, COLLINS & CARTER, INC.
 CIVIL ENGINEERING CONSULTANTS & LAND SURVEYORS
 CENTENNIAL SQUARE OFFICE PARK - 10272 BALTIMORE NATIONAL PIKE
 ELLICOTT CITY, MARYLAND 21042
 (410) 461 - 2855

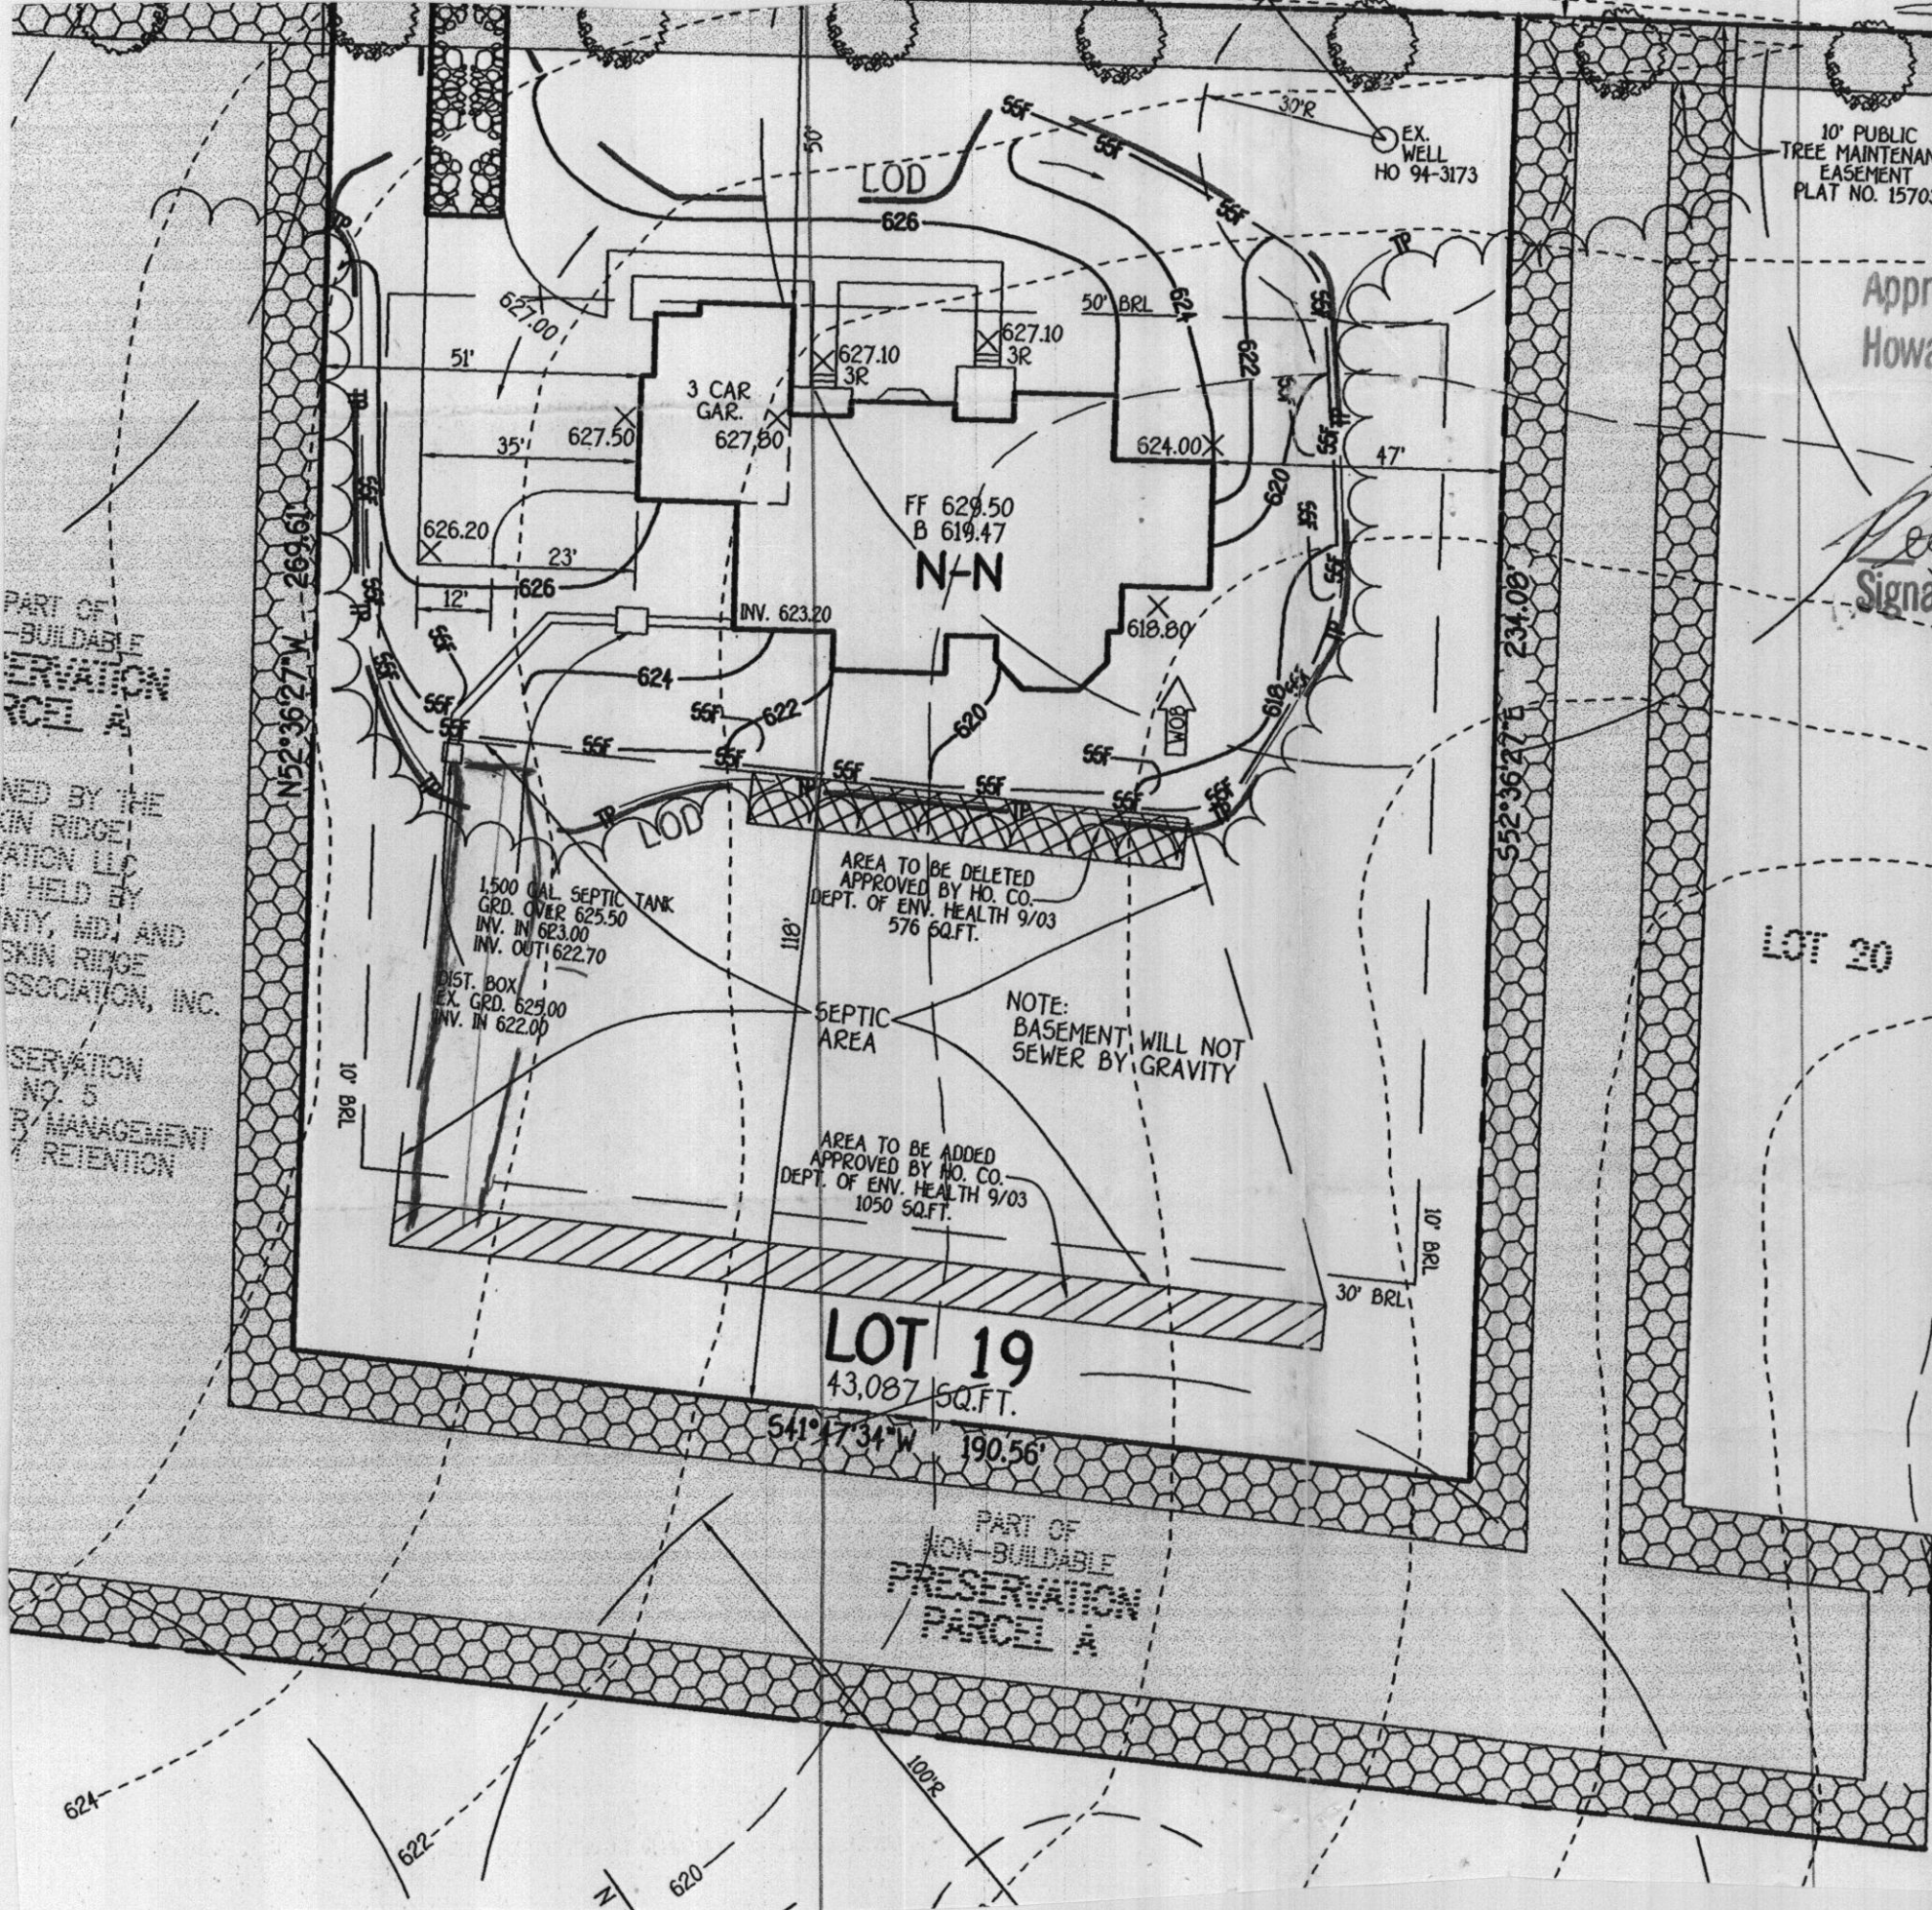


Approved Septic System Plan
 Howard County Health Department

Ken Paul
 Signature Date 2/6/05

AREA TO BE DELETED
 APPROVED BY HO. CO.
 DEPT. OF ENV. HEALTH 9/03
 576 SQ.FT.
 SEPTIC AREA
 NOTE: BASEMENT WILL NOT SEWER BY GRAVITY
 AREA TO BE ADDED
 APPROVED BY HO. CO.
 DEPT. OF ENV. HEALTH 9/03
 1050 SQ.FT.

LOT 19
 43,087 SQ.FT.

NOTE
 THE EXISTING WELL SHOWN ON THIS PLAN, TAG NO. HO 94-3173 HAS BEEN FIELD LOCATED BY FISHER, COLLINS & CARTRE, INC., PROFESSIONAL LAND SURVEYORS AND IS ACCURATELY SHOWN.

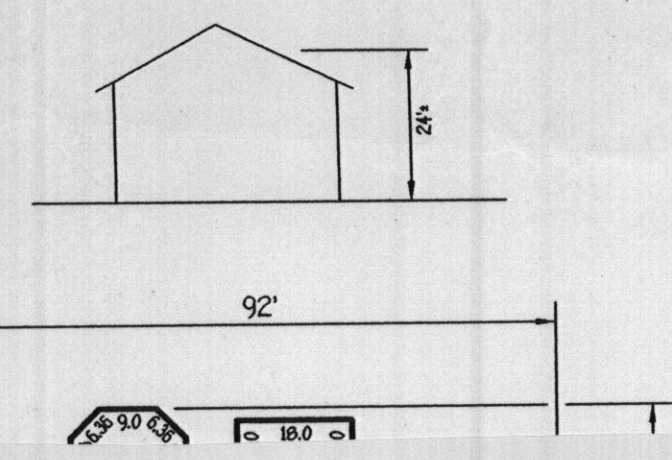

PART OF
 NON-BUILDABLE
 PRESERVATION
 PARCEL A
 OWNED BY THE
 SKIN RIDGE
 ASSOCIATION, INC.
 PRESERVATION
 NO. 5
 MANAGEMENT
 RETENTION