

SEPTIC SYSTEM TO BE INSTALLED
FIRST BEFORE BUILDING PERMIT
CAN BE SIGNED.

PERMIT

Approved GLK
30 MAR 79

P 28833
A 23988

SEWAGE DISPOSAL SYSTEM

MARYLAND STATE DEPARTMENT OF HEALTH*

HOWARD COUNTY

ELLICOTT CITY

DISTRICT 5th

DATE 9/11/78

9/29/78
around road

3/28/79

INDEXED

Jack Fyock IS PERMITTED TO INSTALL ALTER

ADDRESS 13775 Triadelphia Road, Glenelg, Md. PHONE 988-9270

SUBDIVISION Highland Lake ROAD Holly Loch Lane LOT 25

PROPERTY OWNER Yorkridge Federal Savings & Loan

ADDRESS

SPECIFICATIONS 4 bedrooms

SEPTIC TANK CAPACITY 1250 GALLONS

DRAIN FIELD DEPTH FEET, BOTTOM AREA SQ. FT.

DEEP TRENCH DEPTH FEET, BOTTOM AREA SQ. FT.

SEEPAGE PITS ABSORBENT SIDE-WALL AREA 160 SQ. FT. sidewall area per bedroom below inlet.

INLET PIPE 4 FT. BELOW ORIGINAL GRADE. MAXIMUM DEPTH 12 FT. BELOW ORIGINAL GRADE

EFFECTIVE DEPTH AT FT. BELOW ORIGINAL GRADE.

LOCATE DISPOSAL AREA FT. FROM LOT LINE AND FT. FROM LOT LINE AS SEEN WHEN FACING LOT FROM

Locate dry well per engineer's plat.

150 feet from road paving & 20 feet from left side

as seen from road. per final plat f.f.

OK for 100 ft trench - inspections ok

PLANS APPROVED BY D. W. Monaghan & Charles B. Streaker DATE 11/9/77

COVER NO WORK UNTIL INSPECTED AND APPROVED.

NEITHER THE HOWARD COUNTY COUNCIL NOR THE HEALTH DEPARTMENT IS RESPONSIBLE FOR THE SUCCESSFUL OPERATION OF ANY SYSTEM.

NOTE: IF TRENCH IS USED CALL FOR INSPECTION BEFORE PLACING GRAVEL IN TRENCH.

NOTE: NO DRY WELL SHALL EXCEED 15 FOOT IN DIAMETER.

NOTE: ALL PIPE FROM HOUSE TO DISPOSAL AREA MUST BE CAST IRON.

PERMIT VOID AFTER THREE YEARS.

NOTE: INSTALL STAND PIPE ON SEPTIC TANK AND DRY WELL. STAND PIPES MUST BE 6 INCHES IN DIAMETER. CAST IRON, CONCRETE OR TERRA COTTA ACCEPTED.


BLDG. PERMIT SIGNED
AND RETURNED 10/16/78
serial # 37247

A 23988

*INSTALLER IS RESPONSIBLE FOR OBTAINING FINAL APPROVAL ON THIS PERMIT.

BLDG. PERMIT SIGNED
AND RETURNED 9/15/80
Serial # 44506
Shed.

A23988

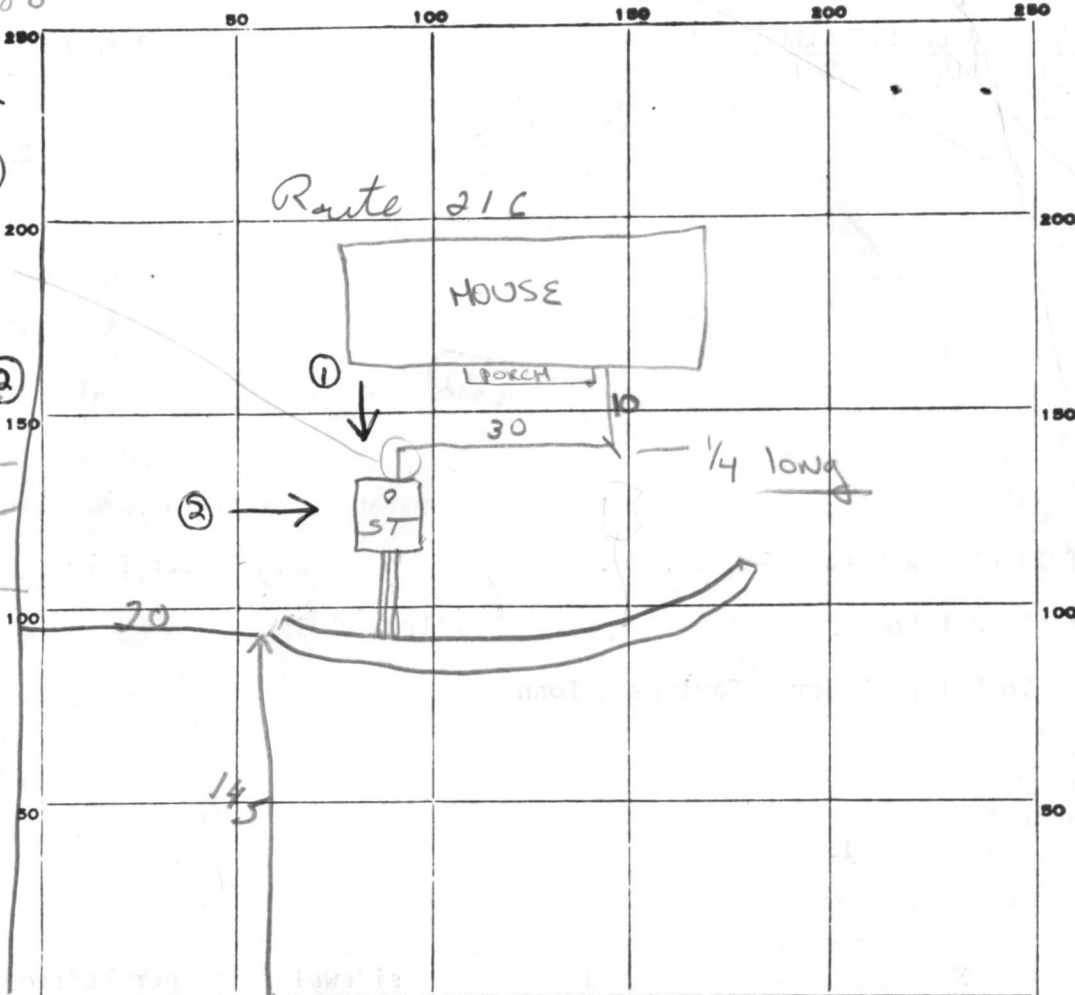

INDICATE NORTH. - NAME ADJOINING ROADWAY AS BASE LINE.

Power - Holly Park Lane

PERMIT CARD 216

SEPTIC TANK, LEVEL ✓ CLEANOUTS ST terracotta

DISTRIBUTION BOX, LEVEL Na

TILE FIELD, DEPTH 12' FT. TRENCH WIDTH _____ FT.

GRAVEL DEPTH 8' IN. TOTAL LENGTH 100+ FT.

NUMBER OF TRENCHES _____ TOTAL BOTTOM AREA 1/2 SW ± 800

SEEPAGE PITS, INSIDE DIAMETER _____ FT. DEPTH BELOW INLET _____ FT.

ABSORBENT AREA ± 800 SQ. FT.

REMARKS 9/28/78 OK to put gravel in trench & cover

9/29/78 - OK to cover trench & septic. Call for final when house connected. JF

1/4/79 - cannot tell if house connection is made - ground frozen trench partly covered JF

DATE SYSTEM APPROVED 30 MAR 79 INSPECTOR J. Keller