

9/9/70  
As soon as possible

9/9/70 approved for

# PERMIT

SEWAGE DISPOSAL SYSTEM

MARYLAND STATE DEPARTMENT OF HEALTH

HOWARD COUNTY

P 15482

A 15228

ELLICOTT CITY

DISTRICT 3

DATE 8/19/70

**INDEXED**

Garnett Y. Clark, Jr. IS PERMITTED TO INSTALL  ALTER

ADDRESS 8174 Baltimore National Pike, Ellicott City PHONE 465-6688

A SEWAGE DISPOSAL SYSTEM LOCATED AT \_\_\_\_\_

SUBDIVISION \_\_\_\_\_ ROAD Homewood (see application for better directions)

PROPERTY OWNER same as above

ADDRESS \_\_\_\_\_

SPECIFICATIONS - 4 bedrooms

DRAIN FIELD \_\_\_\_\_ DEPTH \_\_\_\_\_ FEET, BOTTOM AREA \_\_\_\_\_ SQ. FT.

SEEPAGE PITS \_\_\_\_\_ ABSORBENT SIDE-WALL AREA \_\_\_\_\_ SQ. FT.

SEPTIC TANK CAPACITY 1,200 GALLONS

FOR GARBAGE GRINDER, INCREASE DISPOSAL AREA 22% & TANK CAPACITY 50%.

OTHER Dry well to be 400 sq. ft. of absorbent sidewall area below the inlet pipe.

Maximum depth of dry well to be 12 ft. below original grade. Inlet pipe to begin 4 ft.

below original grade. Locate system in original perc holes 2 x 4 x will be in original percolation holes.

NOTE: ALL PIPE FROM HOUSE TO SEPTIC TANK MUST BE CAST IRON.  
PERMIT VOID AFTER THREE YEARS.

PLANS APPROVED BY James T. Wright DATE 5/13/70

FILL SEPTIC TANK AND DISTRIBUTION BOX WITH WATER BEFORE CALLING FOR AN INSPECTION. COVER NO WORK UNTIL INSPECTED AND APPROVED.


NEITHER THE HOWARD COUNTY COMMISSIONERS NOR THE HEALTH DEPARTMENT IS RESPONSIBLE FOR THE SUCCESSFUL OPERATION OF ANY SYSTEM.

A 15228

DATE SYSTEM APPROVED \_\_\_\_\_

11/10/90

$$\begin{array}{r} 13 \\ 54 \\ \hline 67 \\ 115 \\ \hline 260 \\ 541 \\ \hline 801 \\ 59 \\ \hline 860 \end{array}$$

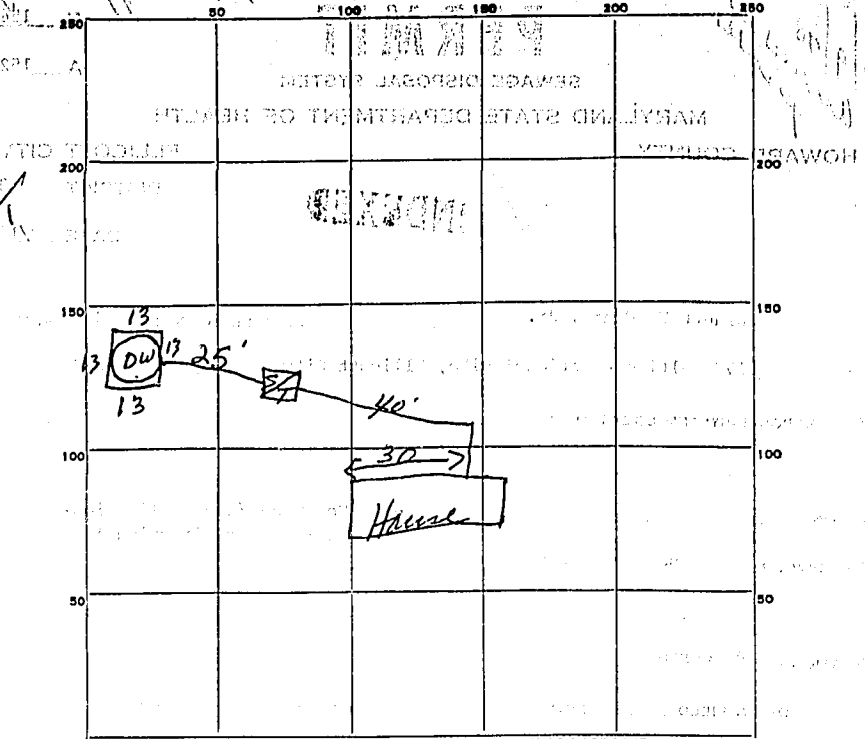

PERMIT CARD OK  
 SEPTIC TANK, LEVEL Cement 1200 CLEANOUTS OK  
 DISTRIBUTION BOX, LEVEL \_\_\_\_\_  
 TILE FIELD, DEPTH \_\_\_\_\_ FT. TRENCH WIDTH \_\_\_\_\_ FT.  
 GRAVEL DEPTH \_\_\_\_\_ IN. TOTAL LENGTH \_\_\_\_\_ FT.  
 NUMBER OF TRENCHES \_\_\_\_\_ TOTAL BOTTOM AREA \_\_\_\_\_  
 SEEPAGE PITS, INSIDE DIAMETER 9 FT. DEPTH BELOW INLET 1 1/2 FT.  
 ABSORBENT AREA 598 SQ. FT.

REMARKS \_\_\_\_\_

\_\_\_\_\_

\_\_\_\_\_

\_\_\_\_\_

DATE SYSTEM APPROVED 9/9/90 INSPECTOR Jim Wright

