

APPLICATION

SEWAGE DISPOSAL TESTING

STATE OF MARYLAND - DEPARTMENT OF HEALTH AND MENTAL HYGIENE

HOWARD COUNTY HEALTH DEPARTMENT
ENVIRONMENTAL HEALTH SERVICES

P. O. BOX 476 ELLICOTT CITY, MARYLAND 21043
TELEPHONE: 992-2330

A 35519

P _____

DISTRICT 4TH

DATE May 3, 1985

TO: THE COUNTY HEALTH OFFICER
ELLICOTT CITY, MARYLAND

I HEREBY APPLY FOR THE NECESSARY TEST IN ORDER TO CONSTRUCT (OR RECONSTRUCT) A SEWAGE DISPOSAL SYSTEM.

PROPERTY OWNER Richard M. Hough

ADDRESS 17591 Route 144 PHONE 489-4014

PROPERTY LOCATION: Country View

SUBDIVISION Hough Property LOT NO. 2

ROAD AND DESCRIPTION On Maryland Route 144, 600'± East of Long Corner Rd.

SIZE OF LOT 3 Acres + TYPE BLDG. 4 Bedroom
(NUMBER OF BEDROOMS)

THE SYSTEM INSTALLED UNDER THIS APPLICATION IS ACCEPTABLE ONLY UNTIL PUBLIC FACILITIES BECOME AVAILABLE. I FULLY UNDERSTAND THE FEE CONNECTED WITH THE FILING OF THIS PERC TEST APPLICATION IS NON-REFUNDABLE UNDER ANY CIRCUMSTANCES. I ALSO AGREE TO COMPLY

WITH ALL M.O.S.H.A. REQUIREMENTS IN TESTING THIS LOT. Dennis M. Rusli
(SIGNATURE OF APPLICANT)

APPROVED BY _____ FOR _____ DATE _____

REJECTED BY _____ FOR _____ DATE _____

HOLD PENDING FURTHER TESTS _____ DATE _____

REASONS FOR REJECTION OR HOLDING _____

THIS IS NOT A PERMIT

SOIL PROFILE (2)

BROWN CLAY

LIGHT BROWN SAND LOAM & SOME SPROUTS


(3) CLAY

BEIGE SAND LOAM

(4) BROWN CLAY

LIGHT BROWN SANDY SPROUTS

(2)

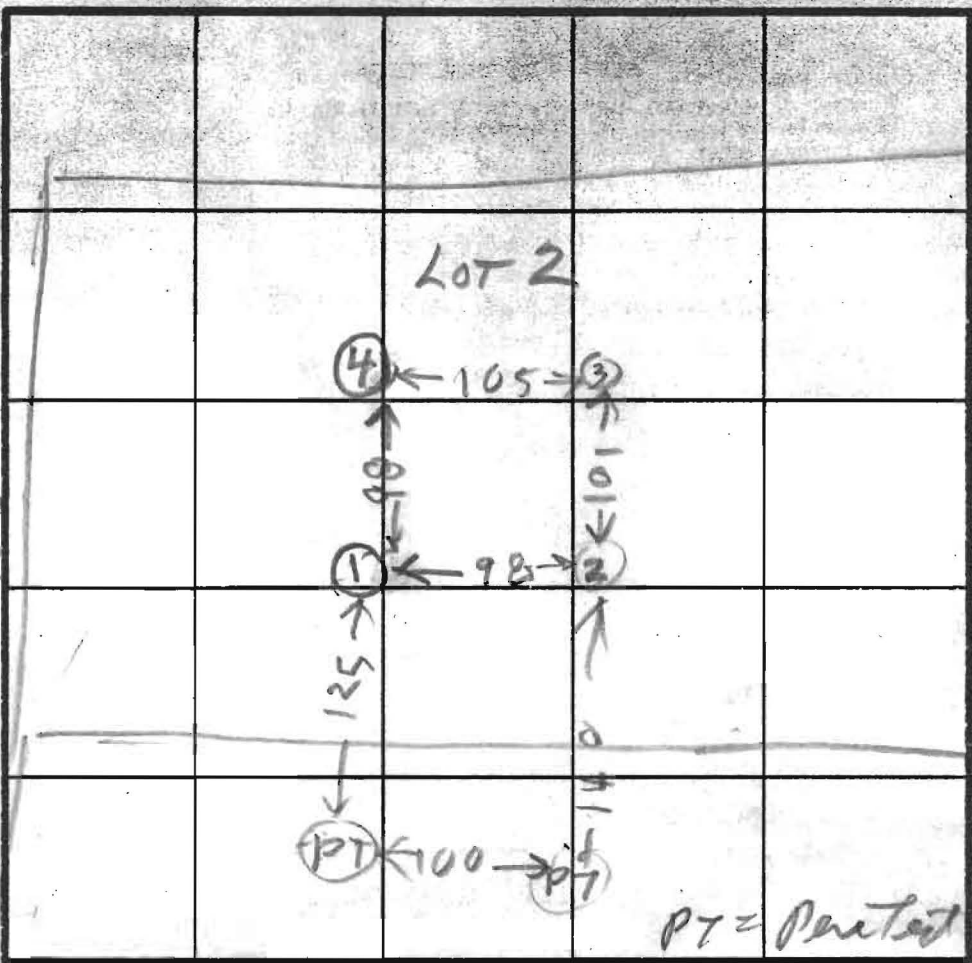

HOLE ELEVATIONS

(3)(4) = HIGH

(1)(2) = LOW

4-10-86
see location map

PT = Point on Lot 1

INDICATE NORTH - NAME ADJOINING ROADWAY AS BASE LINE.

DATE	TEST NO.	DEPTH	PRE-WET		TEST - 1" DROP		TIME
			START	STOP	START	STOP	
7/17/85	1 S	5.5	249	251	251	254	3
	1 V	12.5	LOOKS OK		OK		
	2 S	6.5	259	313	313	343	20
	2 V	12.5	LOOKS OK		OK		
	3 S	5	306	314	314	320	16
	3 V	12	LOOKS OK		OK		
	4 V	12	LOOKS OK		OK		

X 12 MIN
INLET 5'

REMARKS HOLES NOT DUG PER SURVEYOR PLAT
TYPE OF SOIL B HODGES SKIP & DIM OF FLOCK CO

APPLICATION

SEWAGE DISPOSAL TESTING

STATE OF MARYLAND - DEPARTMENT OF HEALTH AND MENTAL HYGIENE

A 35579
P _____

HOWARD COUNTY HEALTH DEPARTMENT
ENVIRONMENTAL HEALTH SERVICES

P. O. BOX 476 ELLICOTT CITY, MARYLAND 21043
TELEPHONE: 992-2330

DISTRICT 4TH
DATE May 3, 1985

TO: THE COUNTY HEALTH OFFICER
ELLICOTT CITY, MARYLAND

I, HEREBY, APPLY FOR THE NECESSARY TEST IN ORDER TO CONSTRUCT (OR RECONSTRUCT) A SEWAGE DISPOSAL SYSTEM.

PROPERTY OWNER ~~Richard M. Hough~~ BRIAN STALEY

ADDRESS 17591 Route 144 PHONE 489-4014

PROPERTY LOCATION: COUNTRY VIEW
SUBDIVISION ~~Hough Property~~ LOT NO. 2

ROAD AND DESCRIPTION On Maryland Route 144, 600'± East of Long Corner Rd.
17508 COUNTRY View Way

SIZE OF LOT 3 Acres + TYPE BLDG. 4 Bedroom
(NUMBER OF BEDROOMS)

THE SYSTEM INSTALLED UNDER THIS APPLICATION IS ACCEPTABLE ONLY UNTIL PUBLIC FACILITIES BECOME AVAILABLE. I FULLY UNDERSTAND THE FEE CONNECTED WITH THE FILING OF THIS PERC TEST APPLICATION IS NON-REFUNDABLE UNDER ANY CIRCUMSTANCES. I ALSO AGREE TO COMPLY

WITH ALL M.O.S.H.A. REQUIREMENTS IN TESTING THIS LOT. Daphis M. Rusli
(SIGNATURE OF APPLICANT)

APPROVED BY Raymond Hodge FOR Trenches DATE 9/14/87

REJECTED BY _____ FOR _____ DATE _____

HOLD PENDING FURTHER TESTS _____ DATE _____

REASONS FOR REJECTION OR HOLDING 7/17/85 PERC OK HOLD FOR PHAT R/H
9/14/87 Specs Violated R/H

BLDG. PERMIT SIGNED
AND RETURNED 11-5-87

B.P. 15461
Staley

THIS IS NOT A PERMIT

