

file
7/1/75

PERMIT

SEWAGE DISPOSAL SYSTEM

MARYLAND STATE DEPARTMENT OF HEALTH

HOWARD COUNTY

ELLICOTT CITY

DISTRICT 3rd

DATE 7/1/75

P 21752

A 19681

Indeped

Jack Fyock IS PERMITTED TO INSTALL ALTER

ADDRESS Ten Oaks Road, Glenelg, Maryland PHONE 286-2939

A SEWAGE DISPOSAL SYSTEM LOCATED AT _____

SUBDIVISION _____ ROAD 1669 Henryton Road LOT Parcel 3

PROPERTY OWNER Lee-Stirn Paul + SuAnne Ressler

ADDRESS 11186 Route 99, Marriottsville, Md.

SPECIFICATIONS 3 bedrooms

DRAIN FIELD _____ DEPTH _____ FEET, BOTTOM AREA _____ SQ. FT.

SEEPAGE PITS _____ ABSORBENT SIDE-WALL AREA _____ SQ. FT.

SEPTIC TANK CAPACITY 1000 GALLONS

FOR GARBAGE GRINDER, INCREASE DISPOSAL AREA 22% & TANK CAPACITY 30%.

OTHER TRENCH - 500 sq. ft. trench - one side - Maximum depth 10 ft. Inlet to be 3 ft. below original grade. Locate 150 ft. from back property line and 10 ft. from left property line as seen when facing lot from right-of-way. Septic tank must have manhole type cleanout to grade level. Call for inspection of trench before gravel is installed.

DISPOSAL AREA

NOTE: ALL PIPE FROM HOUSE TO BRIDGE MUST BE CAST IRON.

PERMIT VOID AFTER THREE YEARS.

NOTE: INSTALL STAND PIPE ON SEPTIC TANK. STAND PIPES MUST BE 6 INCHES IN DIAMETER.

CAST IRON, CONCRETE OR TERRA COTTA ACCEPTED.

PLANS APPROVED BY Harry Jay Zbar & D. W. Monaghan DATE 4/9/75 & 7/1/75


FILL SEPTIC TANK AND DISTRIBUTION BOX WITH WATER BEFORE CALLING FOR AN INSPECTION. COVER NO WORK UNTIL INSPECTED AND APPROVED.

NEITHER THE HOWARD COUNTY COMMISSIONERS NOR THE HEALTH DEPARTMENT IS RESPONSIBLE FOR THE SUCCESSFUL OPERATION OF ANY SYSTEM.

BMOG. PERMIT SIGNED
AND RETURNED 4/20/75

Serial # 27372
WAM

A 19681

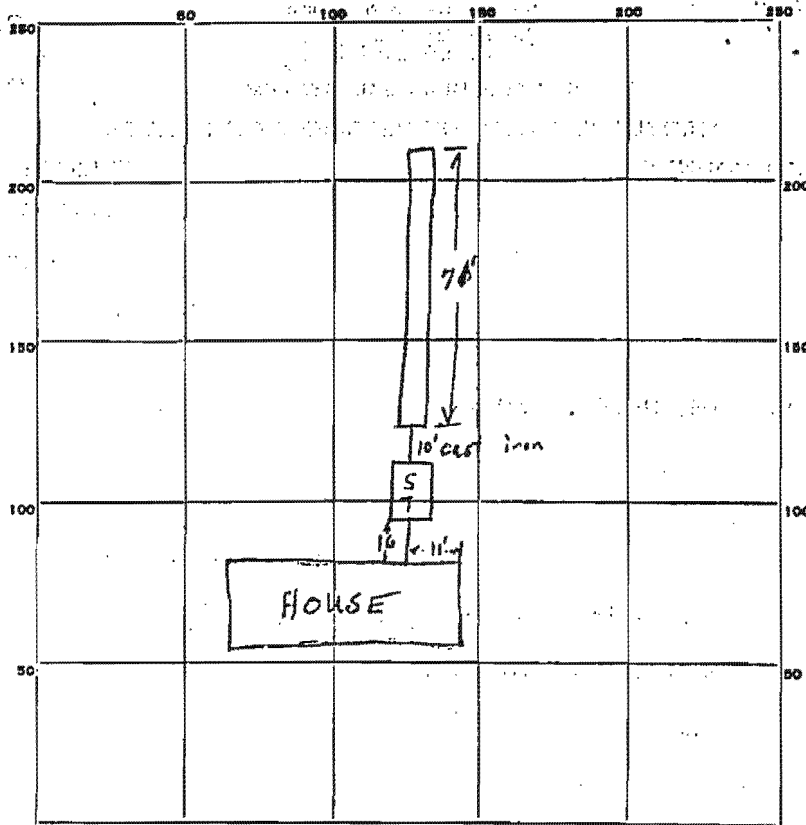

INDICATE NORTH. - NAME ADJOINING ROADWAY AS BASE LINE.

PERMIT CARD

SEPTIC TANK, LEVEL 1000 gal

CLEANOUTS 6" ceramic cotta; ≤ 3' fill on tank

DISTRIBUTION BOX, LEVEL _____

TILE FIELD, DEPTH _____ FT. TRENCH WIDTH 3 FT.

GRAVEL DEPTH 7 FT. TOTAL LENGTH 71 FT.

NUMBER OF TRENCHES 1 TOTAL SIDEWALL BOTTOM AREA 497 OK

SEEPAGE PITS, INSIDE DIAMETER _____ FT. DEPTH BELOW INLET _____ FT.

ABSORBENT AREA _____ SQ. FT.

REMARKS 7/2/75 Location not as specified, Trench is down slope,
but much closer to house than originally called for.
Soil is good, and should have adequate repair area.

DATE SYSTEM APPROVED 7/7/75 INSPECTOR H. H. Zapp, H. J. B.

S 70° 3'

N 26° 07' 23" E, 587.19'

82'

25' 6"

27' 4 1/2"

PARKING PAD

EXISTING HOUSE

PROPOSED ADDITION

NO impact noted
OK/SM

73m x

S 72° 01' 54" W

IRON PIPE

