


OLD

FREDERICK

ROAD

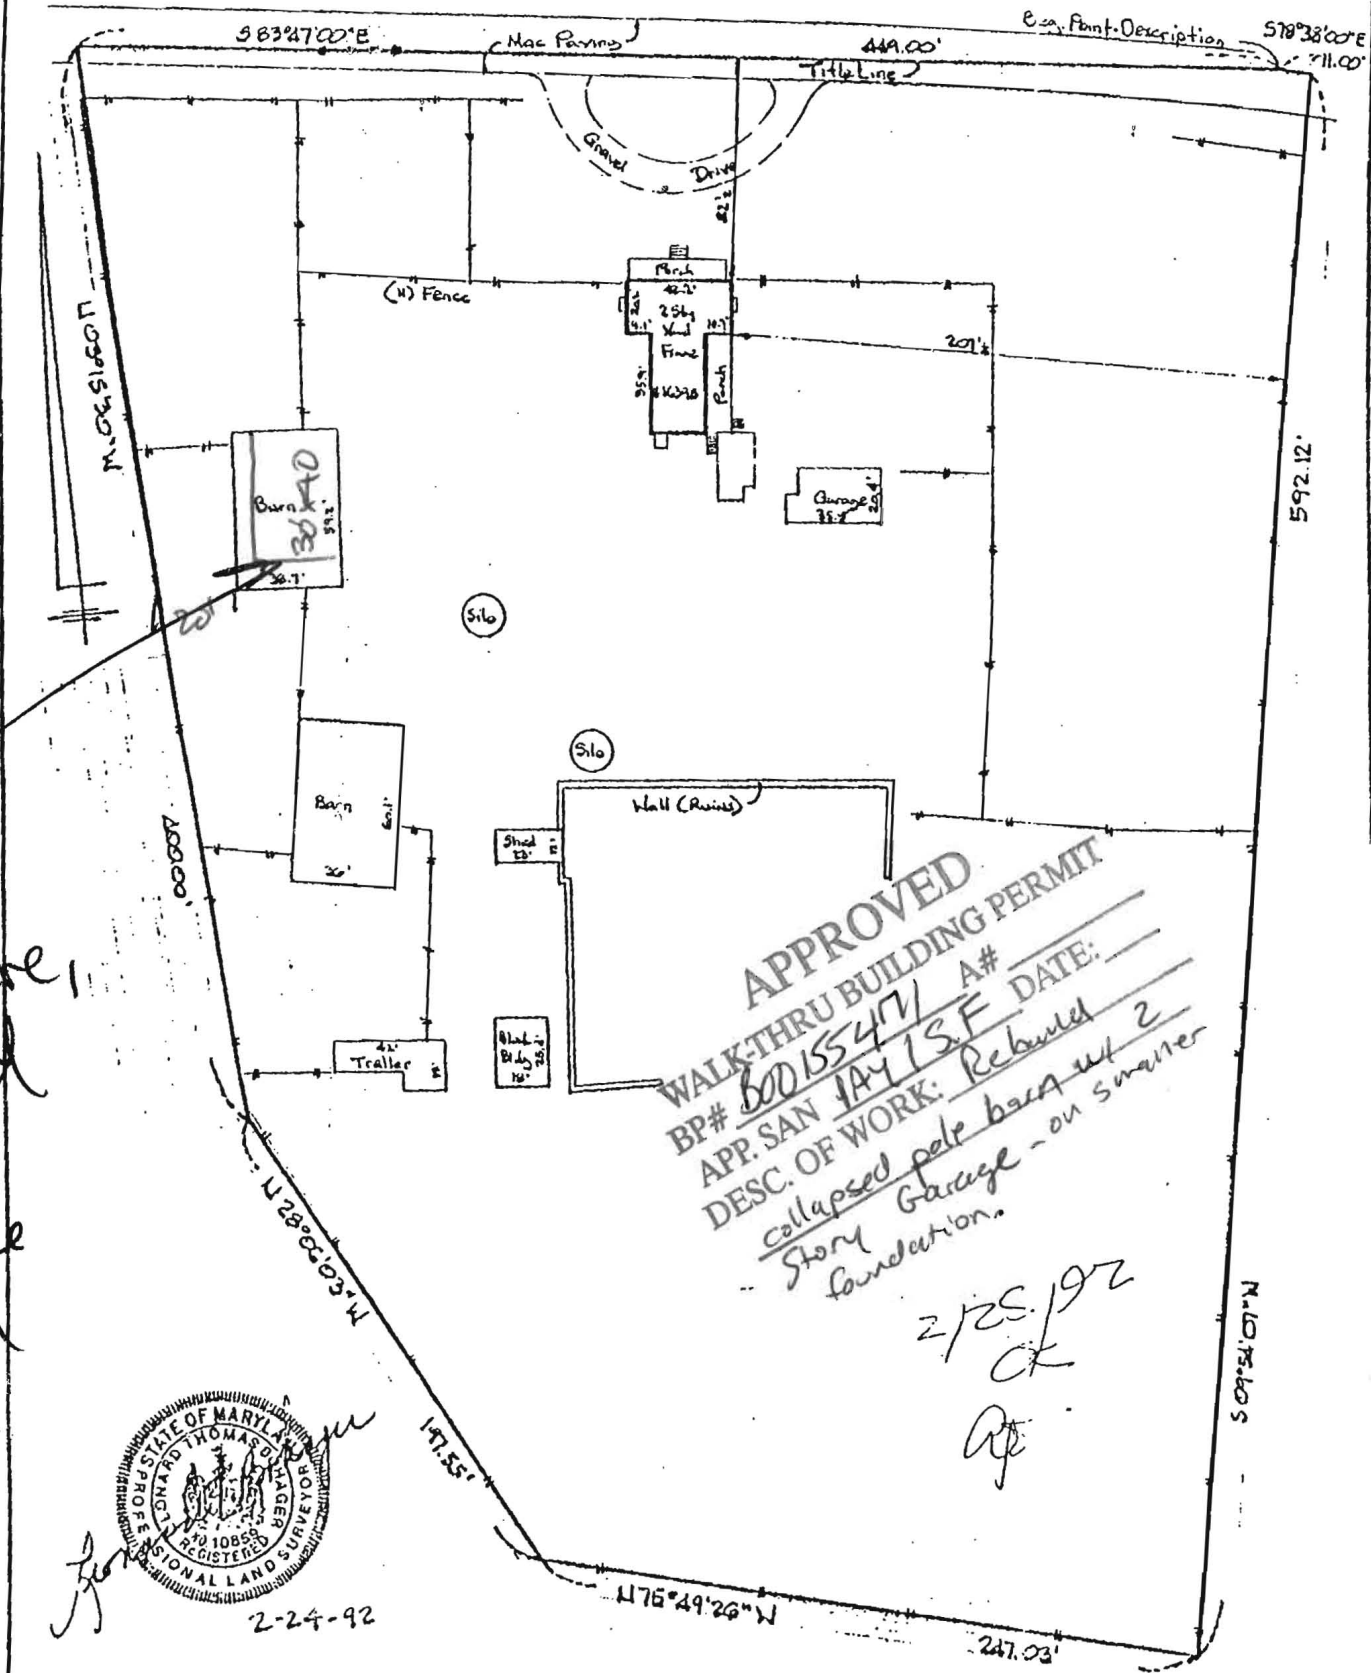

Replace  
this  
structure  
Collapsed  
2003  
Insurance  
talked

**APPROVED**  
WALK-THRU BUILDING PERMIT  
BP# 600155471 A# \_\_\_\_\_  
APP. SAN 1/14/13 F. DATE: \_\_\_\_\_  
DESC. OF WORK: Rebuild  
collapsed pole barn w/ 2  
Story Garage - on smaller  
foundation.

2/25/19  
CK  
Rt



THE LOT SHOWN HEREON IS IN FLOOD  
ZONE C PER F.E.M.A. FLOOD  
INSURANCE RATE MAP PANEL # 240011-0002-B  
THIS IS TO CERTIFY That The Improvements Indicated  
Hereon Are Located As Shown. This Is Not A Property  
Line Survey And Should Not Be Used As Such.